



46-15.

STERN FRAME. S.S. N° 470.  
FORGED STEEL OR FORGED IRON.  
SCALE 1"=1'.

SCHEEPSWERF VOORHEEN JAN SMIT CZ.  
ALBLASSERDAM  
HOLLAND.

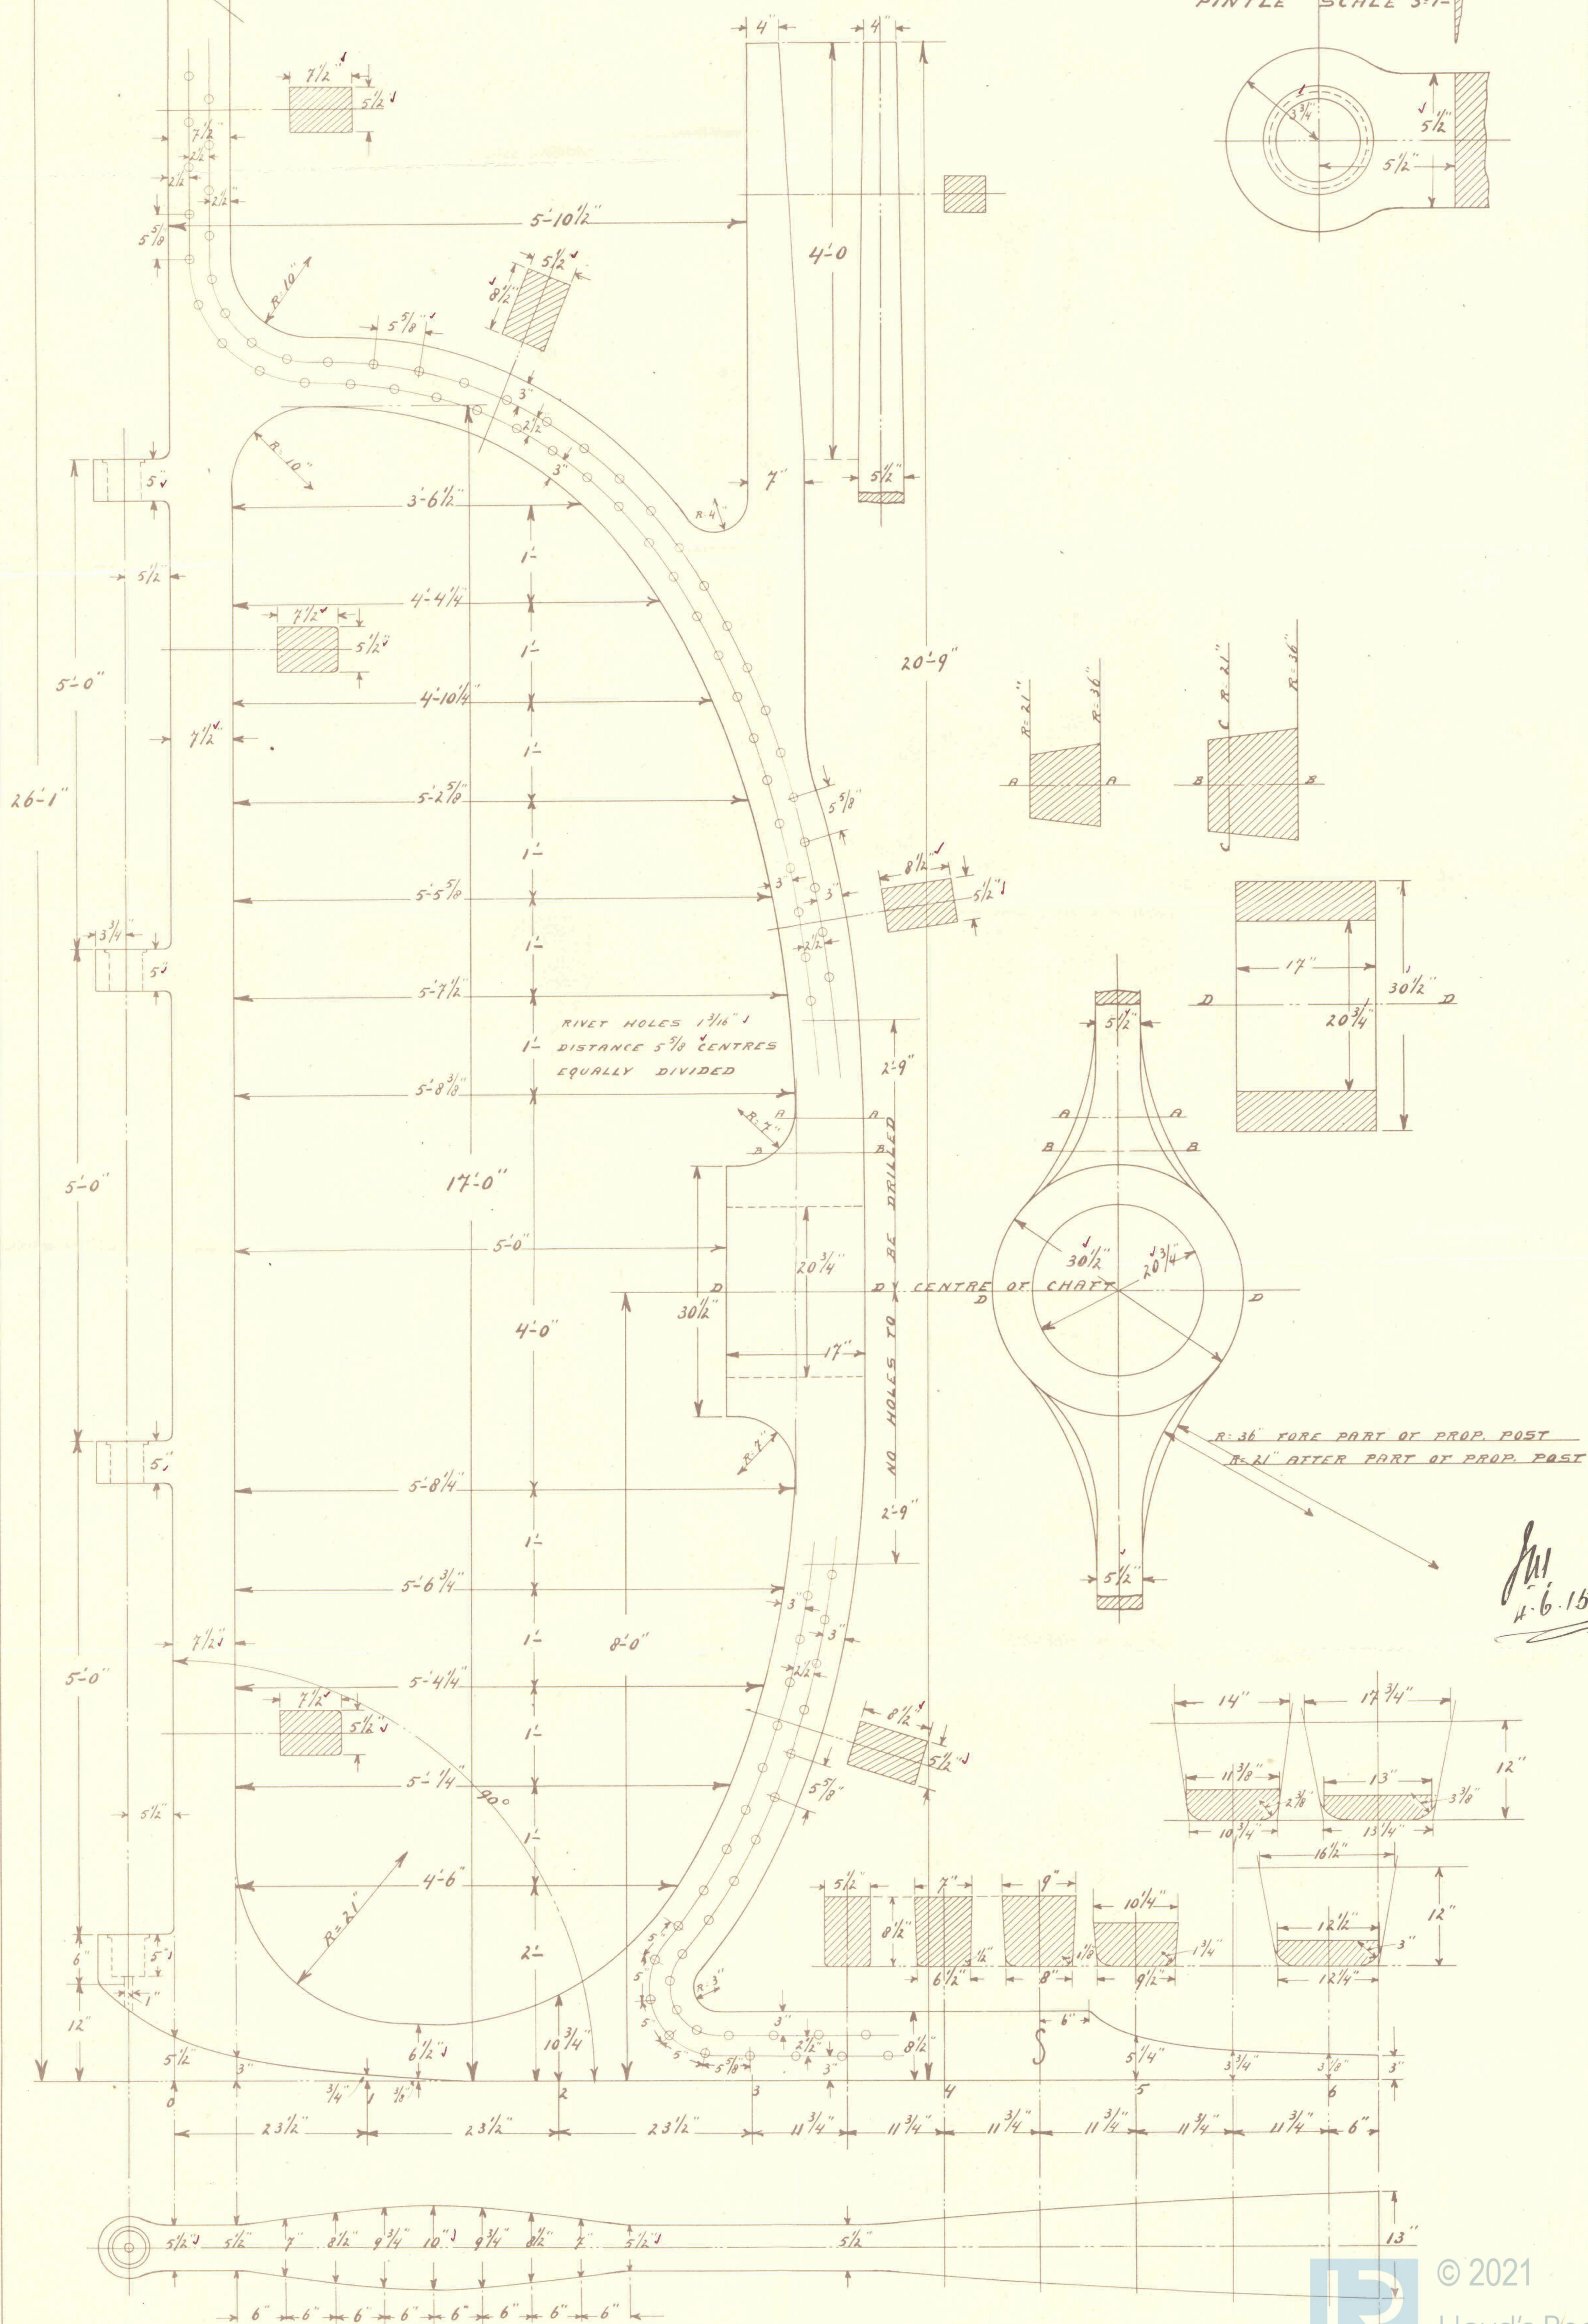

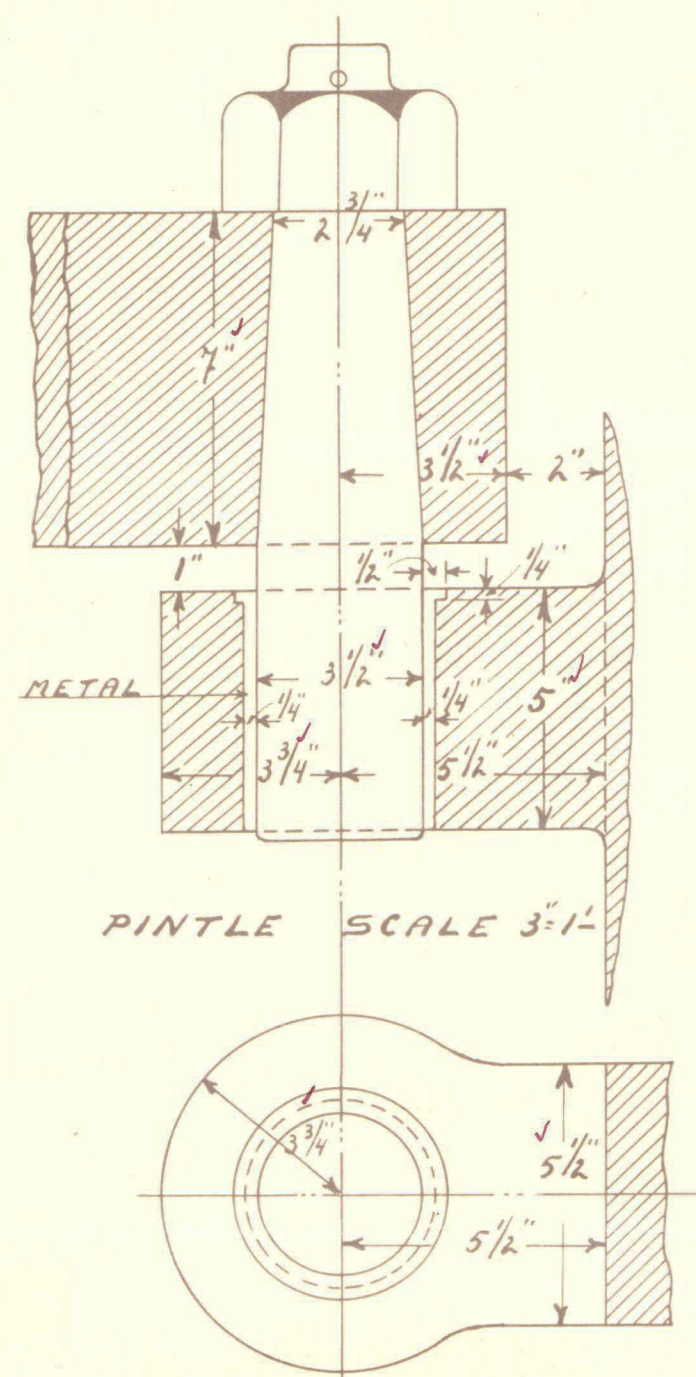

478  
Sternframe



S. S. Lind. Jansband

Rotterdam report no-10170<sup>a</sup>

Plan of Sternframe

WG6-0027



© 2021

Lloyd's Register  
Foundation