

BULKHEAD ON FRAME N° 35

RIVETING $\frac{3}{4}$ "




BULKHEAD DEEPTANK ON FR. N° 73

SCHEEPSWERF. VOORHEEN. JAN SMIT. CZ.

ALBLASSERDAM. HOLLAND.

BULKHEAD DEEPTANK ON FR. N° 79


SS N° 478
SCALE $\frac{1}{4} = 1'$

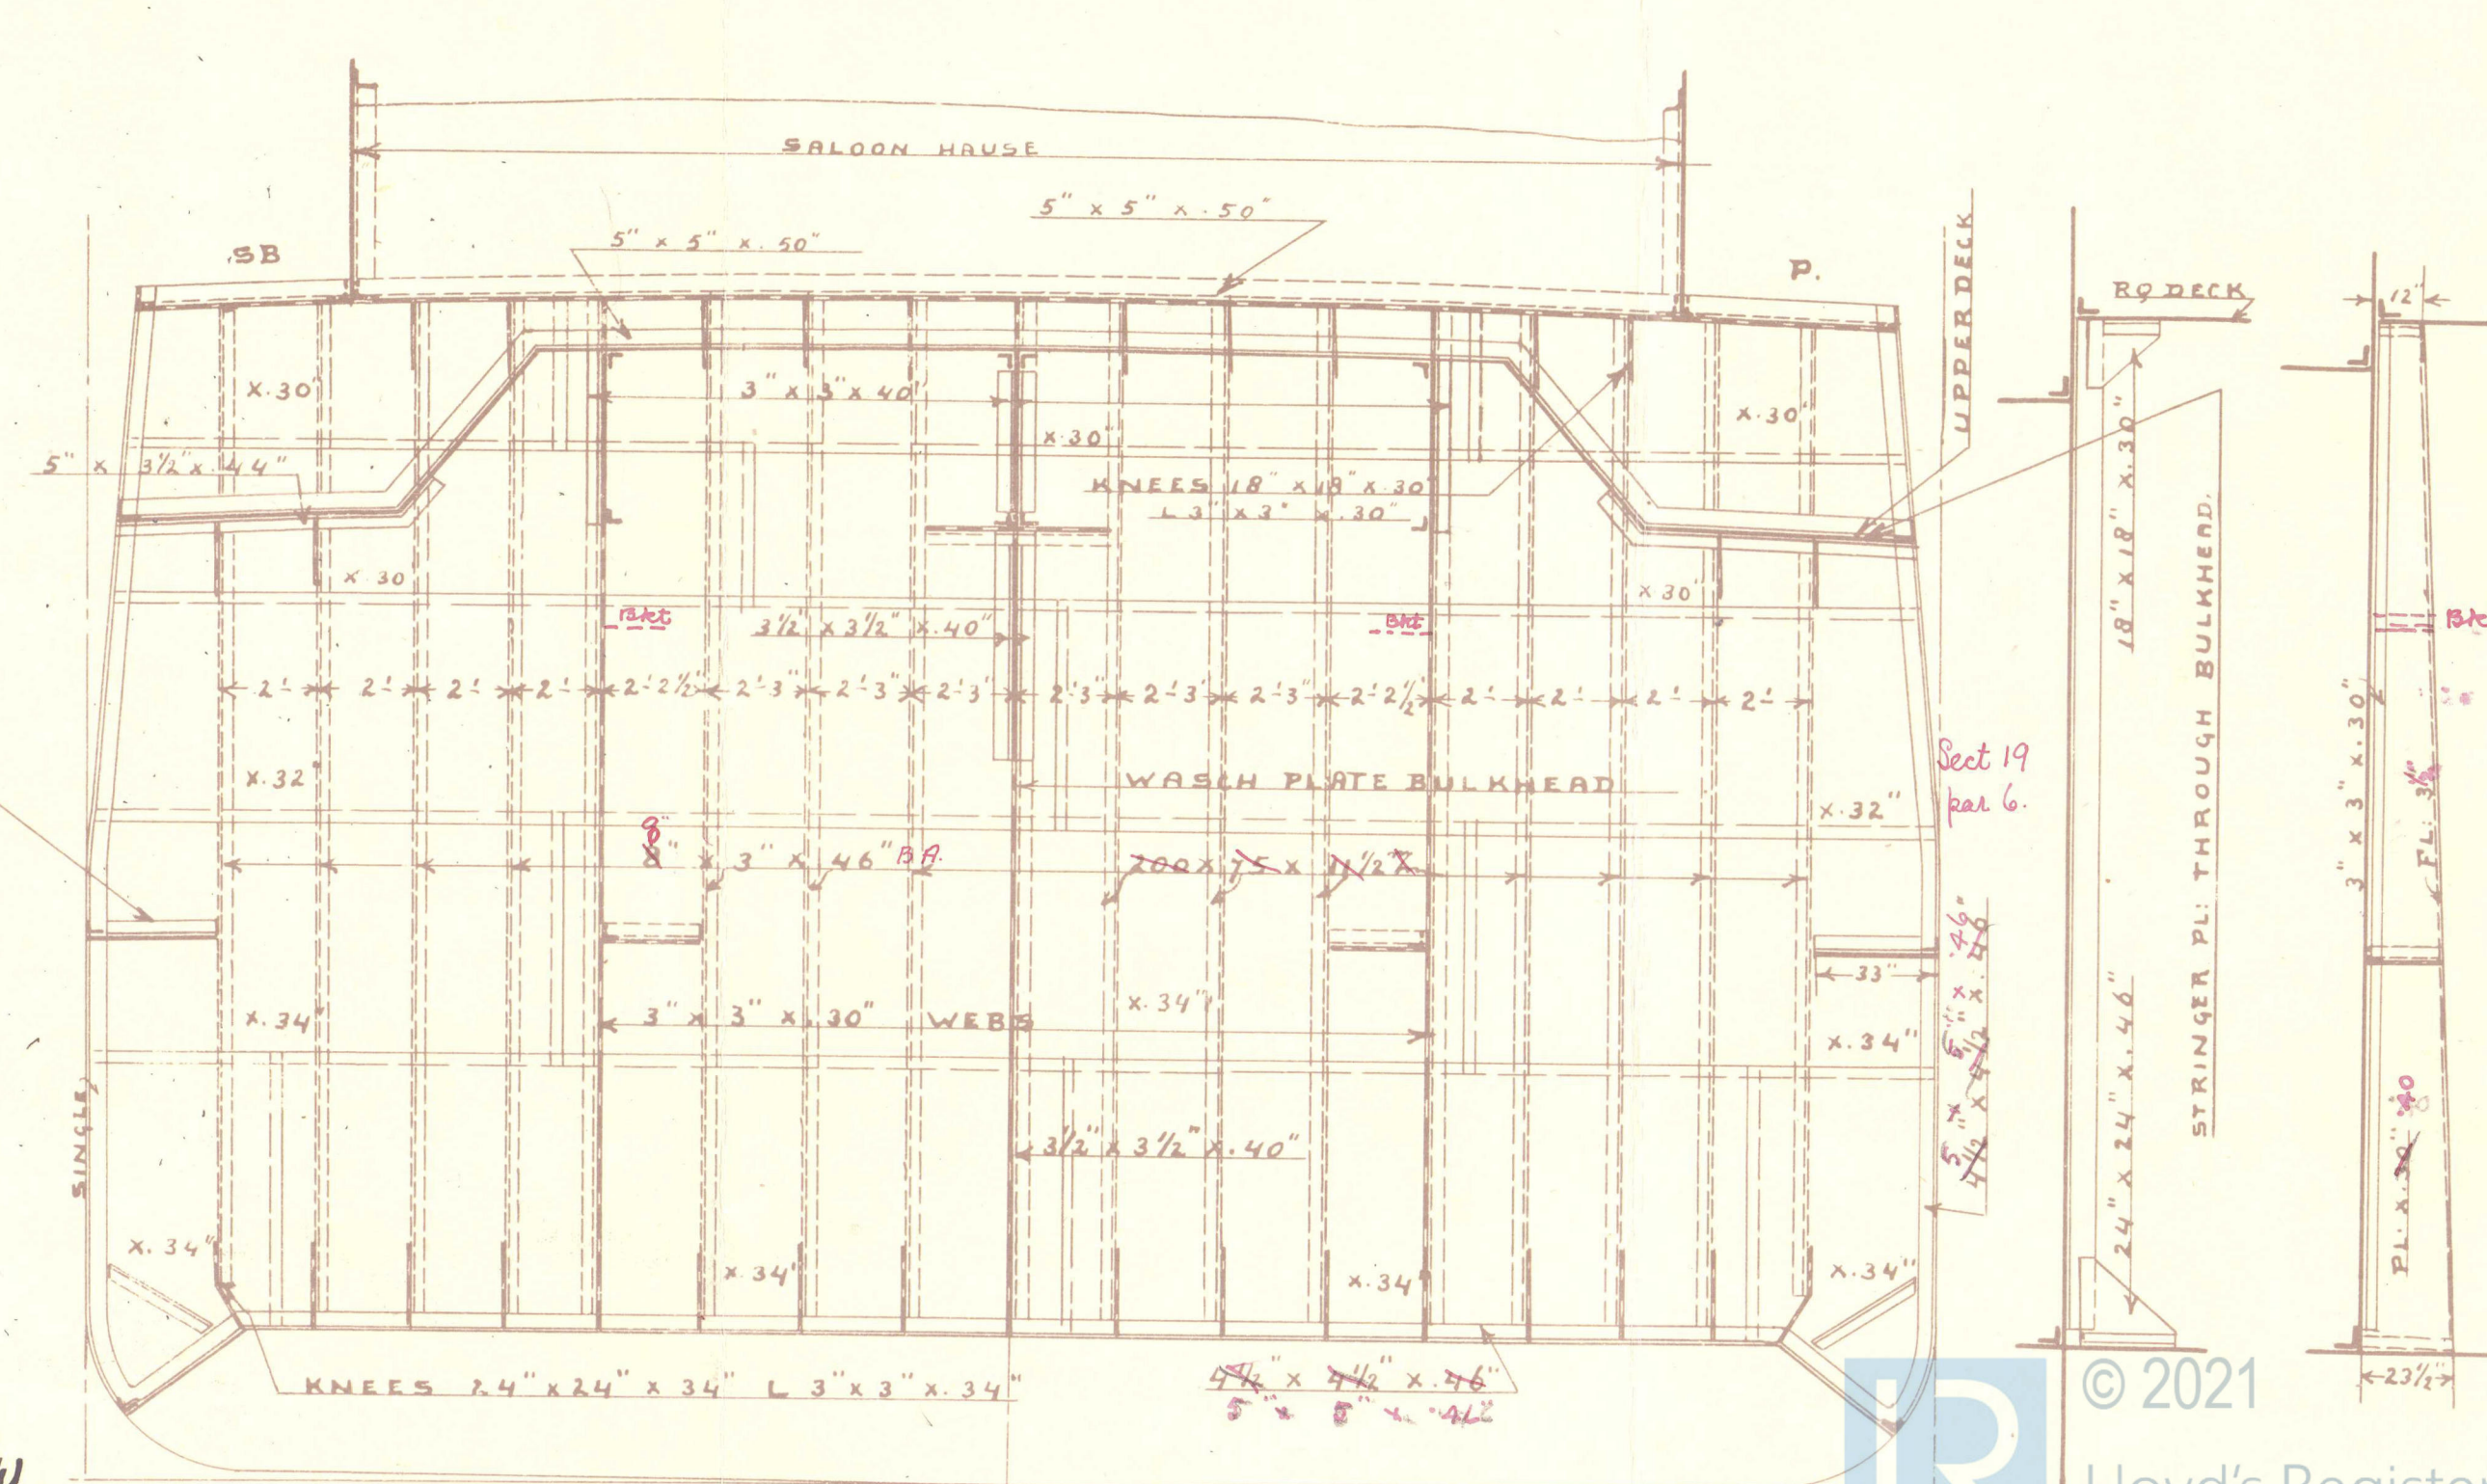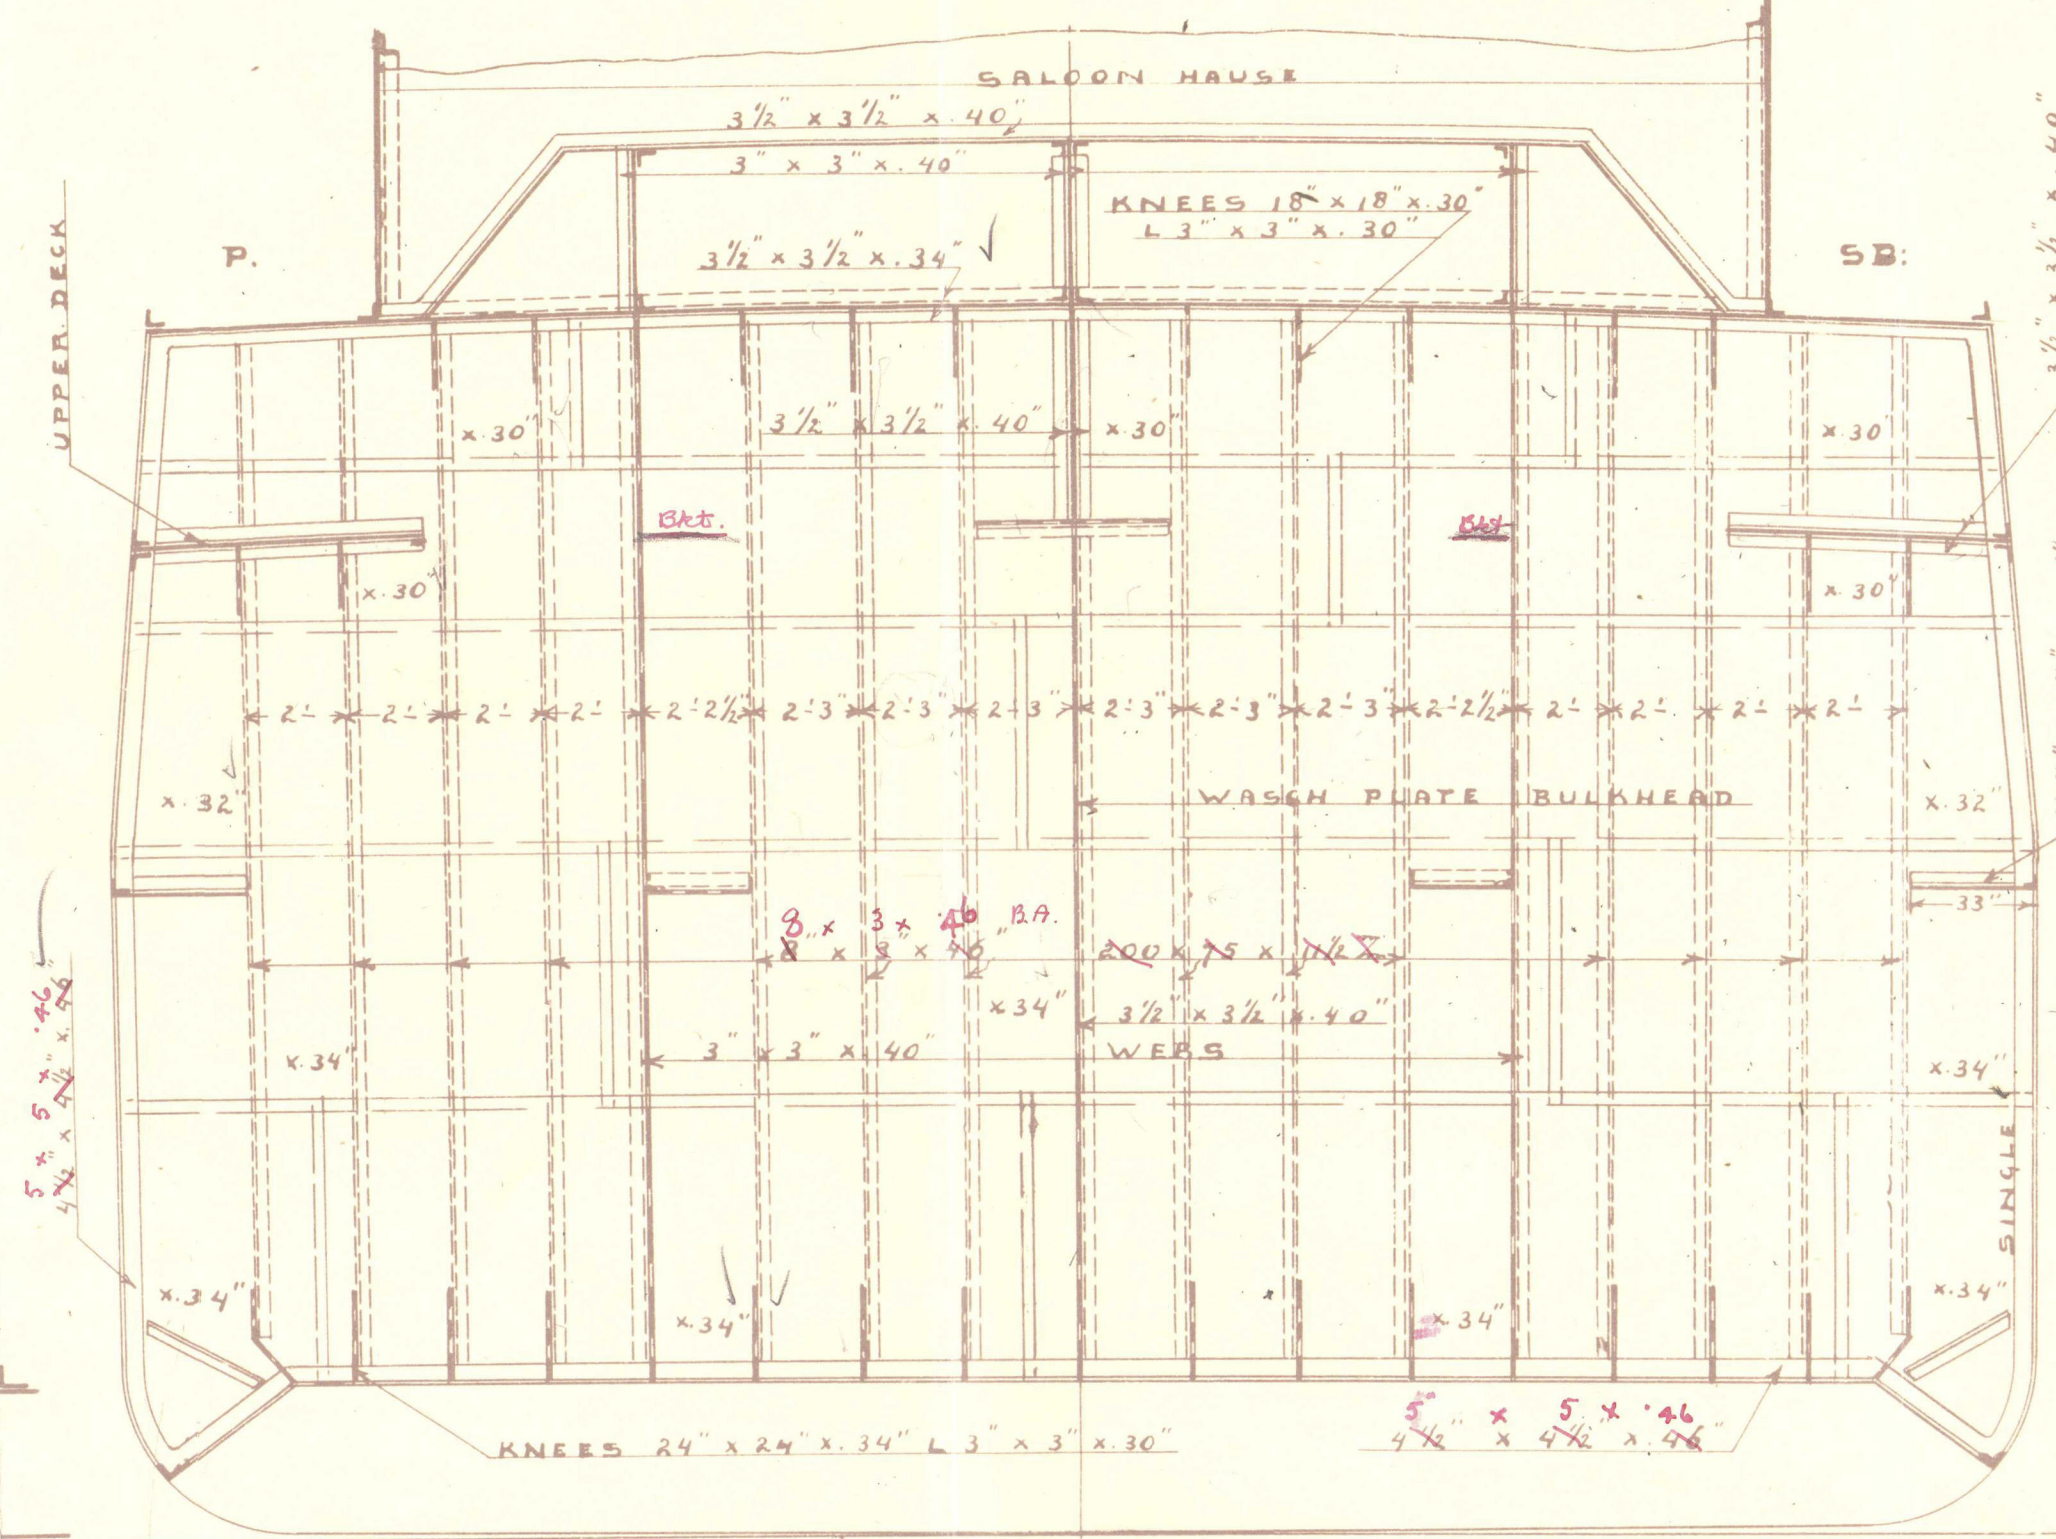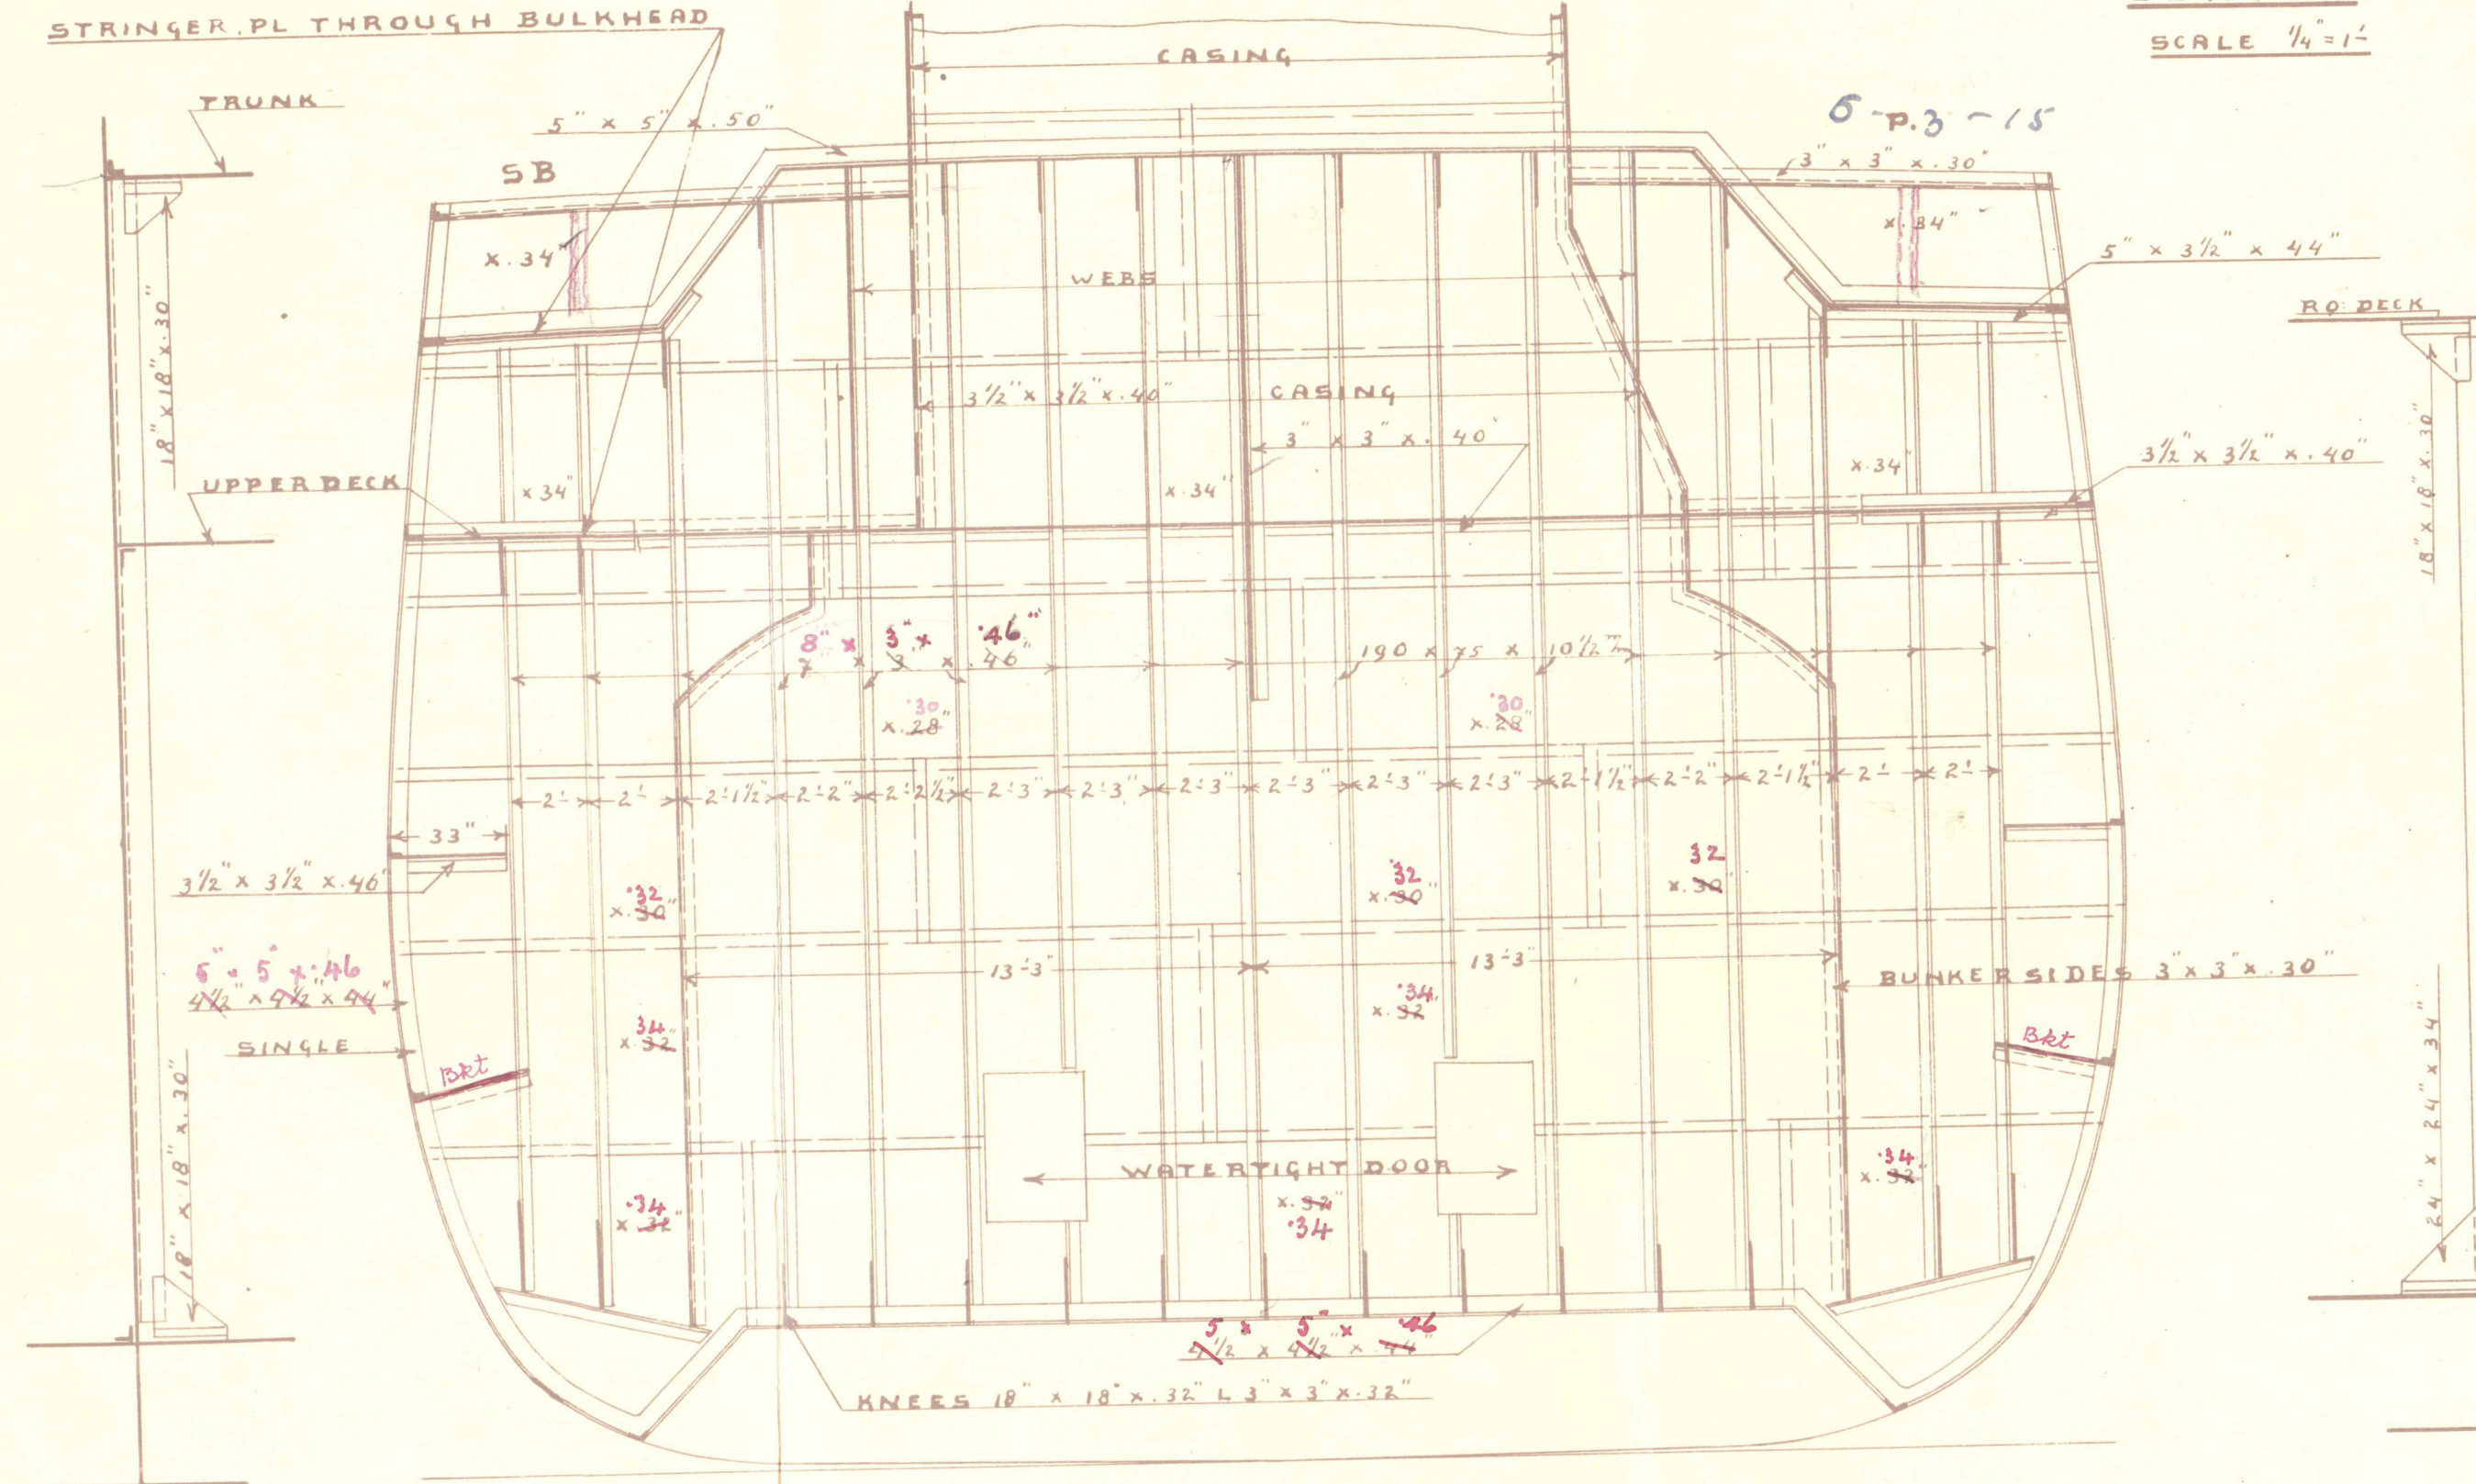

fw.
5-3-15



Bth. 478

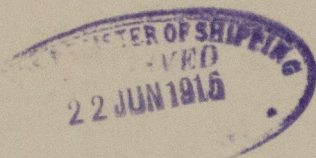

S. S. *Saint Pauland*

Bth. plans.

Rotterdam report no. 10170 ²

W66-0030



© 2021

Lloyd's Register
Foundation