



BULKHEAD ON FRAME N<sup>o</sup> 10

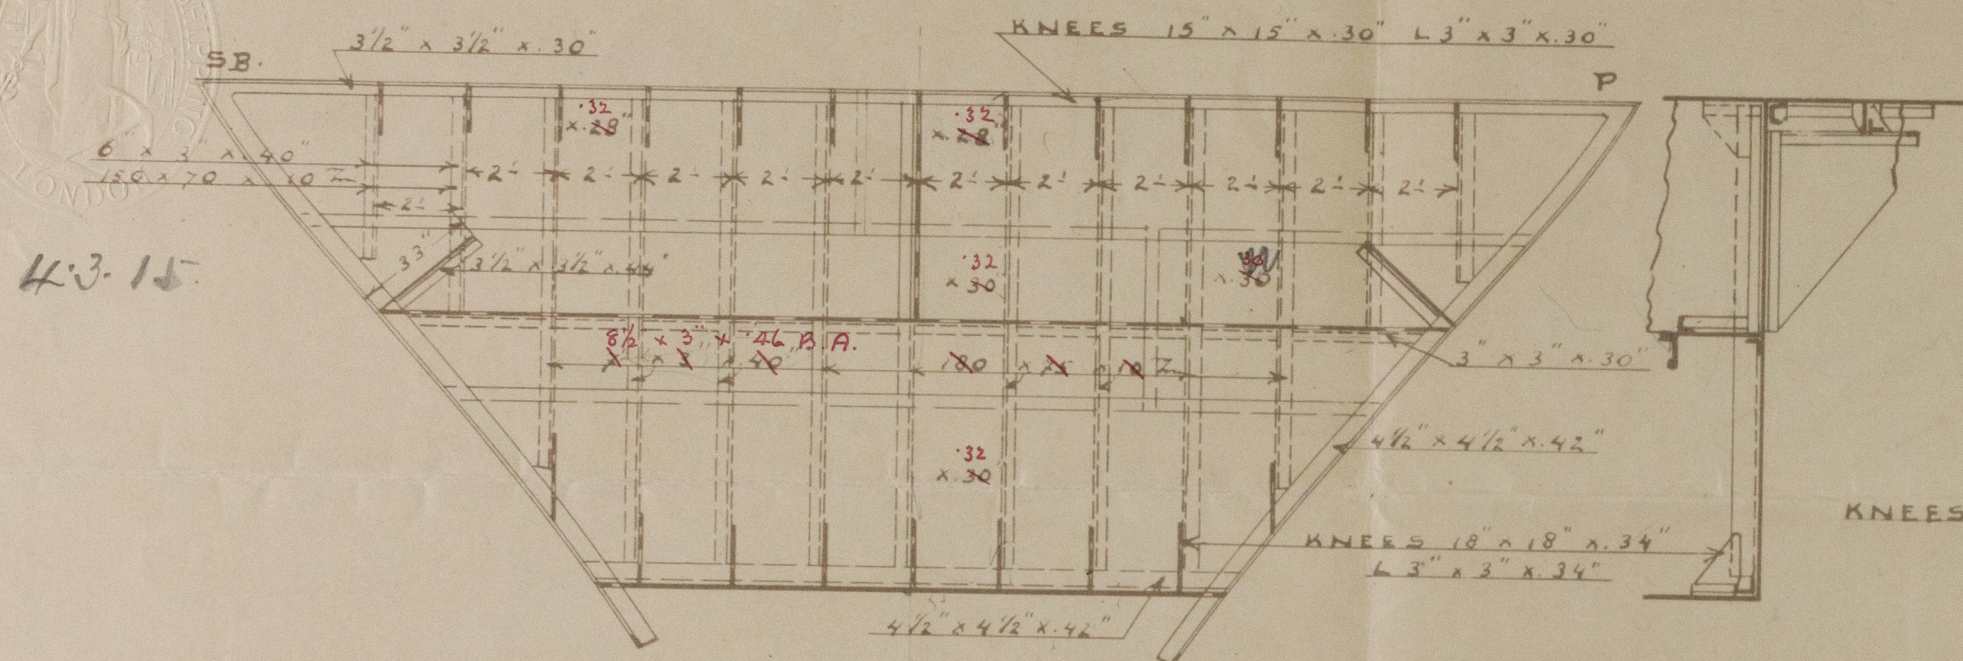

43. 15.

RIVETING  $\frac{3}{4}$ "

BULKHEAD ON FRAME No 7

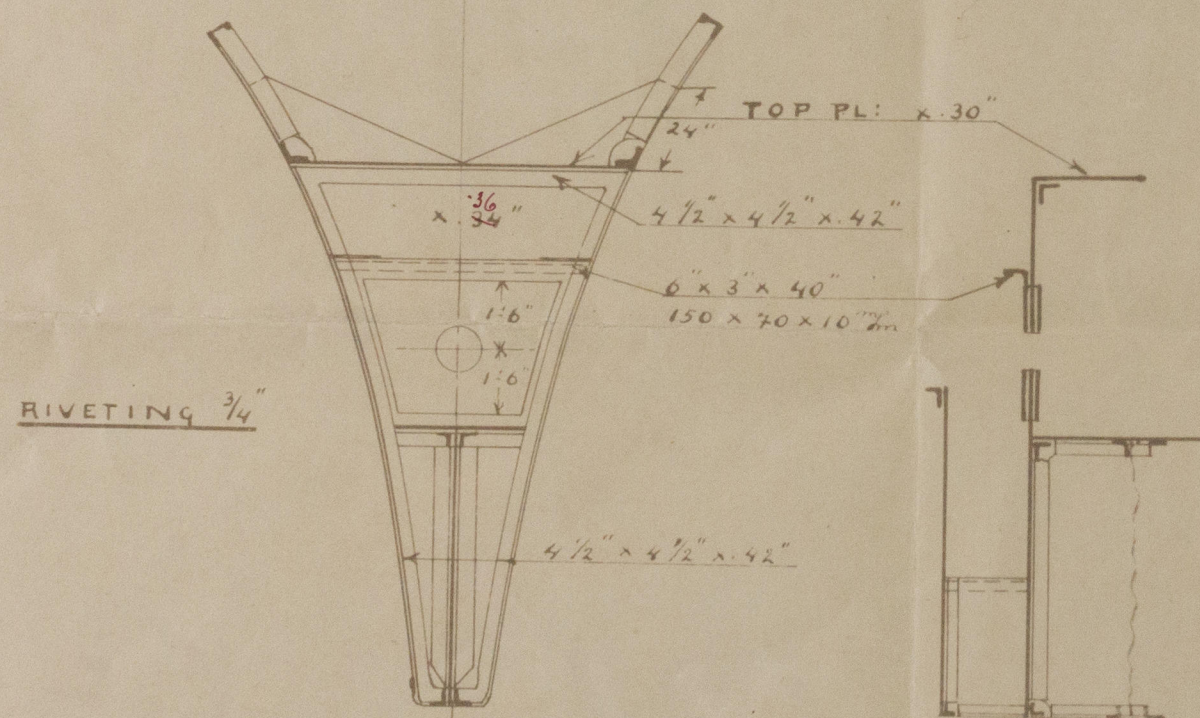

RIVETING  $\frac{3}{4}$ "


SCHEEPS WERF VOORHEEN JAN SMIT 62

ALBLASSERDAM

HOLLAND

BULKHEAD ON FRAME № 130

F.S. made on frame 129. and forepost carried up to.  
upper blk as owners request  
D. Kennedy

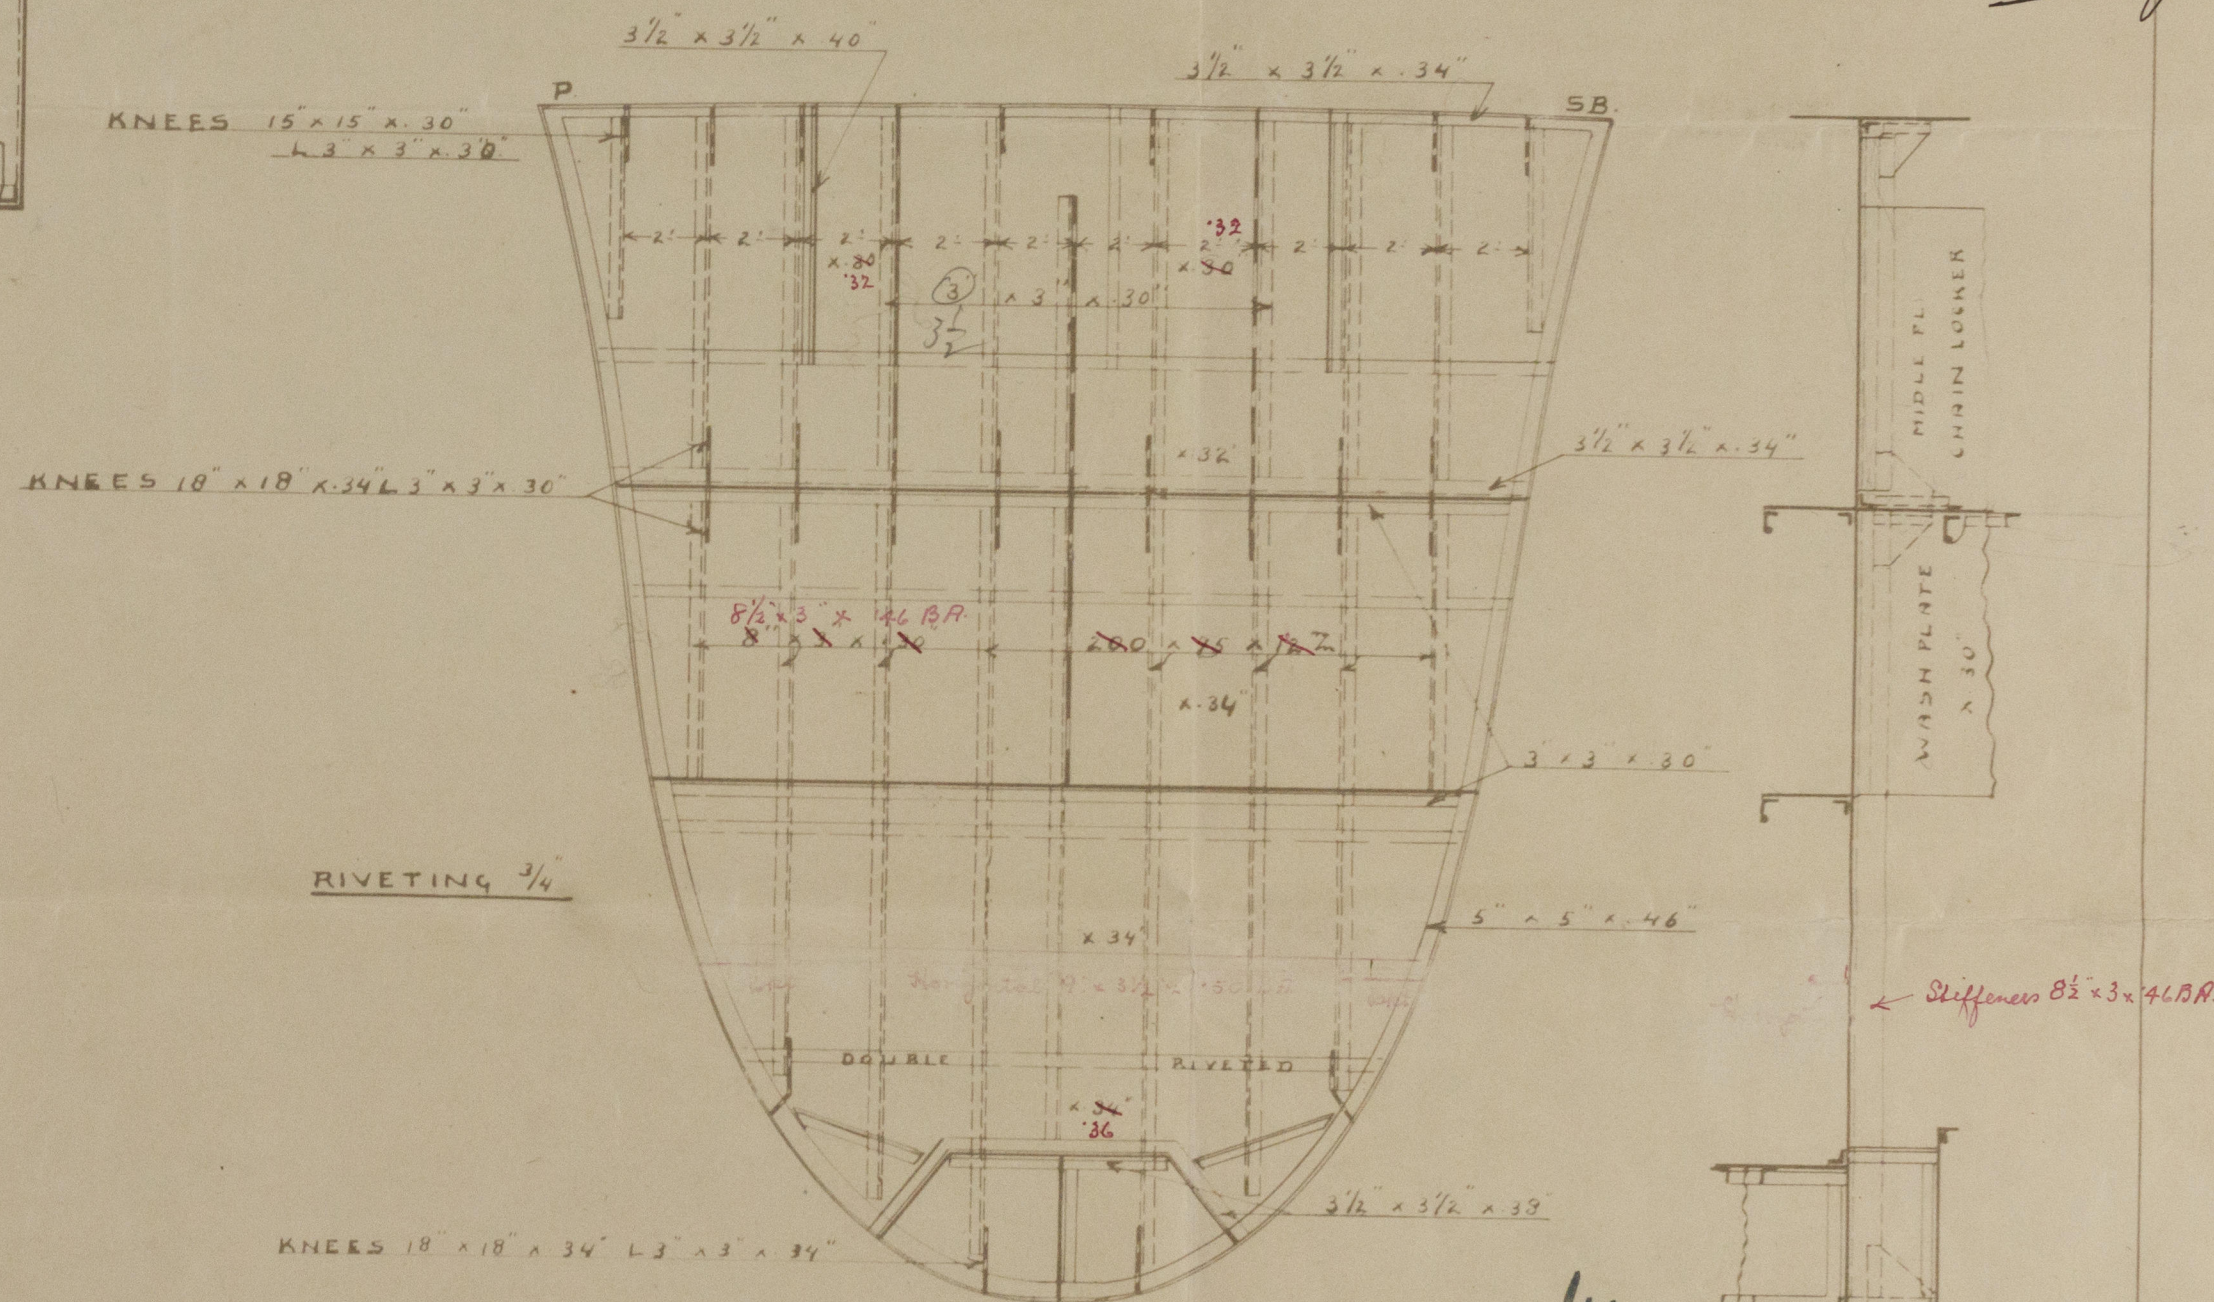

RIVETING  $\frac{3}{4}$

© 2021

Lloyd's Register  
Foundation

W 66-0031



448.  
peak 1340.

Peak Pths.

SS Sint Jansland

Rotterdam report no. 10670<sup>a</sup>

W66-0031



© 2021

Lloyd's Register  
Foundation