


Amberg as per Dec 17.

Jan
4. 6. 15

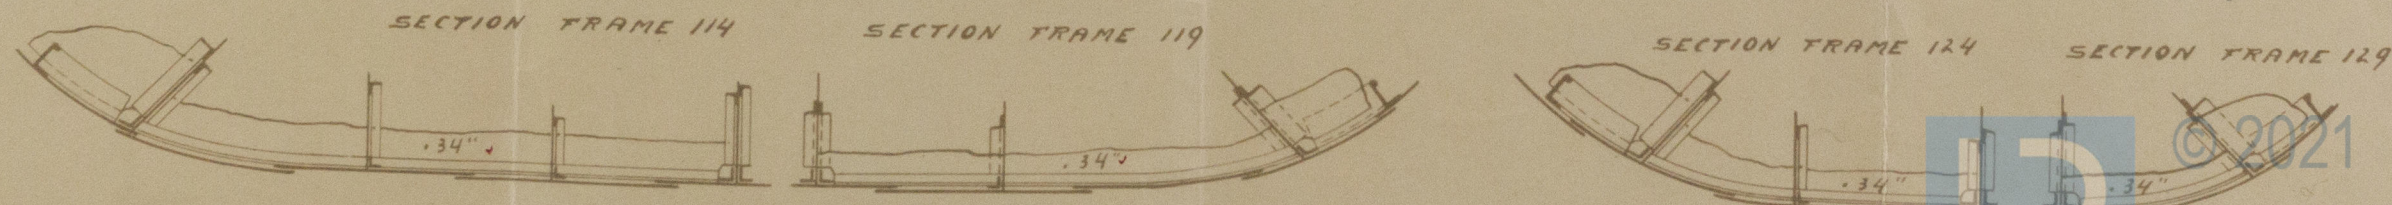


478

Bootham forew.

S. S. Sins Jausland

Bootham. plan forward

Rotterdam report. no-10170^a

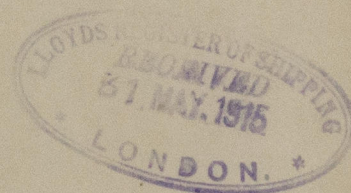

W66-0033



© 2021

Lloyd's Register
Foundation