
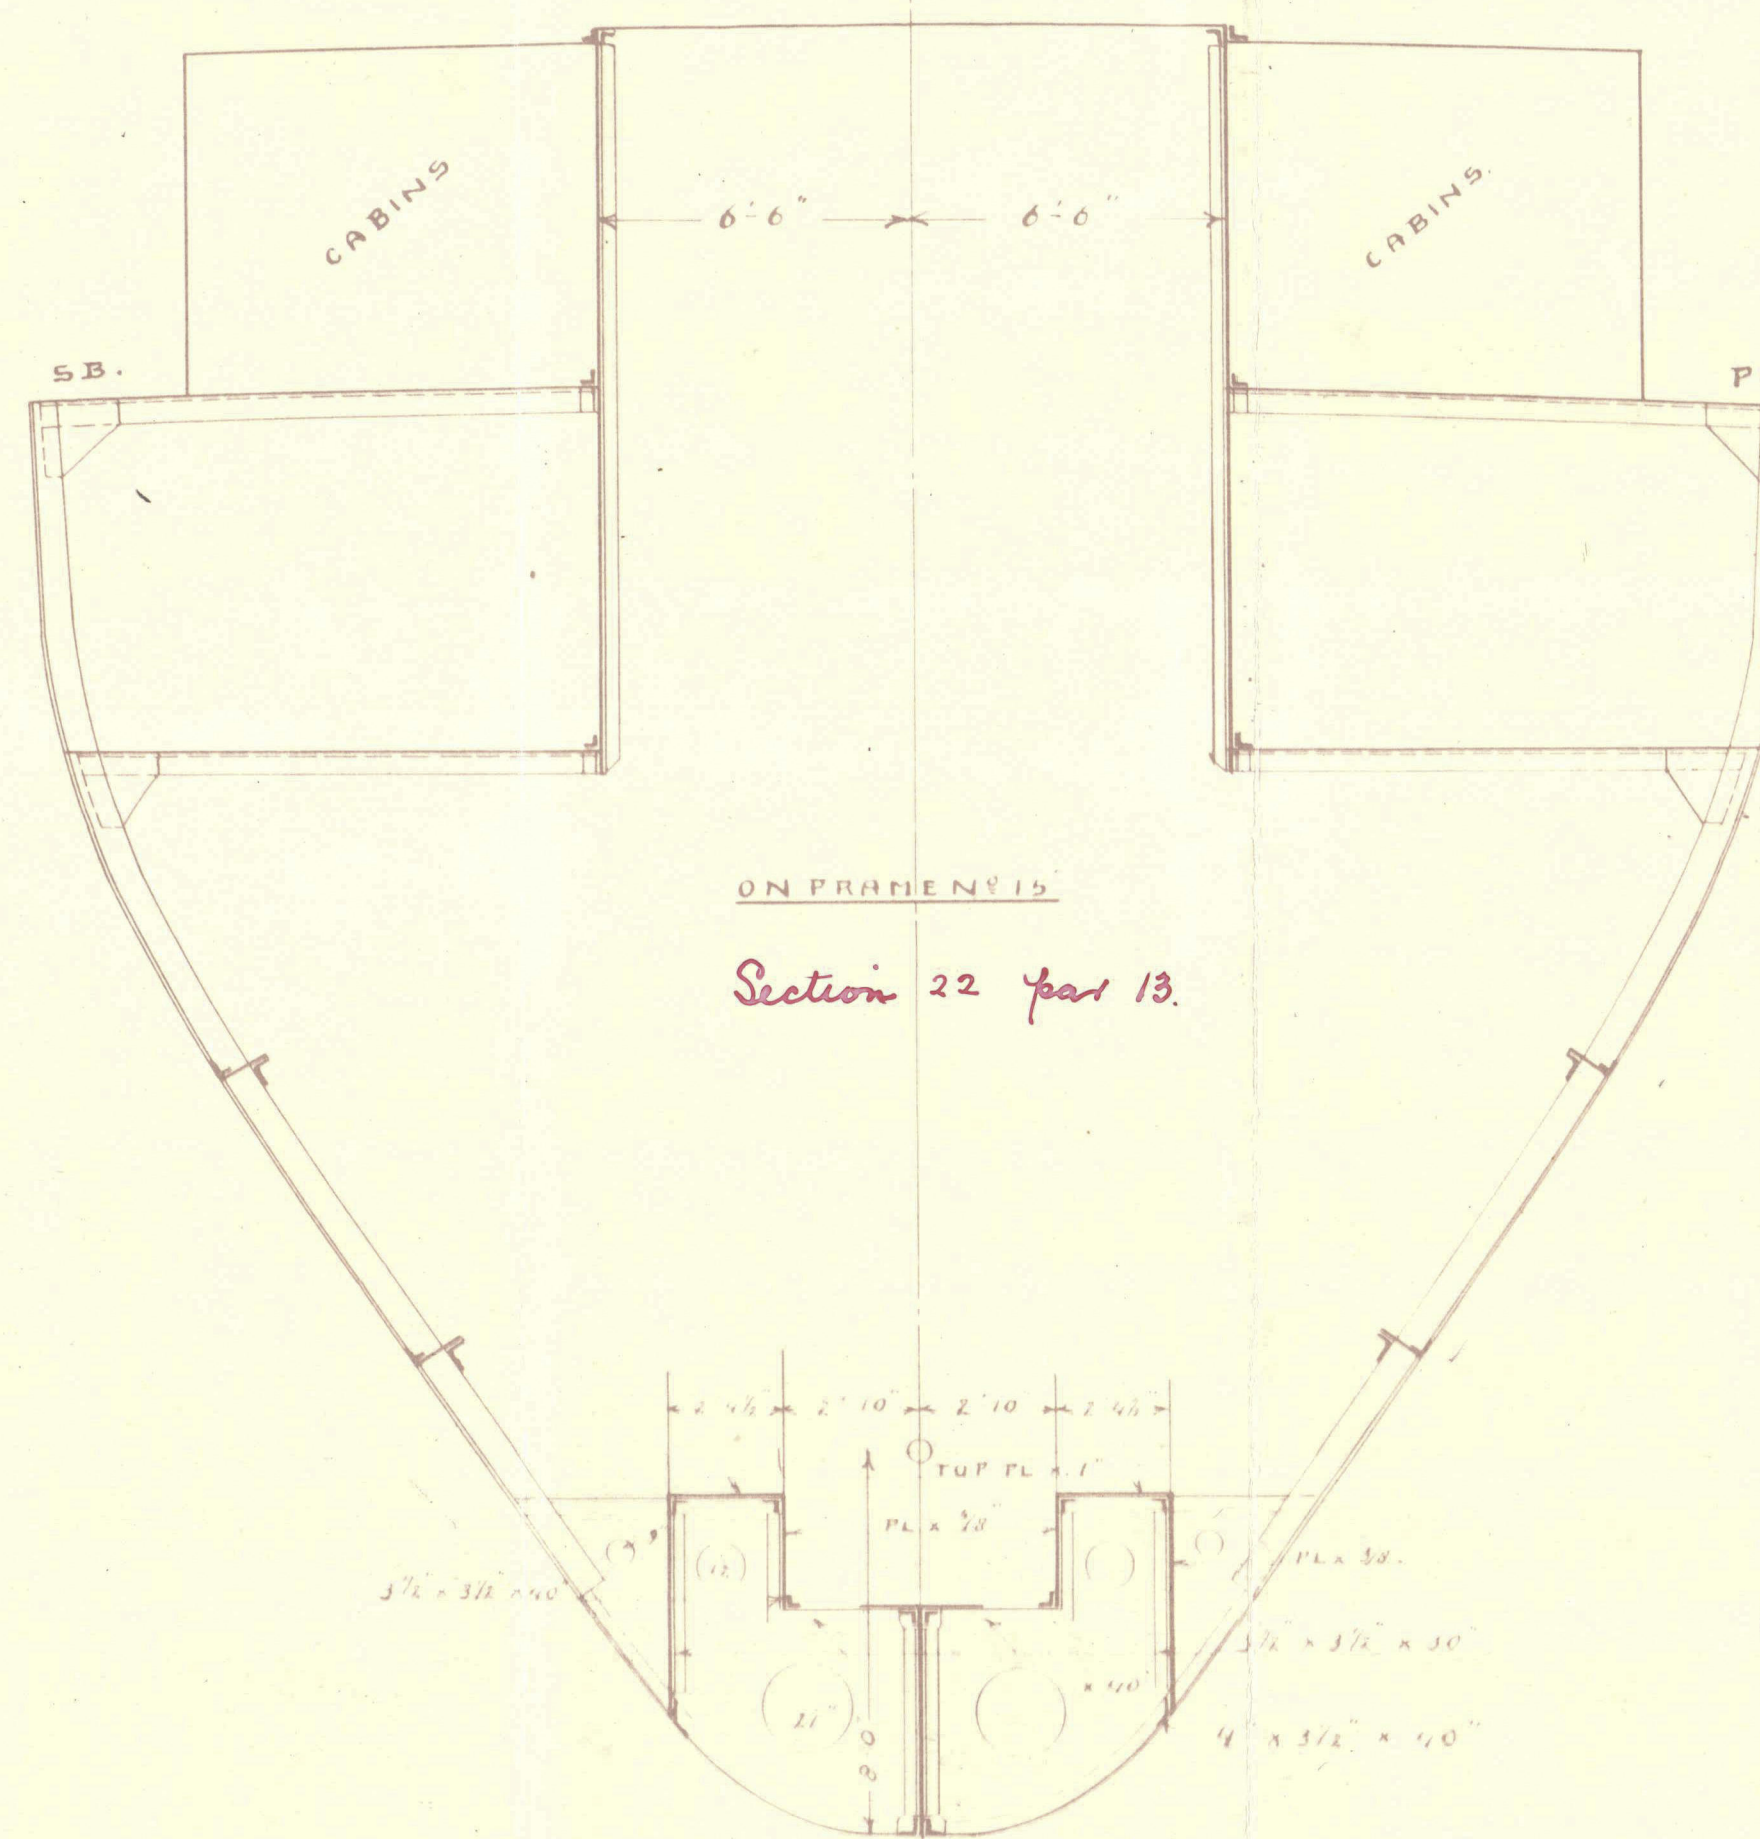


PLAN OF DOUBLE BOTTOM  
& ORDINARY FLOORS IN BOILER ROOM

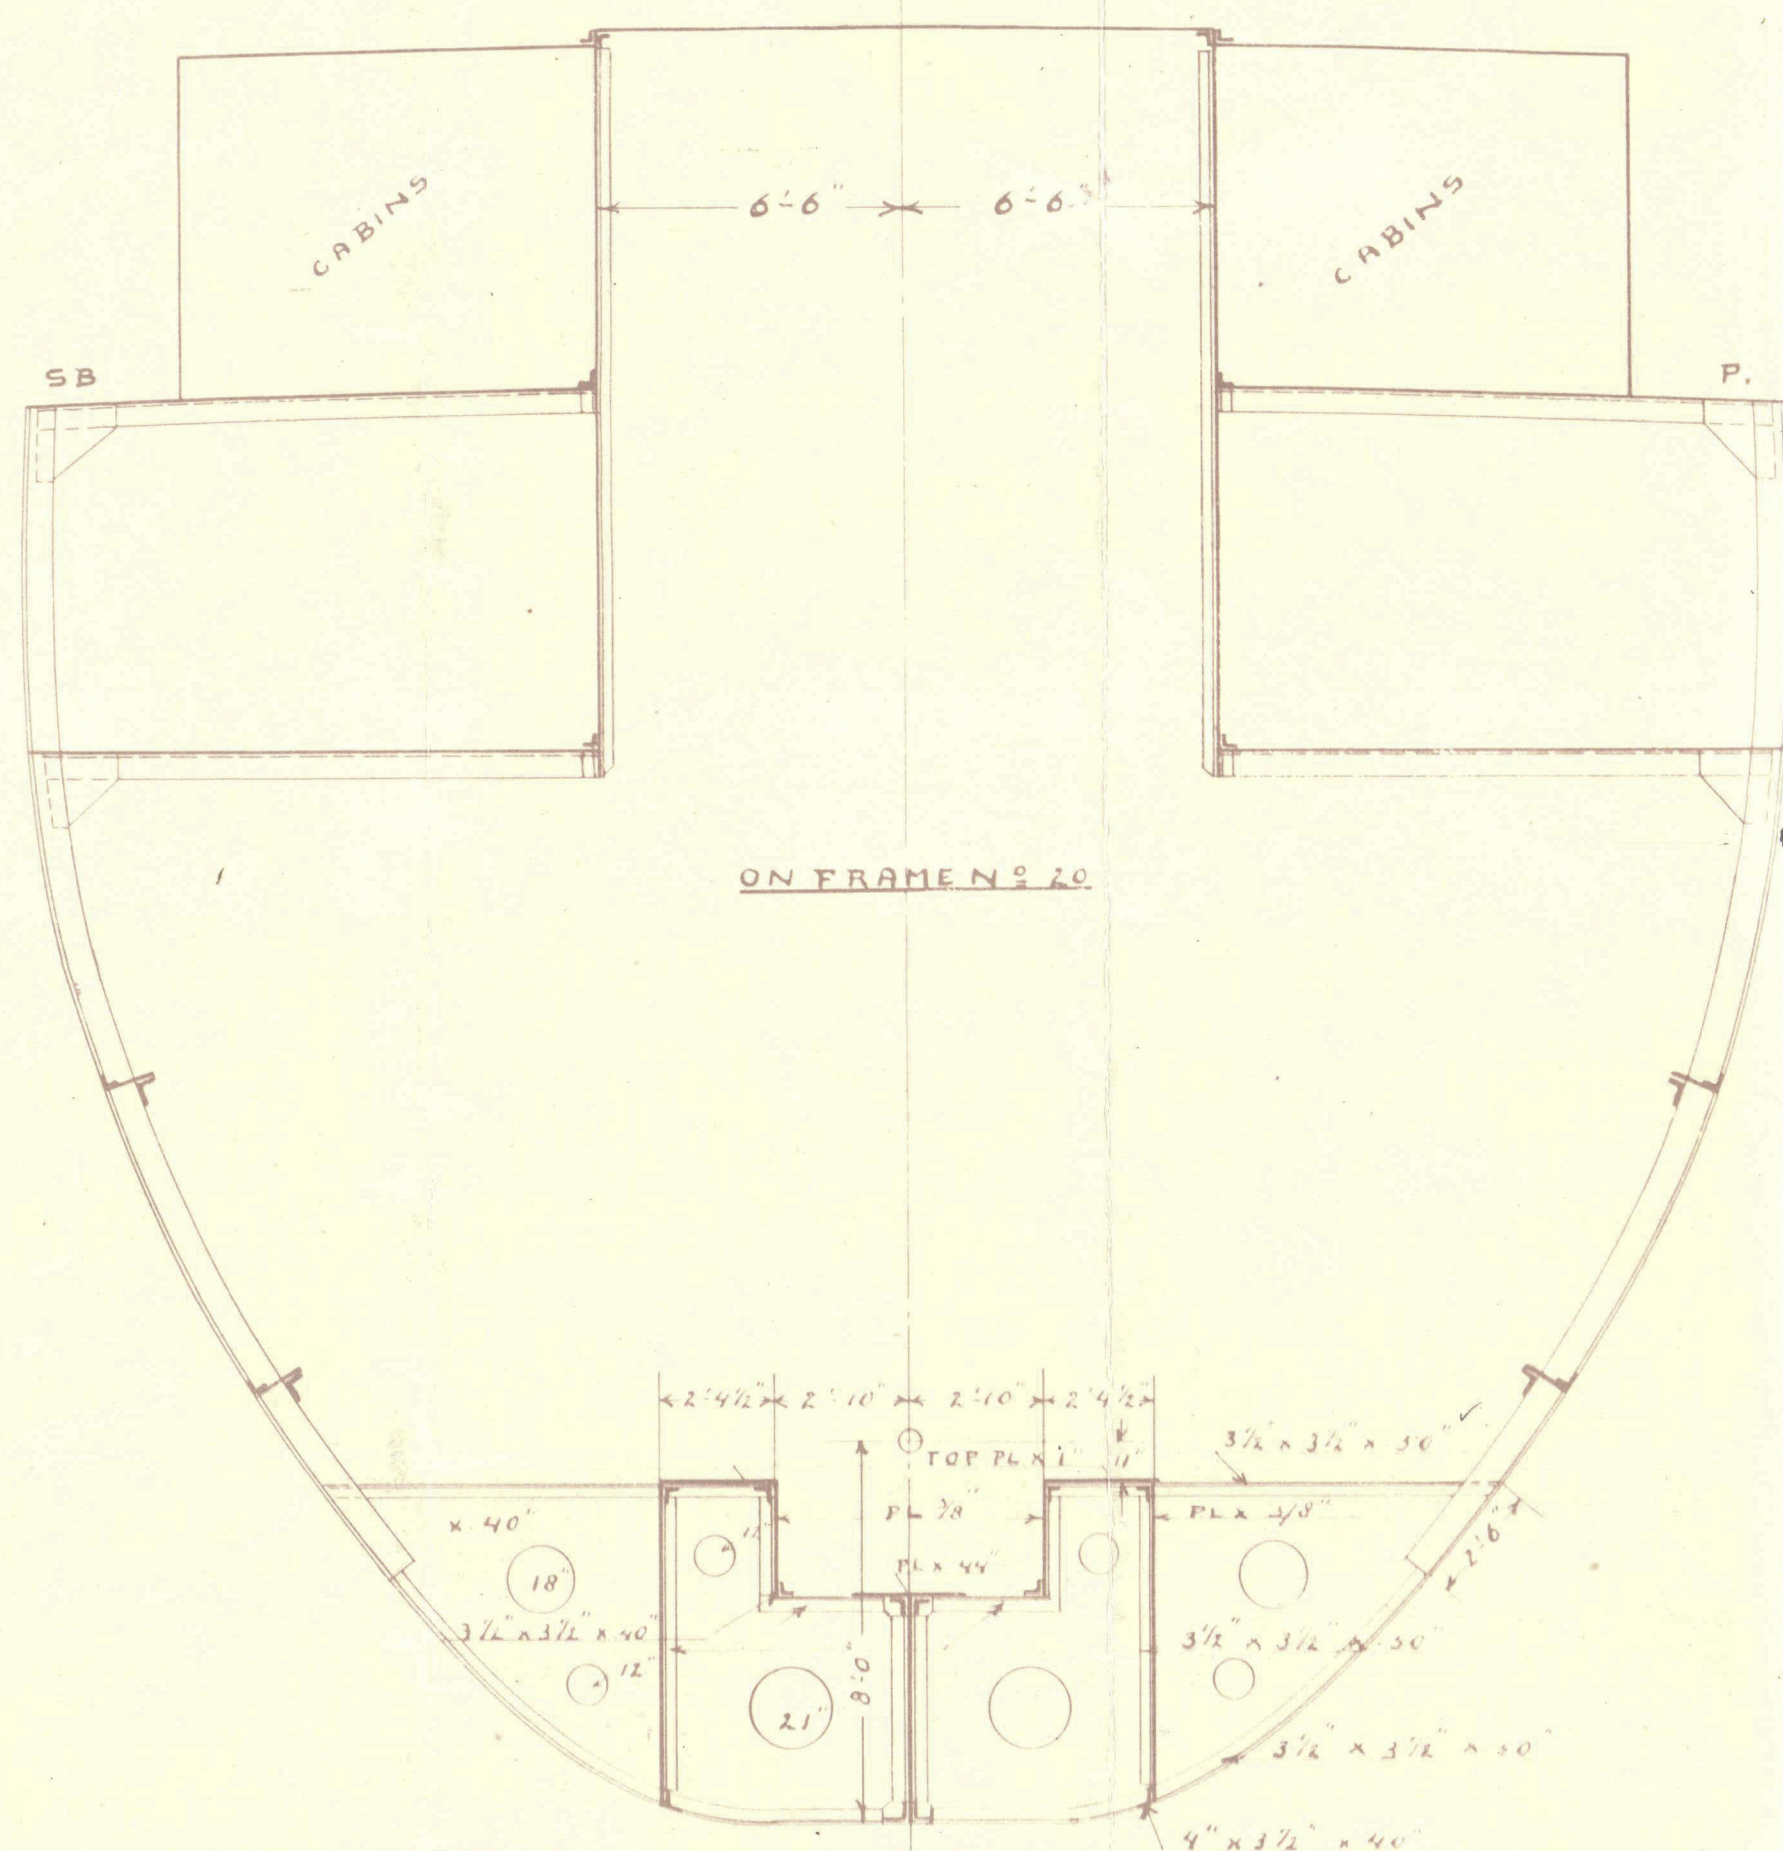

SECTIONS THROUGH ENGINE AND BOILER ROOM

SS N° 478

SCALE 1/4" = 1'


SCHIEP SWERT SOUWMEESTER JAN SMIT & C.

ALBUSSERDAM  
HOLLAND

fw  
5-3-15



Section through  
Eng space  
.478.

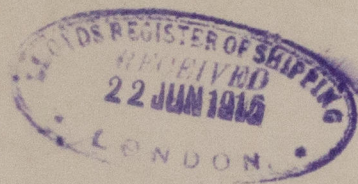

S. S. *Sint. F. auland*  
Rotterdam report. no. 10170  
Section at Eng. - Boiler space.

W/66-0034



© 2021

Lloyd's Register  
Foundation