


6-3-

6-3-15

DETAILS OF INTERCOSTALS IN ENGINE  
AND BOILER ROOM.

SCHEEPSWERF VOORHEEN JAN SMIT C<sup>1</sup>:  
ALBLASSERDAM  
HOLLAND


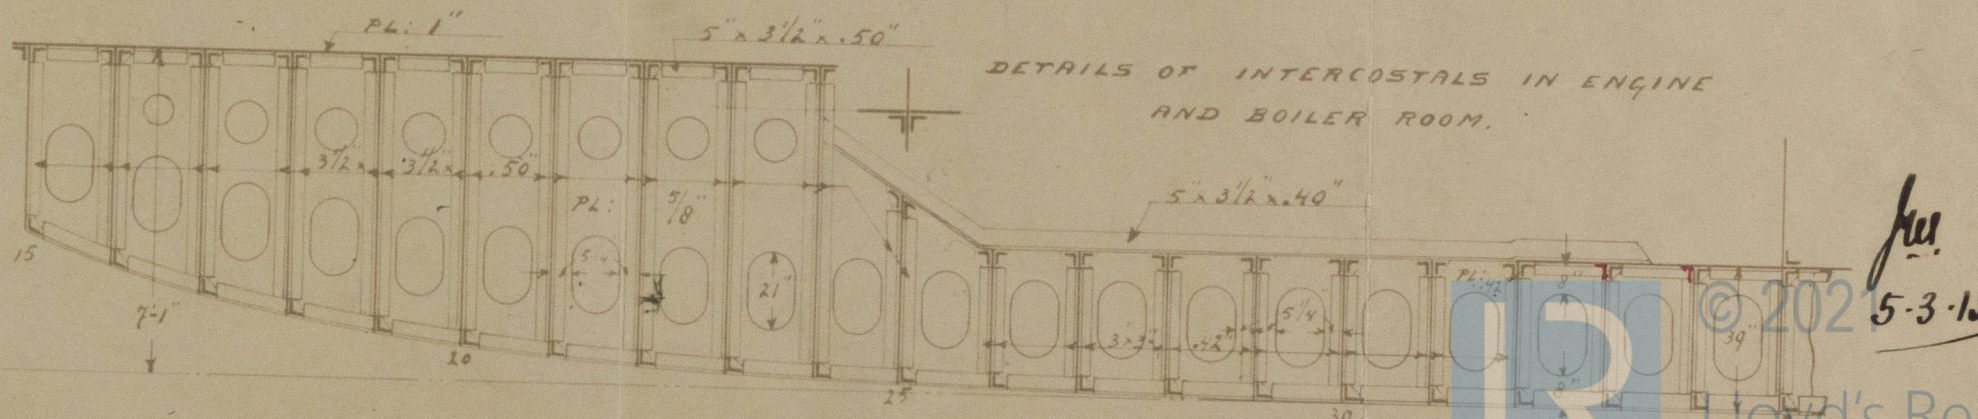


© 2021 5-3-15

Lloyd's Register  
Foundation

W 66-0035



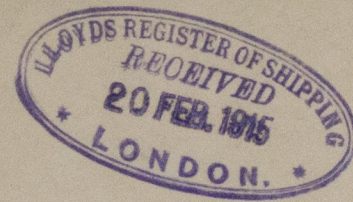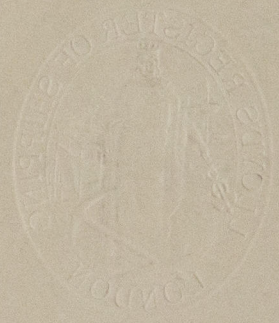

Engin & Boiler space  
for  
478.

S.S. *Lint. Lamsland.*

Rotterdam report. No. 10110<sup>2</sup>

for the in Eng. & B. space.