

18-10-07

# MIDSHIP SECTION

STEEL SCREW TRAWLERS

N<sup>o</sup> 424-5



DIM<sup>s</sup> - 155'-0" x 25'-0" x 14'-0" MOULDED.

SCALE 1/2" = 1 FOOT

TO CLASS 100 A.I. AT LLOYDS FOR FISHING PURPOSES.

E & B CASING AS PREVIOUSLY APPROVED

DECK PLATED OVER AT SIDES OF E. & B. CASINGS.

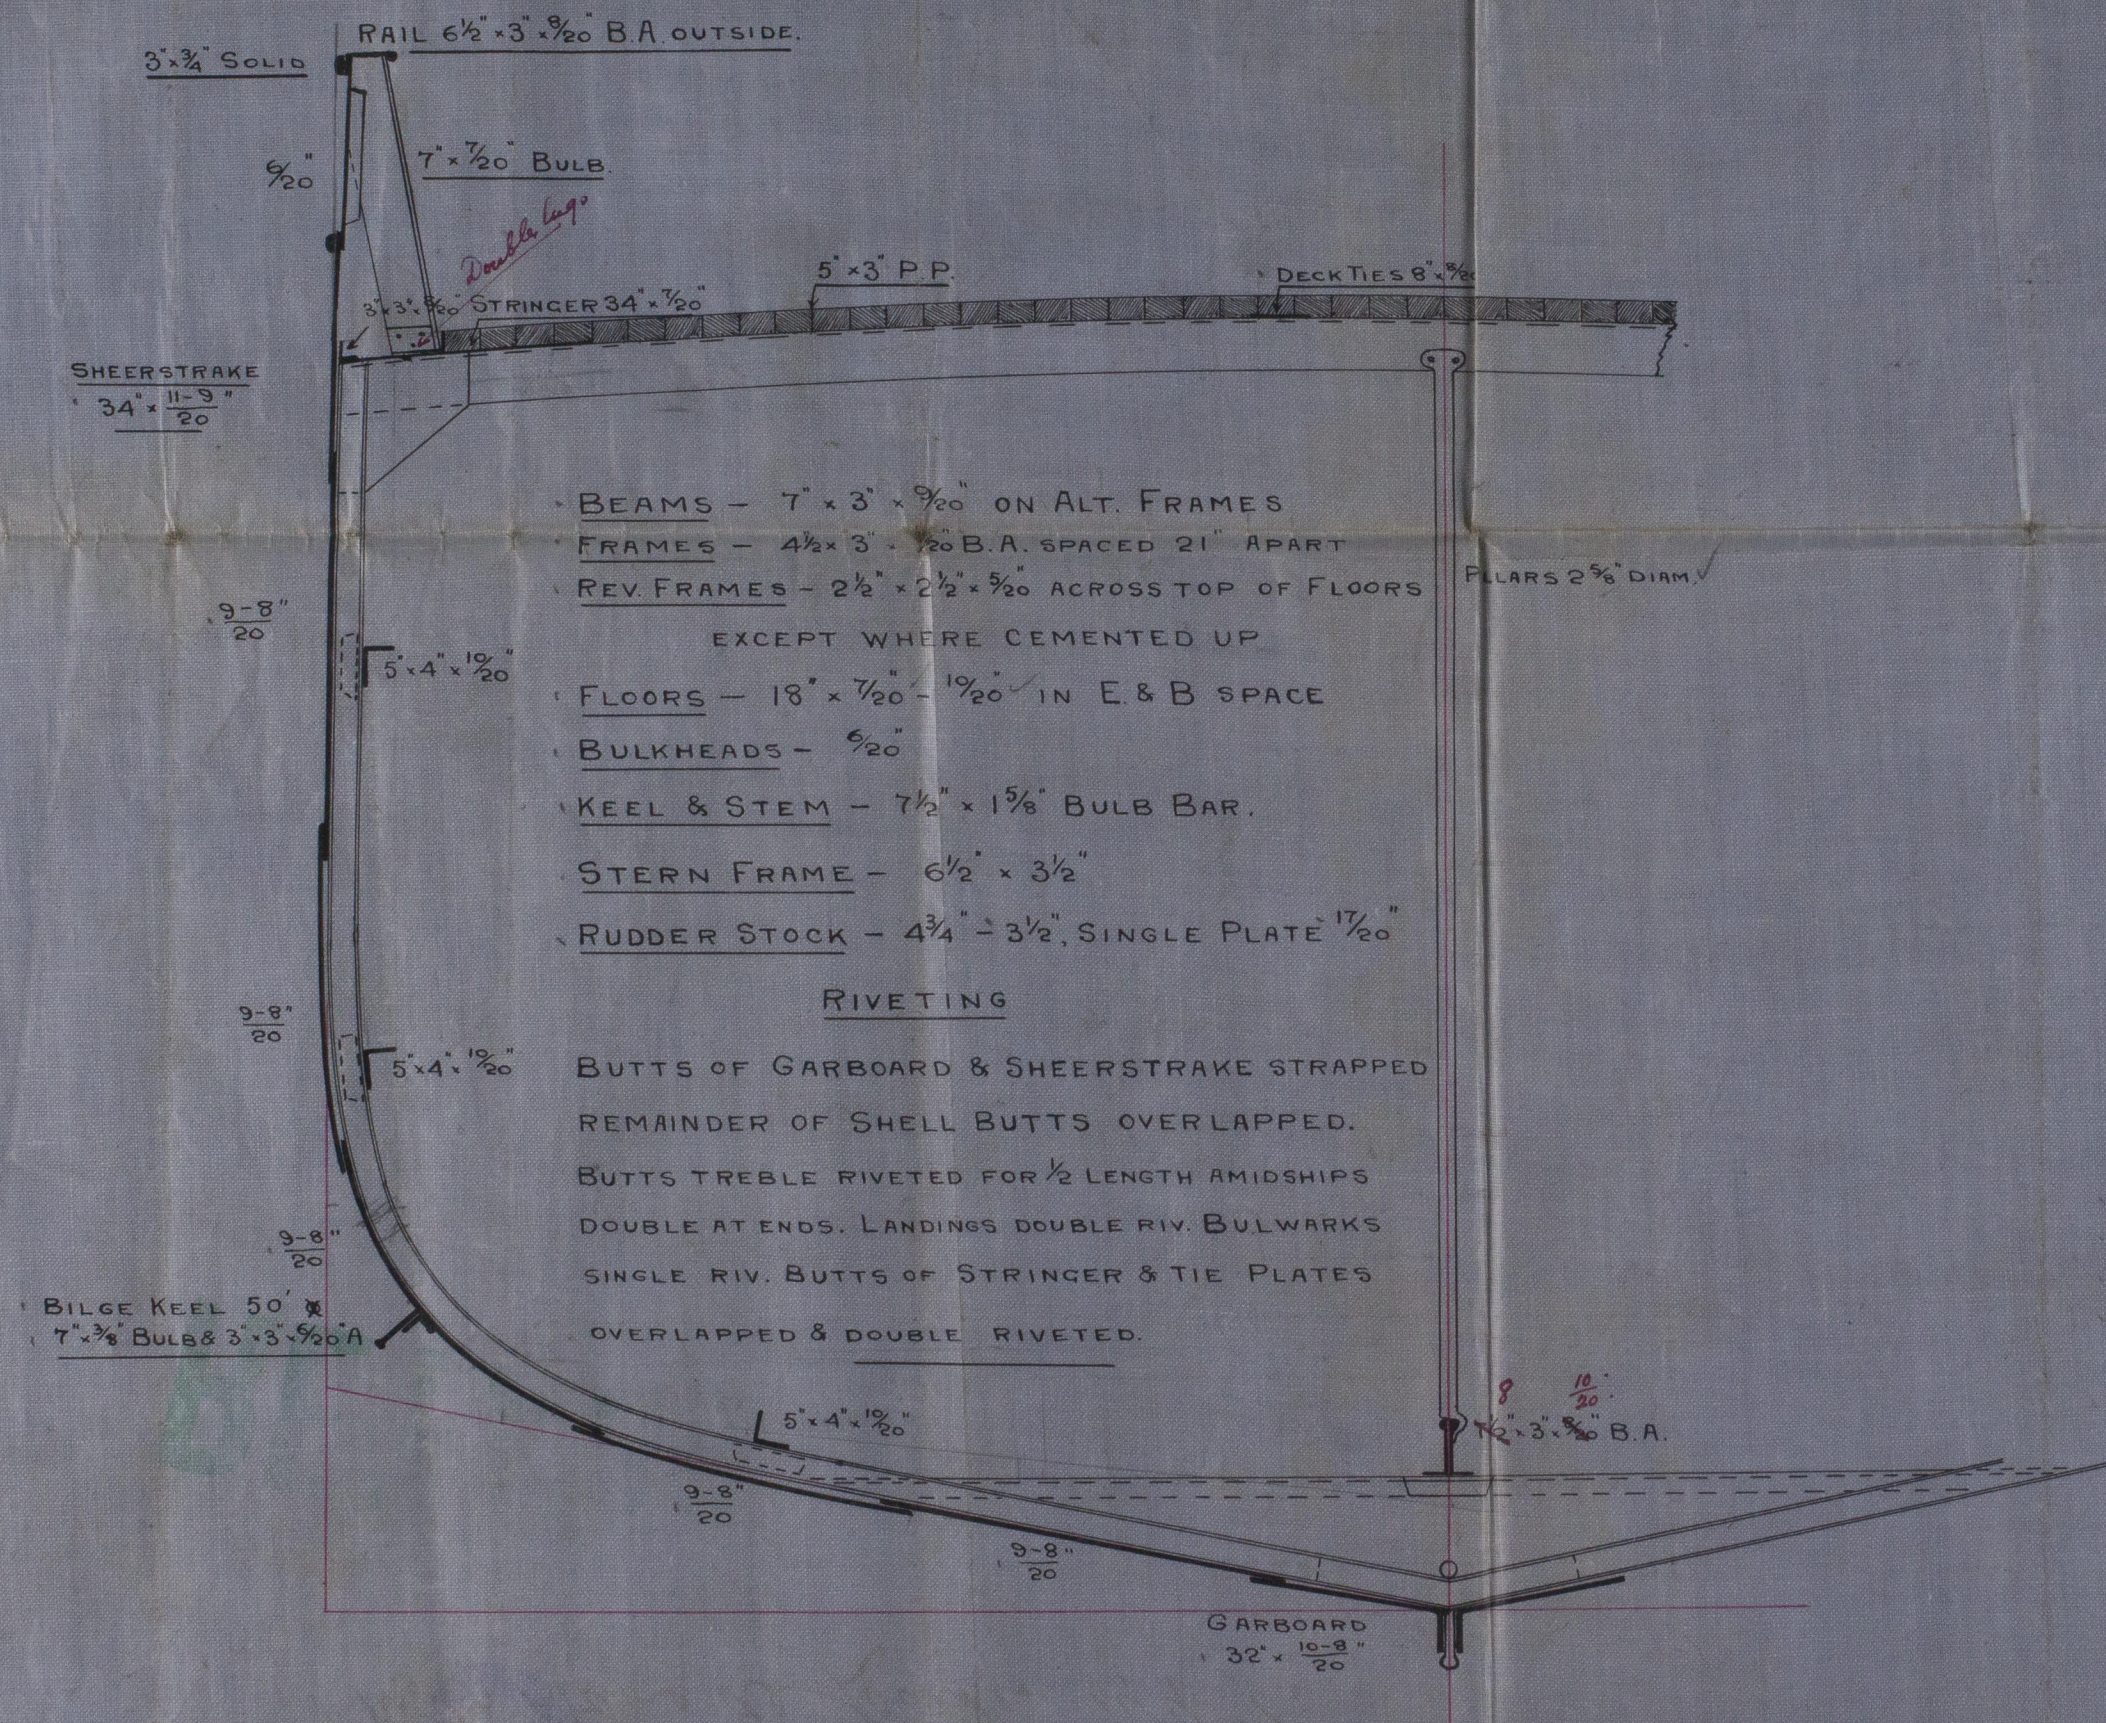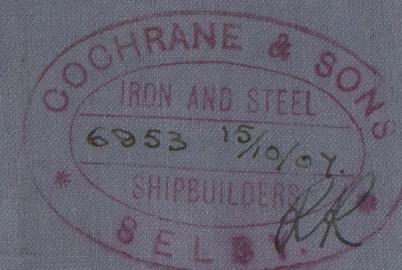

## NUMERALS


1/2 BREADTH	12.50	
1/2 GIRTH	23.00	
DEPTH	14.50	
	50.00	1 <sup>ST</sup> NO.
RULE LENGTH	153.8	
	7690.0	2 <sup>ND</sup> NO.

## PROPORTIONS

1/5	-	10.60
1/8	-	6.175

## EQUIPMENT

1 <sup>ST</sup> BOWER ANCHOR	7 CWT
2 <sup>ND</sup> "	6 1/2 "
3 <sup>RD</sup> "	3 1/2 "
120 FATHOMS	1 3/8 CABLE.
60 "	7 HAWSER.
60 "	5 WARP.

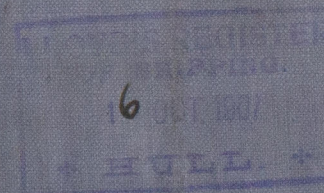

© 2021

Lloyd's Register  
Foundation

W660+0046



Cochran & Sons  
No. 424 + 5  
Midship Section.

"Labrador" Hull  
19911  
Notre Dame de Lourdes 1995-8.

RET



© 2021

Lloyd's Register  
Foundation

W660-0046