

18-10-07

and 2 inches
2 x 1/2
1/2 x 1/2

PROFILE AND DECK PLAN

STEEL SCREW TRAWLERS



N^o 424-5.

DIM^s 155'-0" x 25'-0" BREADTH x 14'-0" MLD

SCALE 1" = 1 FOOT



PILLARS THROUGHOUT TO SURVEYORS SATISFACTION.

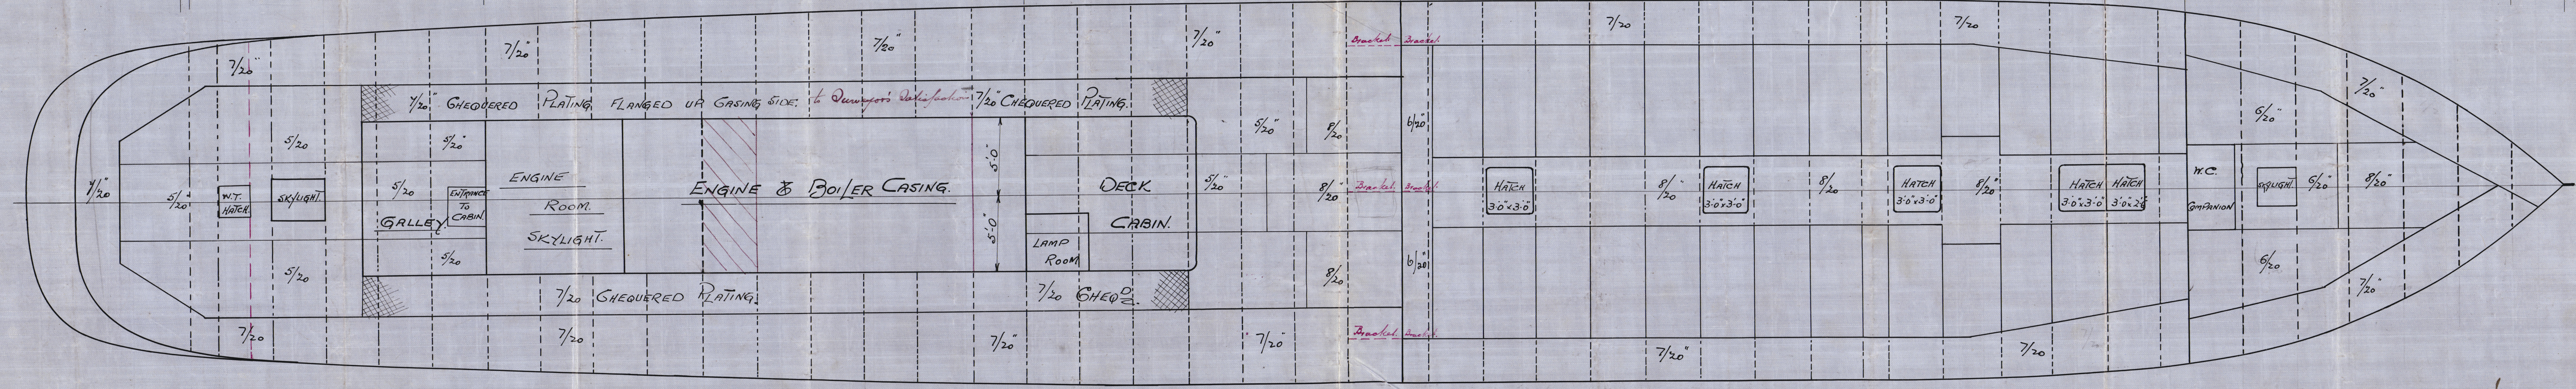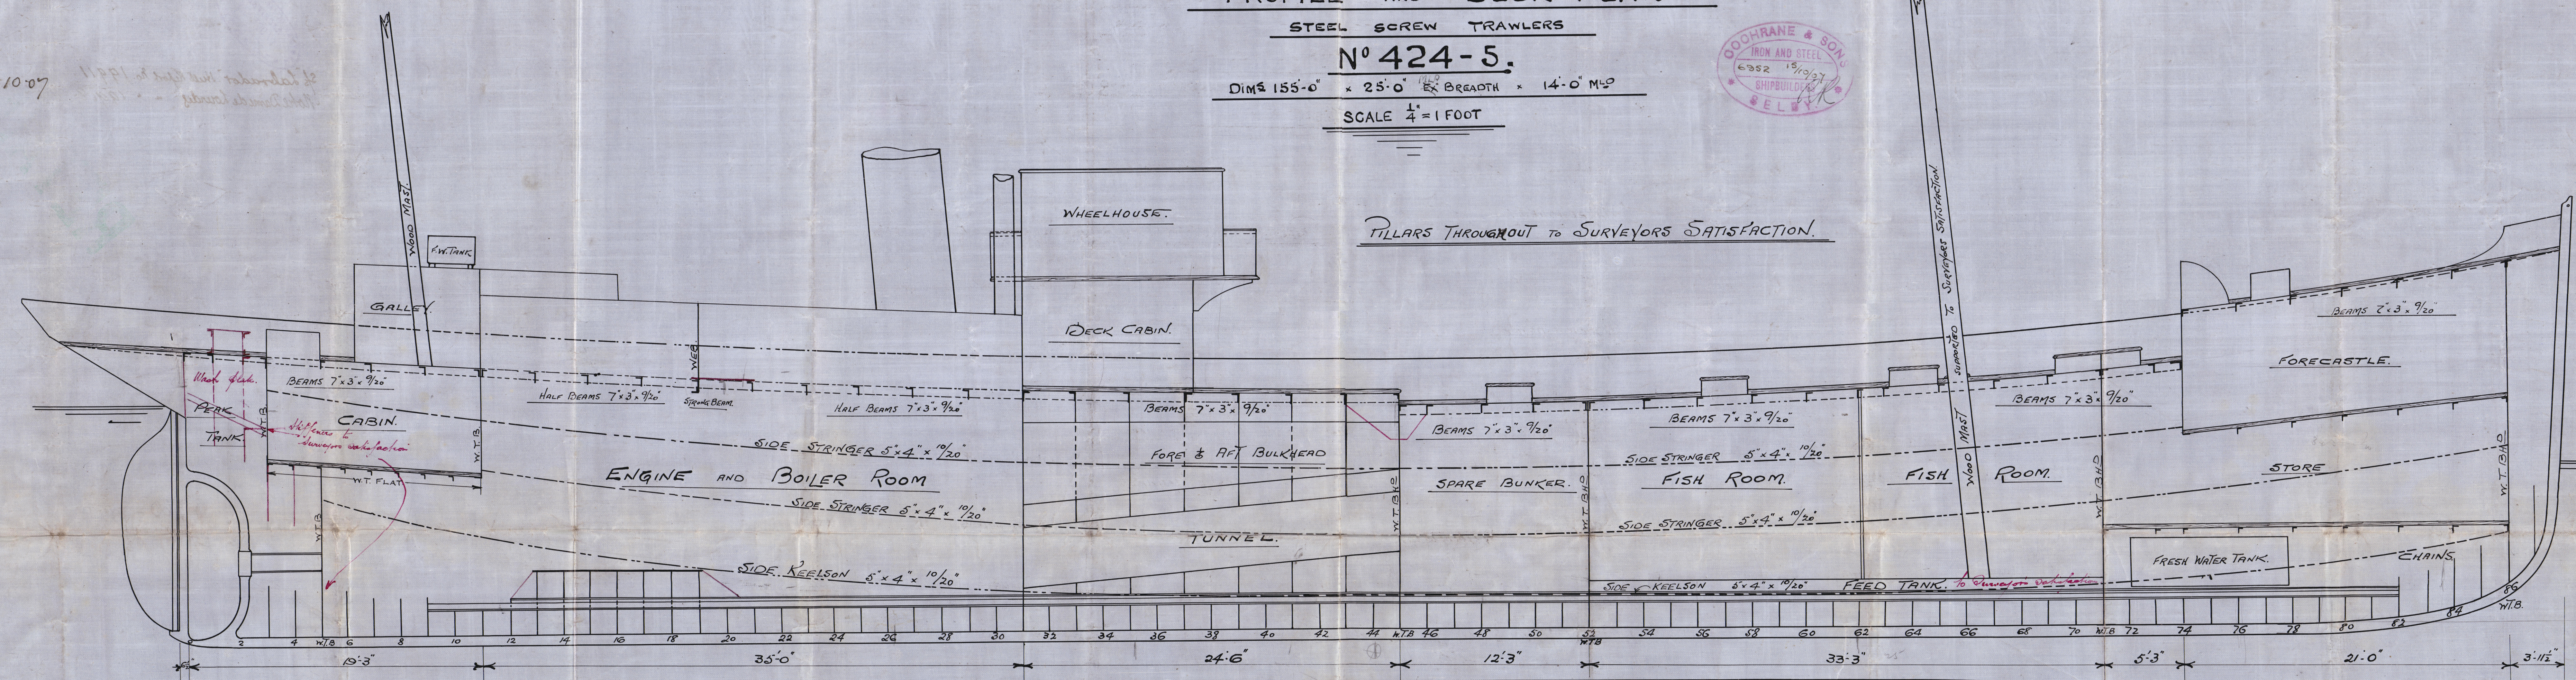

18/10/07



Cochrane & Sons


N^o 424 + 5

Profile & Deck Plan.



S/S "Labrador" Hull Report No. 19911
"Notre Dame de Lourdes" " " 19918.

RECEIVED
18-10-51

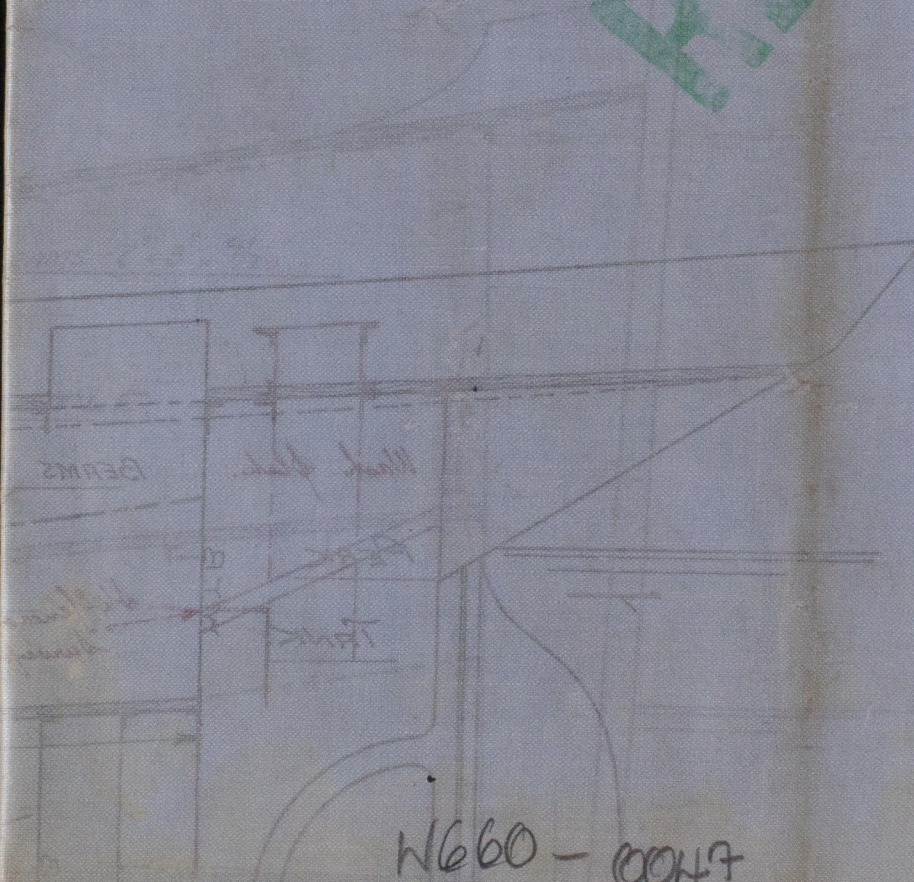

W660 - 00047



© 2021

Lloyd's Register
Foundation