


13.1.02
8.3.02


THIS SKETCH TO BE A FLY SHEET TO MIDSHIP
SECTION OF N^o 764 NOW ALSO MARKED N^{os} 765 & 6

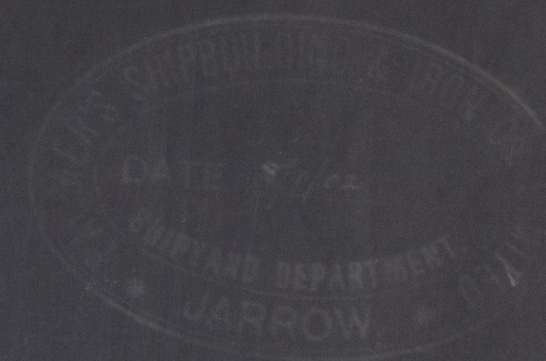

N^{os} 765 & 6

PROPOSED MODIFICATION OF BOTTOM FRAMING


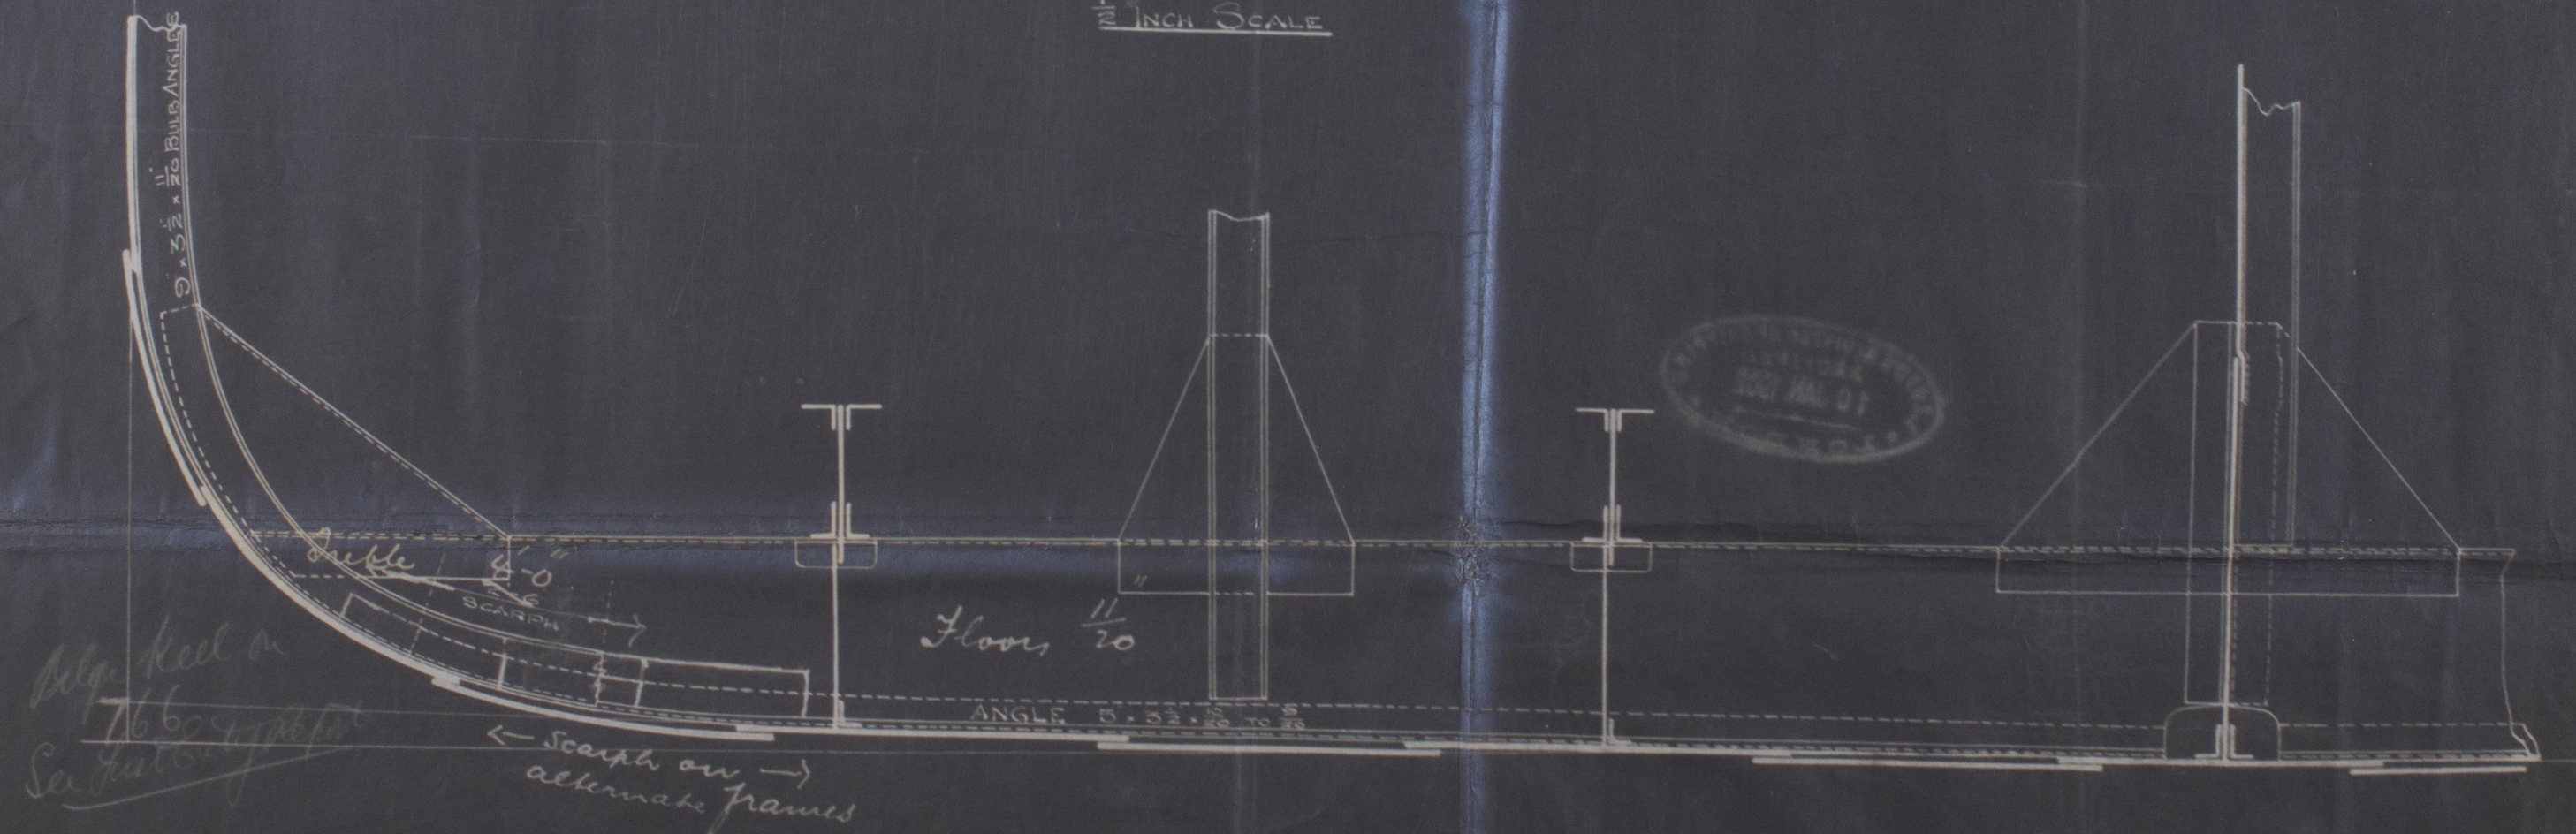

© 2008
Lloyd's Register
Foundation