



C.I. Cleats Galv.  
 Suitable For  
 $3\frac{1}{2}$ " Manila Rope.

BREWER DRY DOCK CO.  
 Marine Harbor S.I.N.Y.

#### DIMENSIONS

LENGTH	9 METERS = 29.5 Ft.
BREADTH	3.5 " = 11.5 Ft.
DEPTH	1.3 " = 4.25 Ft.

Hull 71' x 74'

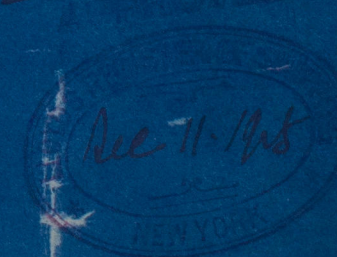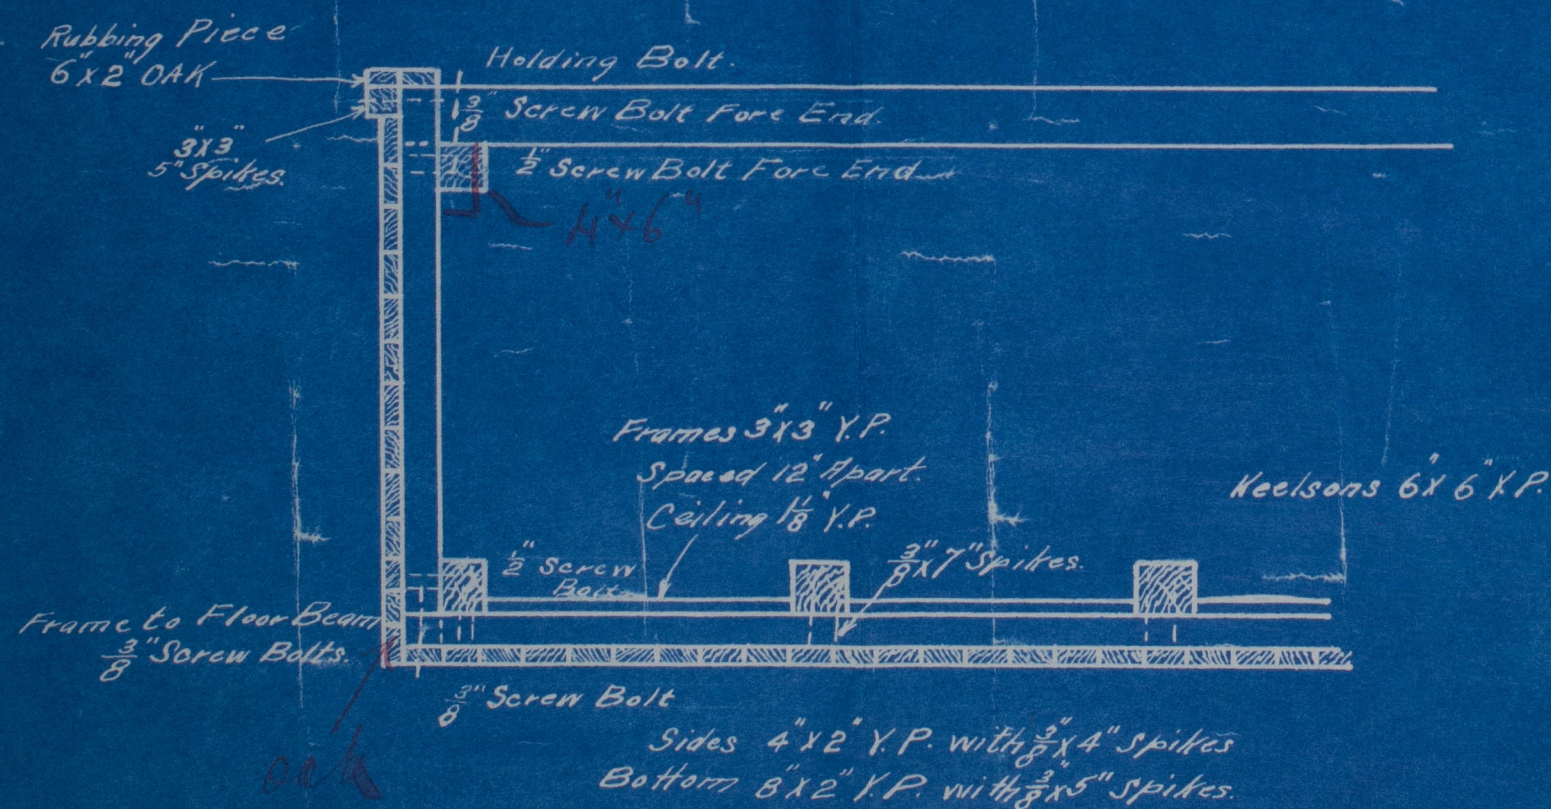

Equipment:

One - 150 lb anchor  
 150 ft -  $\frac{1}{2}$ " slow - link  
 chain



Lloyd's Register  
 Surveyors  
 100, Broad Street, London, E.C. 4, England



Beaver Bay Rock to Hall No. 42

Head Range "SEGUNDA"

(attached to P. 604)

RETAIN