

LONGITUDINAL AND DECK PLANS

S.S. N° 661 & 669


DIMENSIONS 122'-5" L^W x 52'-9" M^L x 55'-0" EXT x 32'-6" M^L TO UPPER DK
TO CLASS 100 A1 AT LLOYDS SPECIAL SURVEY
SCALE 1/8" = 1 FOOT

THE SCANTLING & DETAILS OF CONSTRUCTION NOTED HEREON ARE SUBMITTED ON THE UNDERSTANDING THAT THEY ARE THE MINIMUM WHICH WILL BE ACCEPTED FOR CLASS AND IF NOT THEY ARE TO BE AMENDED. ERRORS & OMISSIONS EXCEPTED

NOTE
FORE AND MAIN MASTS 3 PLATES IN ROUND
BUTTS LAPPED 1-3R ABOVE DECK
BUTTS LAPPED 1-2R BELOW DECK
SEAMS LAPPED & DOUBLE RIVETED

SHEER FORWARD 135'
" " " " 16'
" " " " 29'
" " " " 12'
TONNAGE COEFF ABOUT 175
ROUND OF BEAM 13'

PLAN OF GIRDERS WILL BE SUBMITTED LATER

 


Russell Esq

661

Longitudinal Plan & Deck

Also 86669

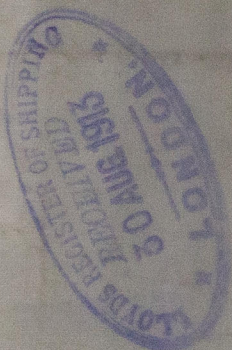

661.

"Saint Eibert."

Greenock L.E. Report No.


6626.



669

Saint George

srh rpt no 16791

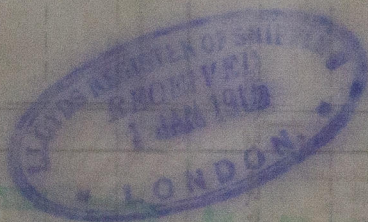

RETAIN

W664-0044



© 2021

Lloyd's Register
Foundation