




Shell plates to have a tensile strength of	27 to 30 tons
Butt Straps " " " "	of 27 to 32 tons
Longitudinal stays " " " "	of 27 to 32 tons
Other plates and bars " " " "	of 26 to 30 tons.

Heating Surface of Tubes	-	4680	\$
"	"	- Flues	266
"	"	- Comb. Chamb.	501
"	"	- Back Tube Plate	95
"	"	-	<del>75</del>


Total Heating Surface = ~~5556~~ 5542 ft<sup>2</sup>  
Grate Surface with 5'-9" Bars = 135.5 ft<sup>2</sup>

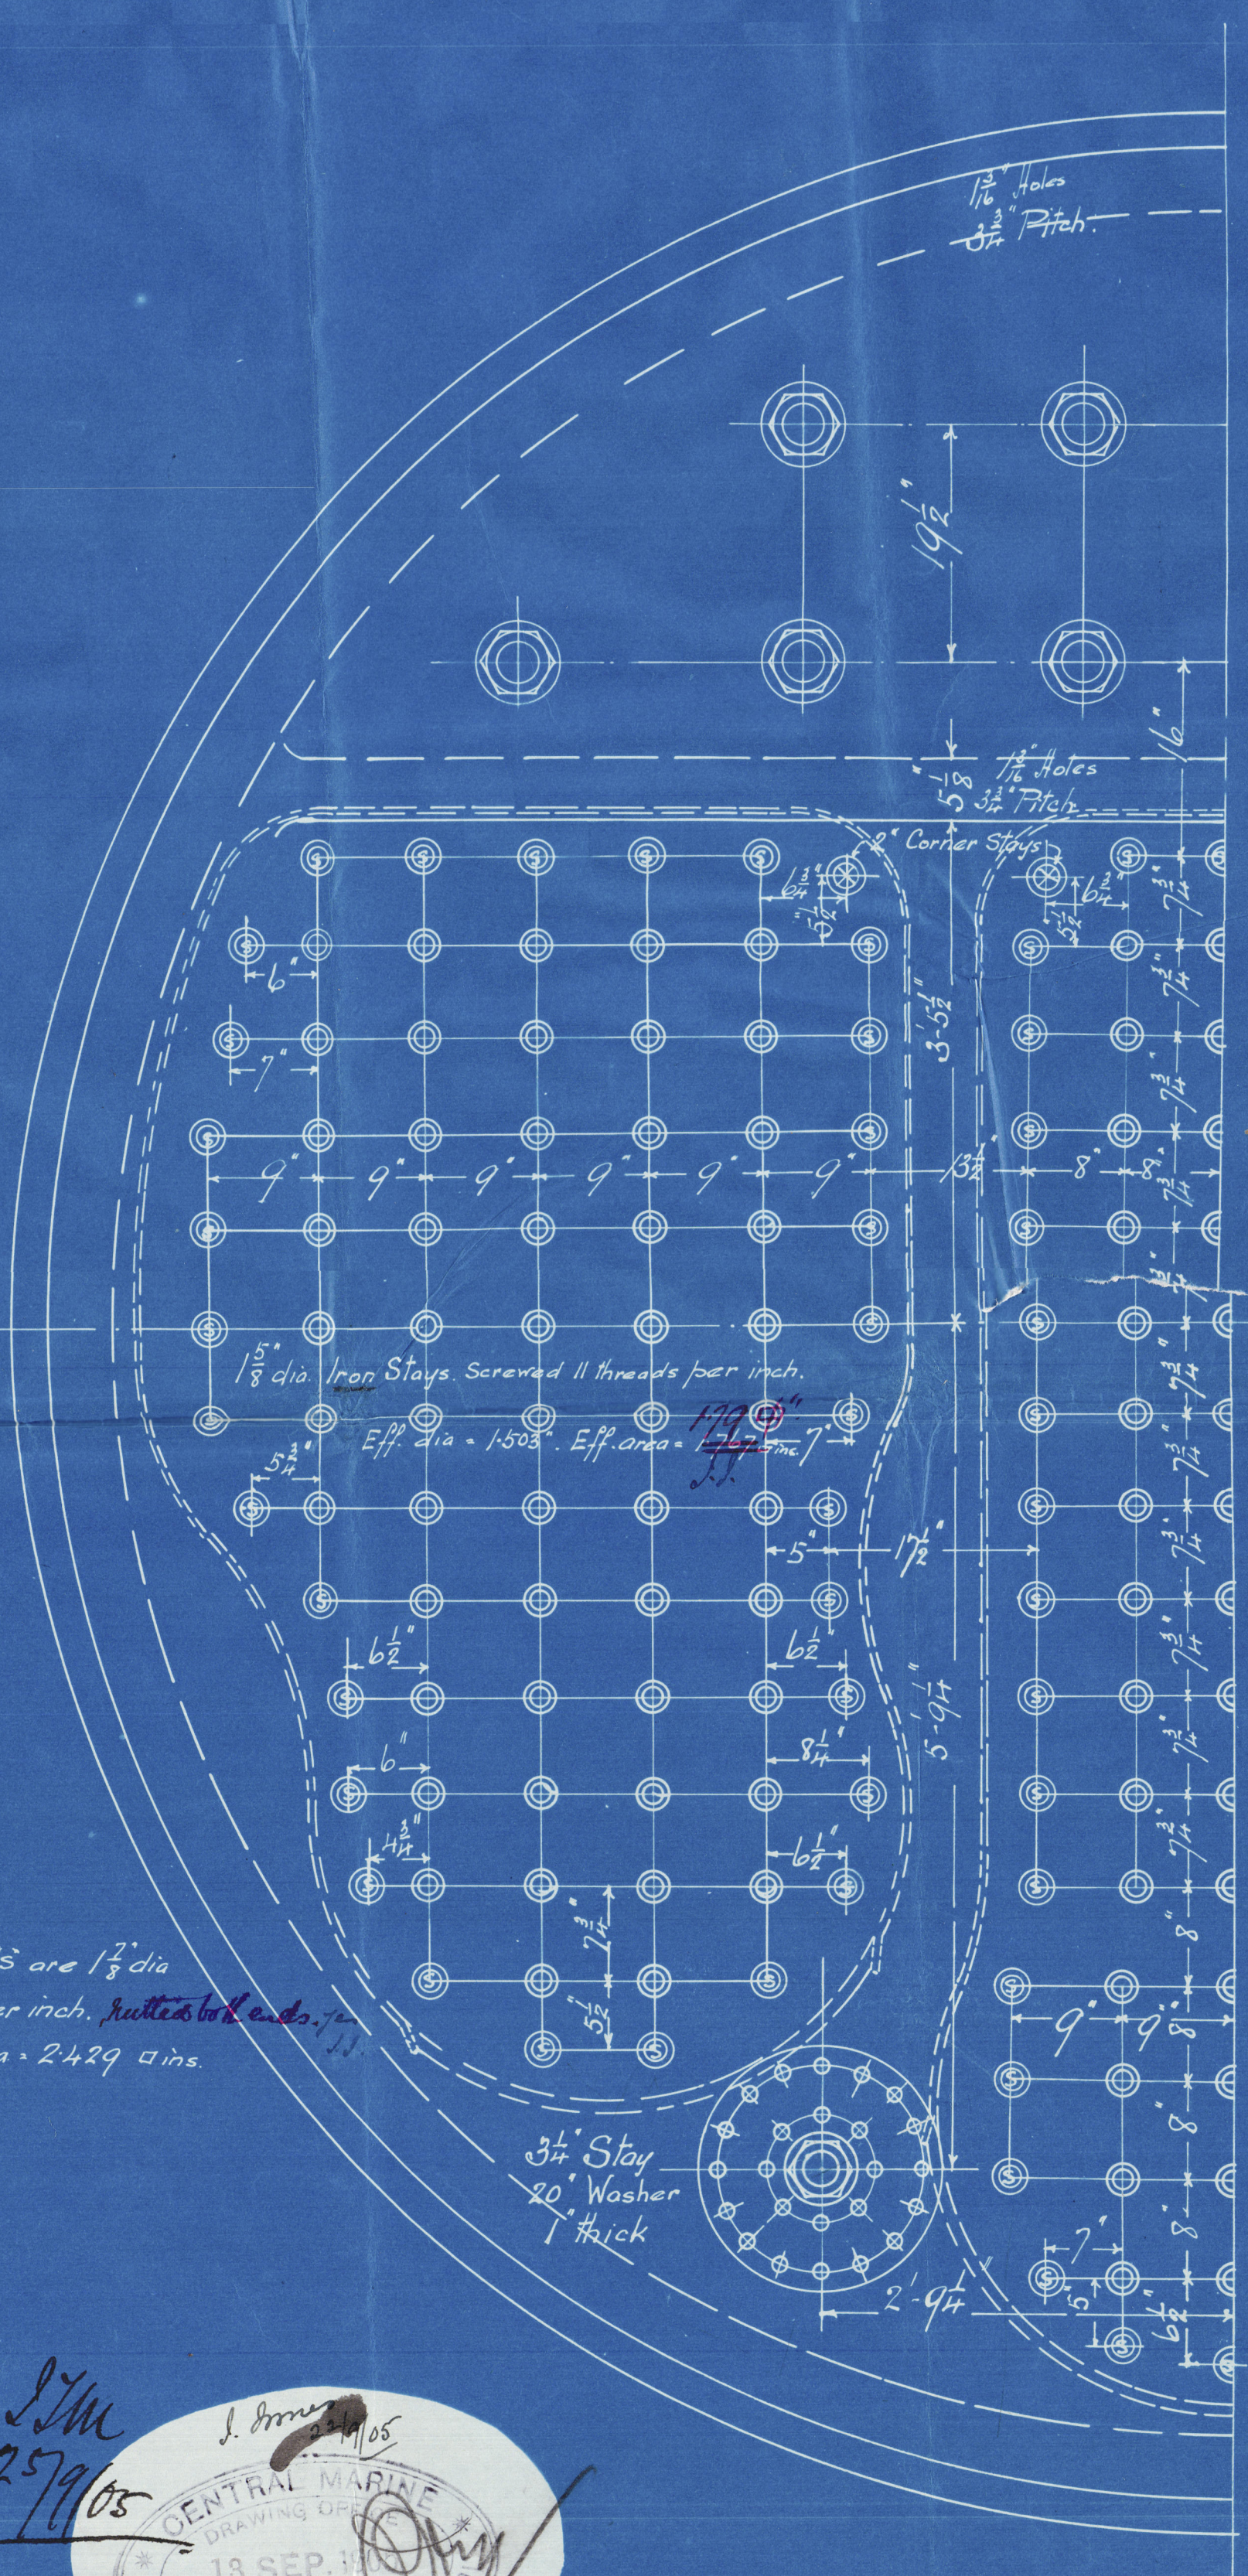

Iron stays marked 'S' are  $1\frac{1}{2}$ " dia  
Screwed 11 threads per inch, nutted both ends.  
Eff. dia. = 1.752. Eff. area = 2.429 sq ins.

**Nº 717.**

28M. 2579/05. 2579

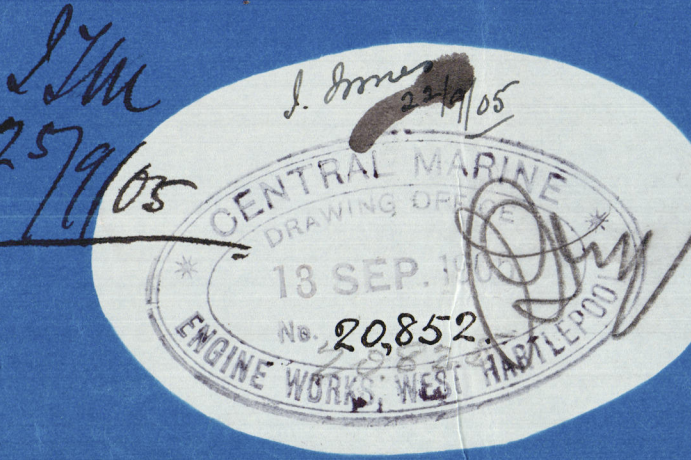



Centur No 717


The Prices

Grays S.O. & 717

180 lb

"Harperley"

Hpl. Report No. 12843

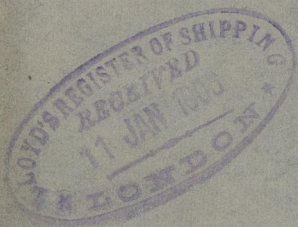

RETAIN



© 2021

Lloyd's Register  
Foundation

W664-0177