



25.8.05
29.8.05

PROFILE.

SCALE 1" = 1 FOOT.

Beams marked A. Buels 12 x 20 1 Angle 6 x 4 x 20
B. 11 x 20 1 6 x 4 x 20
C. 10 x 32 x 20 1 6 x 4 x 20


Bridge or P Beams Buels Angle 4 1/2 x 3 x 20
6 x 3 x 20

Upper Deck
Under Deck Beams Buels Angle 10 x 32 x 20
Half 9 x 32 x 20
End Main in Peaks 2 3/4 x 3 x 20
Bridge Space Beams 10 x 32 x 20
9 x 32 x 20

Deck Plating doubled at corners of Hatchways
and large Deck Openings.

3rd St Beams 12 x 20 x 20 10 3 1/2 x 20
2nd Beams 2 3/4 x 3 x 20 9 x 32 x 20

Note: Hatch door rafters filled or four web plates fitted in each hatchway if fore and after distances meet
Wood cover fitted fore raft

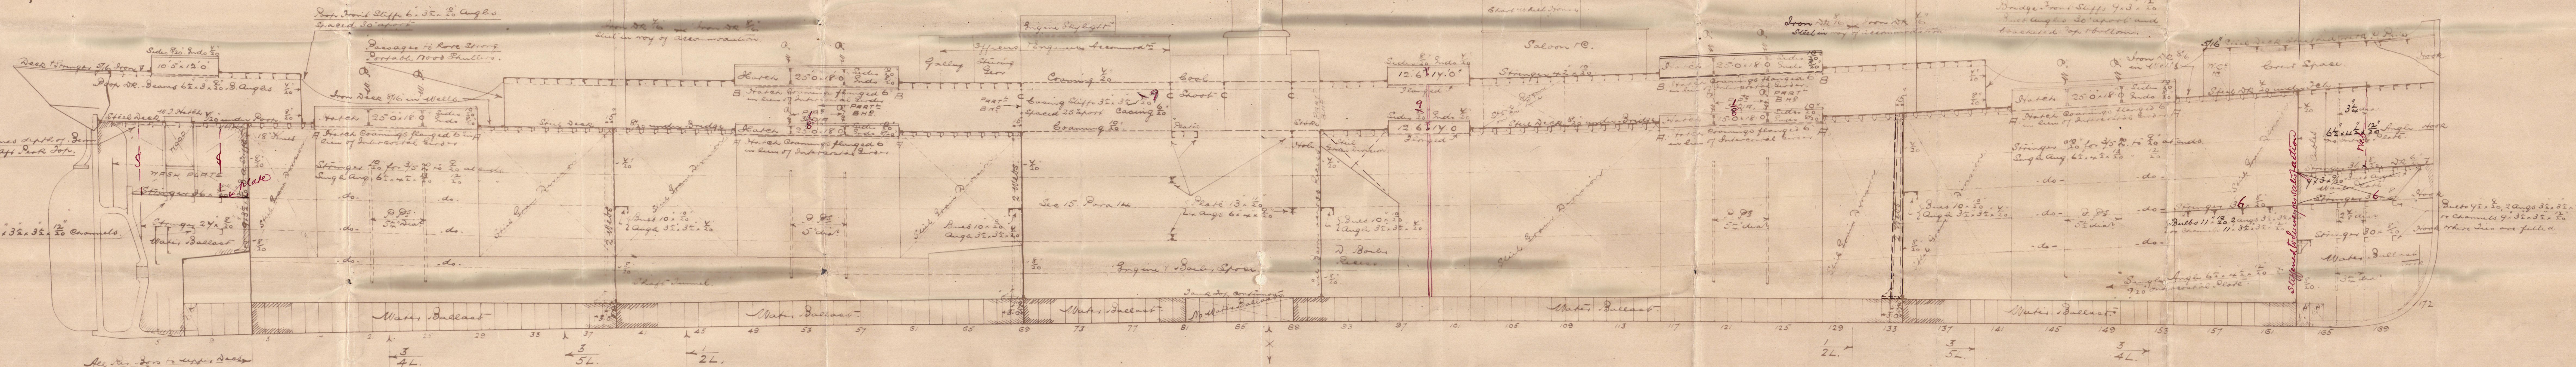

717.

717.


W. Gray Cos

no 417

Profile

" Cameron "

Wpl Report no. 12694

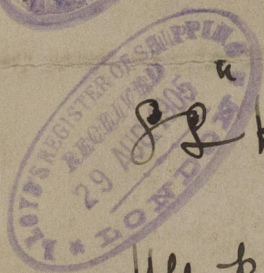

" J. S. Harberley "

Wpl Rpt no 12843

RETAIN

© 2011



Lloyd's Register
Foundation

W664-0180