


# S.S. „St. ALBANS ABBEY”.

Capacity Plan 1 : 200.

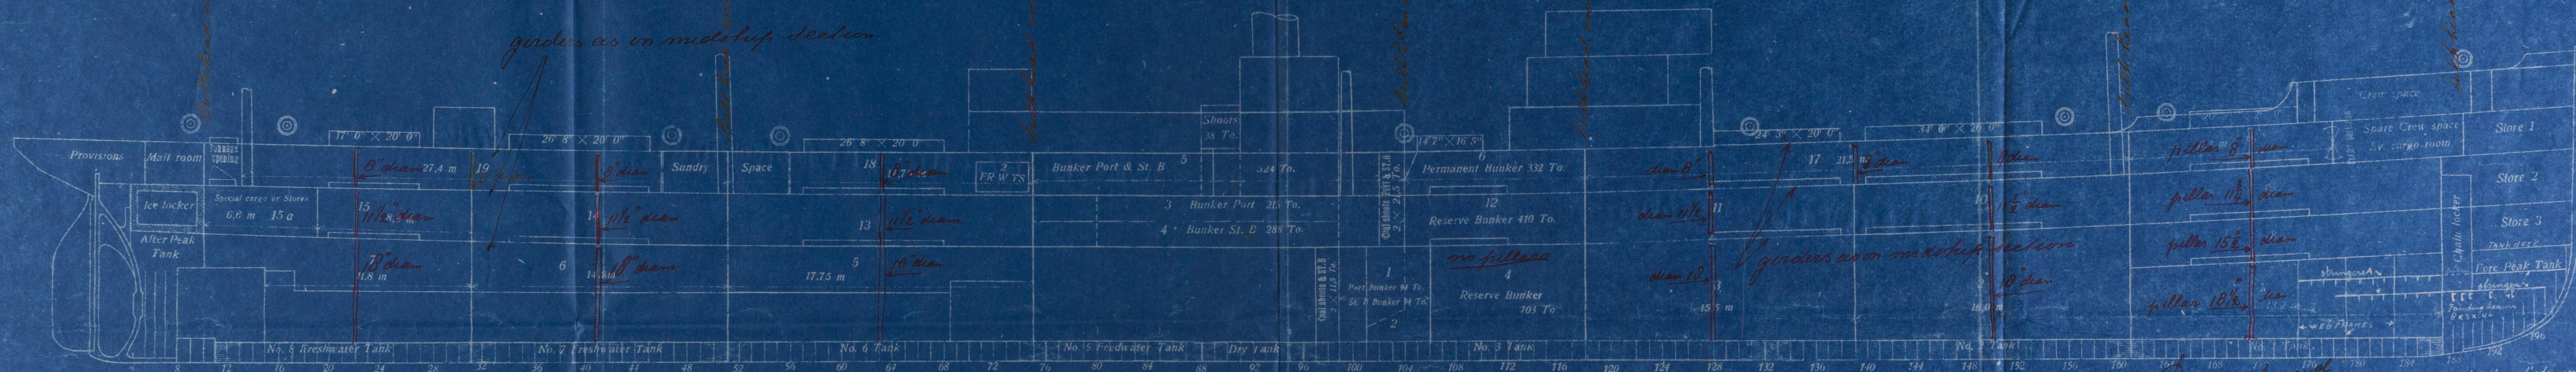

## Dimensions.

Length over all	489' 1"
between Perpendiculars	471' 0"
Extreme Breadth on frames	60' 10"
Depth moulded to Shelterdeck	39' 3"
Depth of Hold to Maindeck	28' 8"
Tonnage Gross	7399
Nett	4617
Deadweight inclusive Bunkers	12000 Tons
Draft I. S.	27' 14"
" S.	26' 7 1/2"
" W.	26' 14"
Triple expansion Engines HP	3700
Speed when loaded.	12 Knots

Wireless Telegraphy.

Holds	Grain cbf.	Bale cbf.	Store-Rooms	Bale cbf.
1 No. 1 Hold	34,300	31,500	Provision Room	6,000
2 " 2	67,300	61,900	Mail Room	1,410
3 " 3	61,600	56,530	Tonnage opening	2,970
4 " 4 Reserve Bunker Hold	34,400	31,600	Sundry Space	6,360
5 " 5 Hold	59,900	55,000	Ice Locker	1,480
6 " 6	47,300	43,500	Fore Peak-Store 1	1,760
7 " 7	24,100	22,100	" " 2	1,870
8 " 1 Lower Tweendeck	18,500	17,000	" " 3	1,480
9 " 1 Upper	25,000	22,950	Total Store Rooms	23,000
10 " 2 Tweendeck	30,350	27,820		
11 " 3	30,100	27,600		
12 " 4 Reserve Bunker Tweendeck	20,060	18,400	Winches and Derricks.	
13 " 5 Tweendeck	34,300	31,500	10 Winches, 7" x 12", Single Gear	
" 6	27,700	25,400	4 " 8" x 14", Double	
" 7	14,200	13,050	2 Derricks, 3 Tons Lifting capacity	
15a " 7 Bullion Room Tweendeck	7,350	6,800		
16 " 1 Shelter Tweendeck	16,350	15,000		
17 " 2 and 3 Shelter Tweendeck	50,000	45,840		
18 " 5	21,300	19,900		
19 " 6 and 7	36,700	33,700		
	660,810	606,600		

Permanent Bunkers	Tons of 45 cbf.	Reserve-Bunkers	Tons of 45 cbf.
Bunker 1	94	No. 4 Hold (4)	703
" 2	94	" 4 Tweendeck (12)	410
" 3	215	Total	1,113.0
" 4	286		
" 5	524		
" 6	332		
Shoot Port	11.5		
St.-B.	11.5	Permanent Bunkers	To.
Shoot Port	21.5	Reserve-Bunkers	1,113
St.-B.	21.5	Total	2,760
Shoots	38		
Total	1,647.0		

Waterballast	Tons	Freshwater	Tons
Tank 1	162	Tank 5 Feedwater	148
" 2 St.-B.	170	" 7 Freshwater	200
" 2 Port	170	" 8	94
" 3 St.-B.	222	2 F.W. T. in Sh.-D. & 15 To.	90
" 3 Port	222	Total Freshwater	470
" 4 Dry Tank			
" 5 Port Feedwater	73		
" 5 St.-B.	73		
" 6 St.-B.	153		
" 6 Port	153		
Total double bottom Tank	1,510		
Fore Peak Tank	90		
After Peak Tank	22		
Total Waterballast	1,510		

Draft Feet	Dead- weight Capacity Tons
28	12,940
27	12,250
26	11,550
25	10,850
24	10,150
23	9,500
22	8,820
21	8,140
20	7,450
19	6,800
18	6,100
17	5,400
16	4,820
15	4,150
14	3,500
13	2,850
12	2,200
11	1,550
10	900
9	250
8	

LR

10-100-101-102



S/s "Arendskerck"

Rott 12189

*Capacity plan*

RETAIN



© 2021

Lloyd's Register  
Foundation

W664-0266