
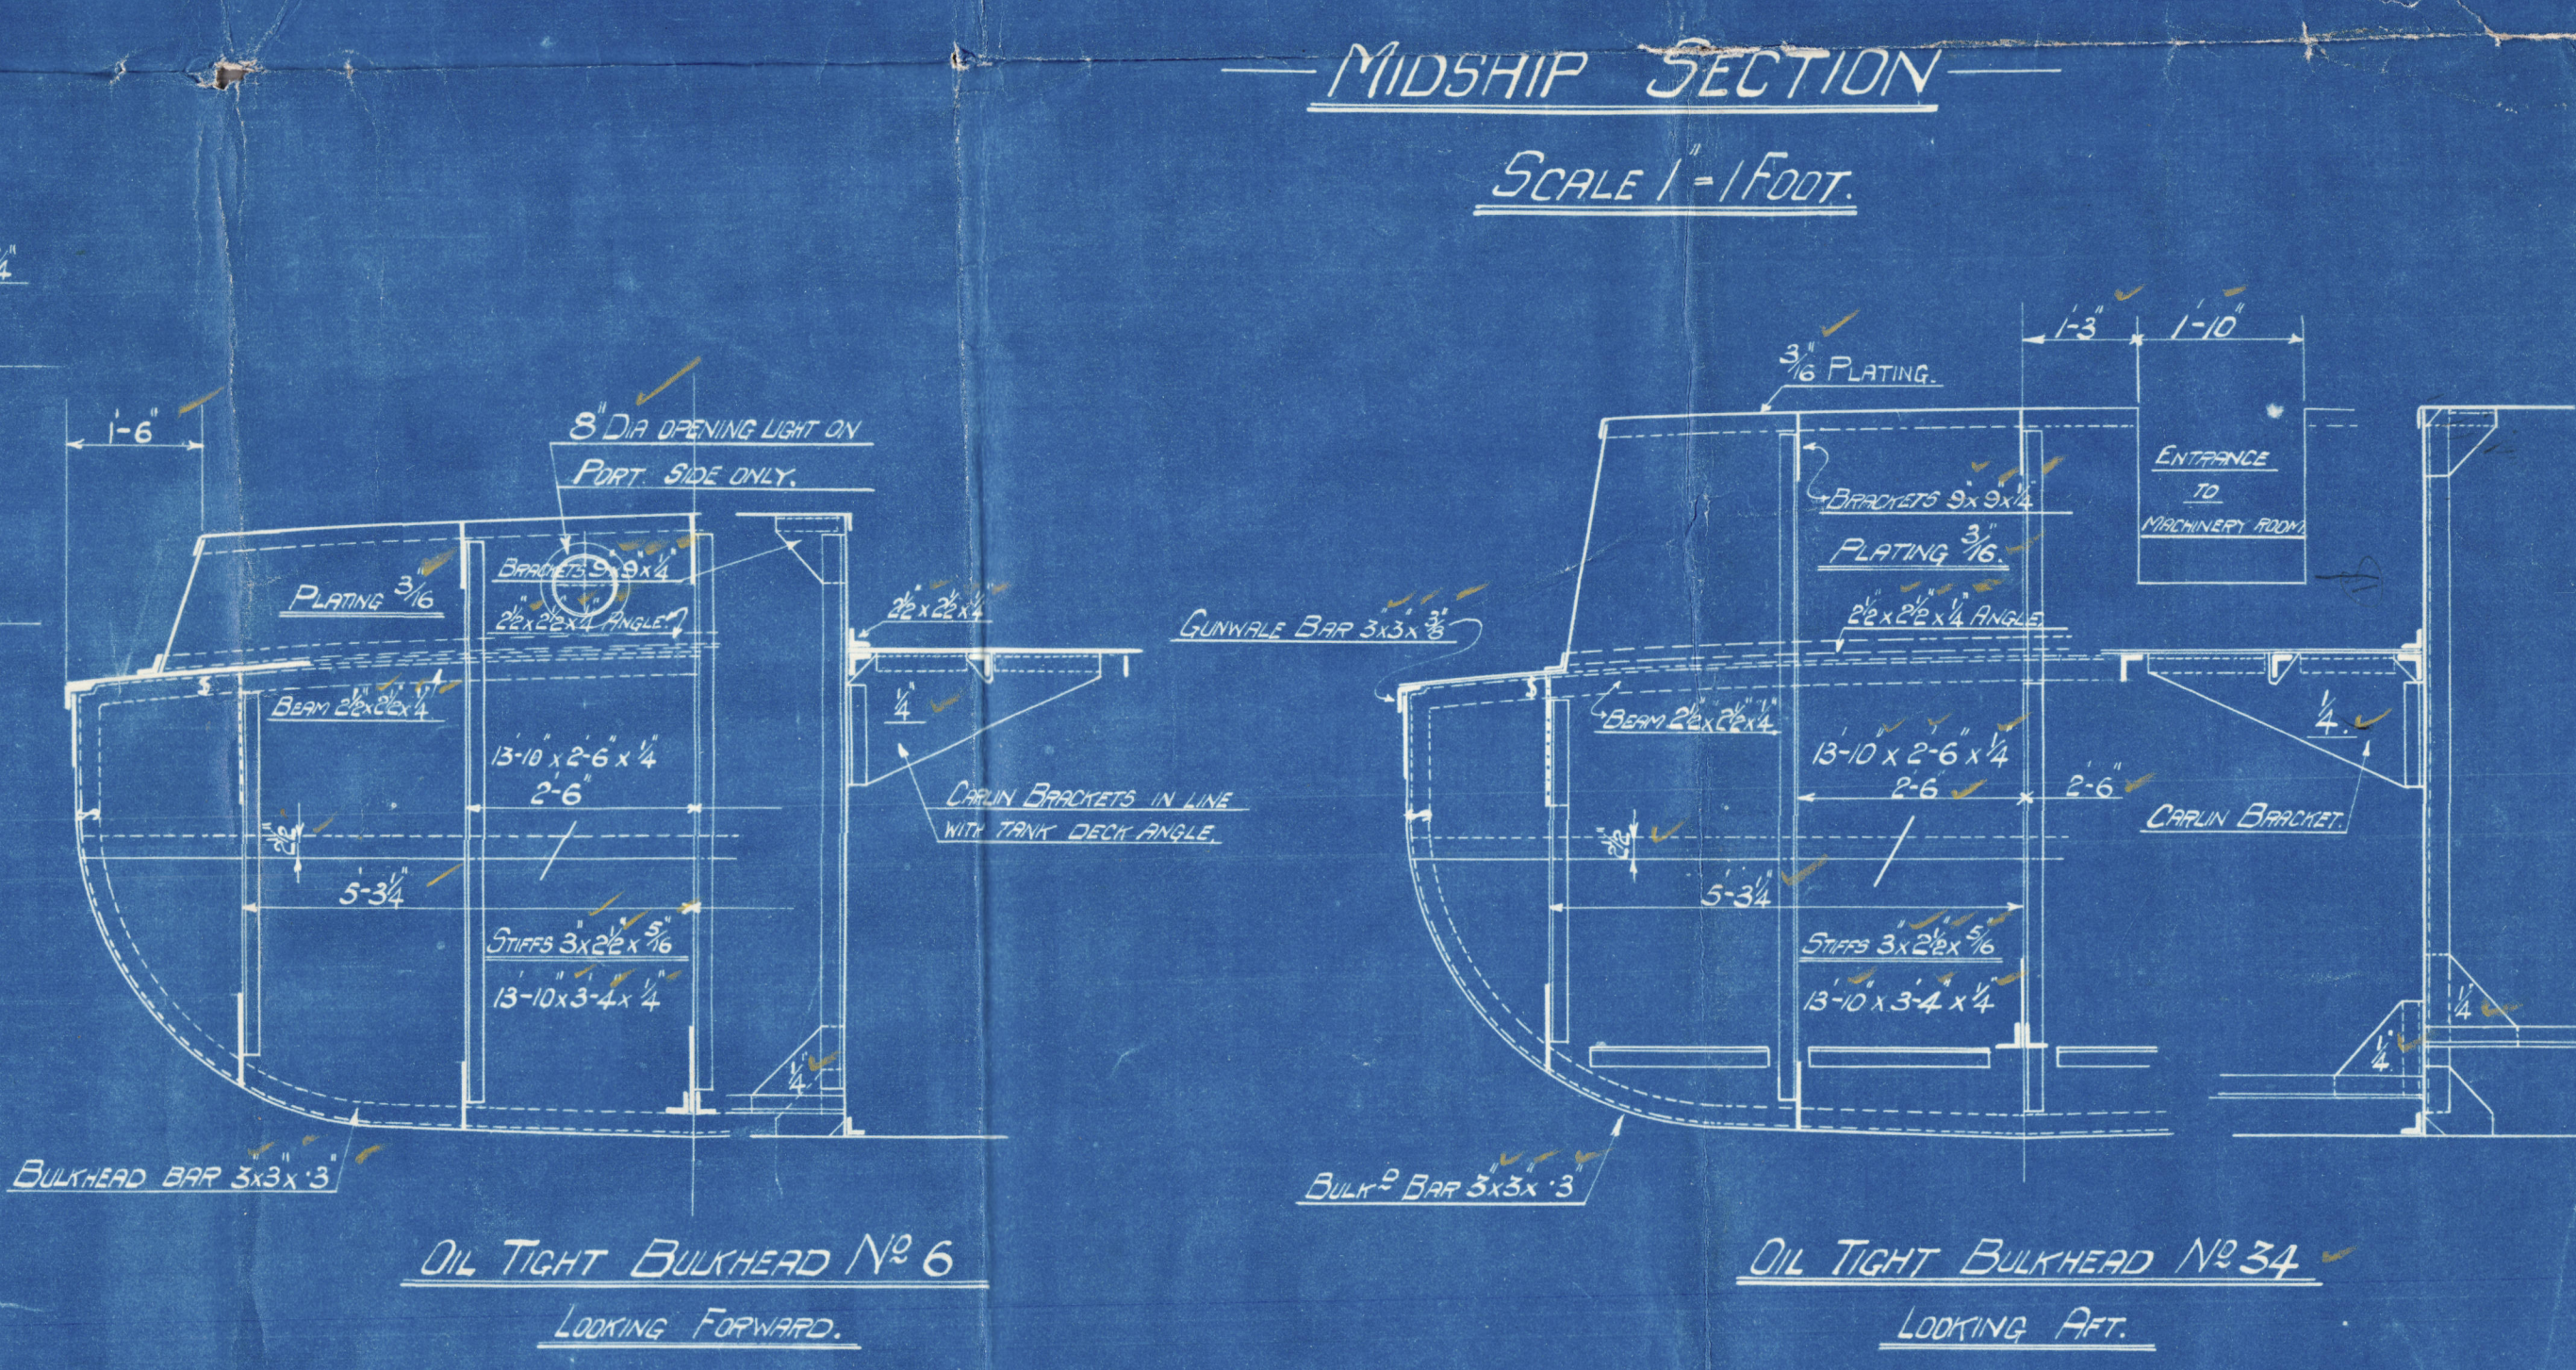
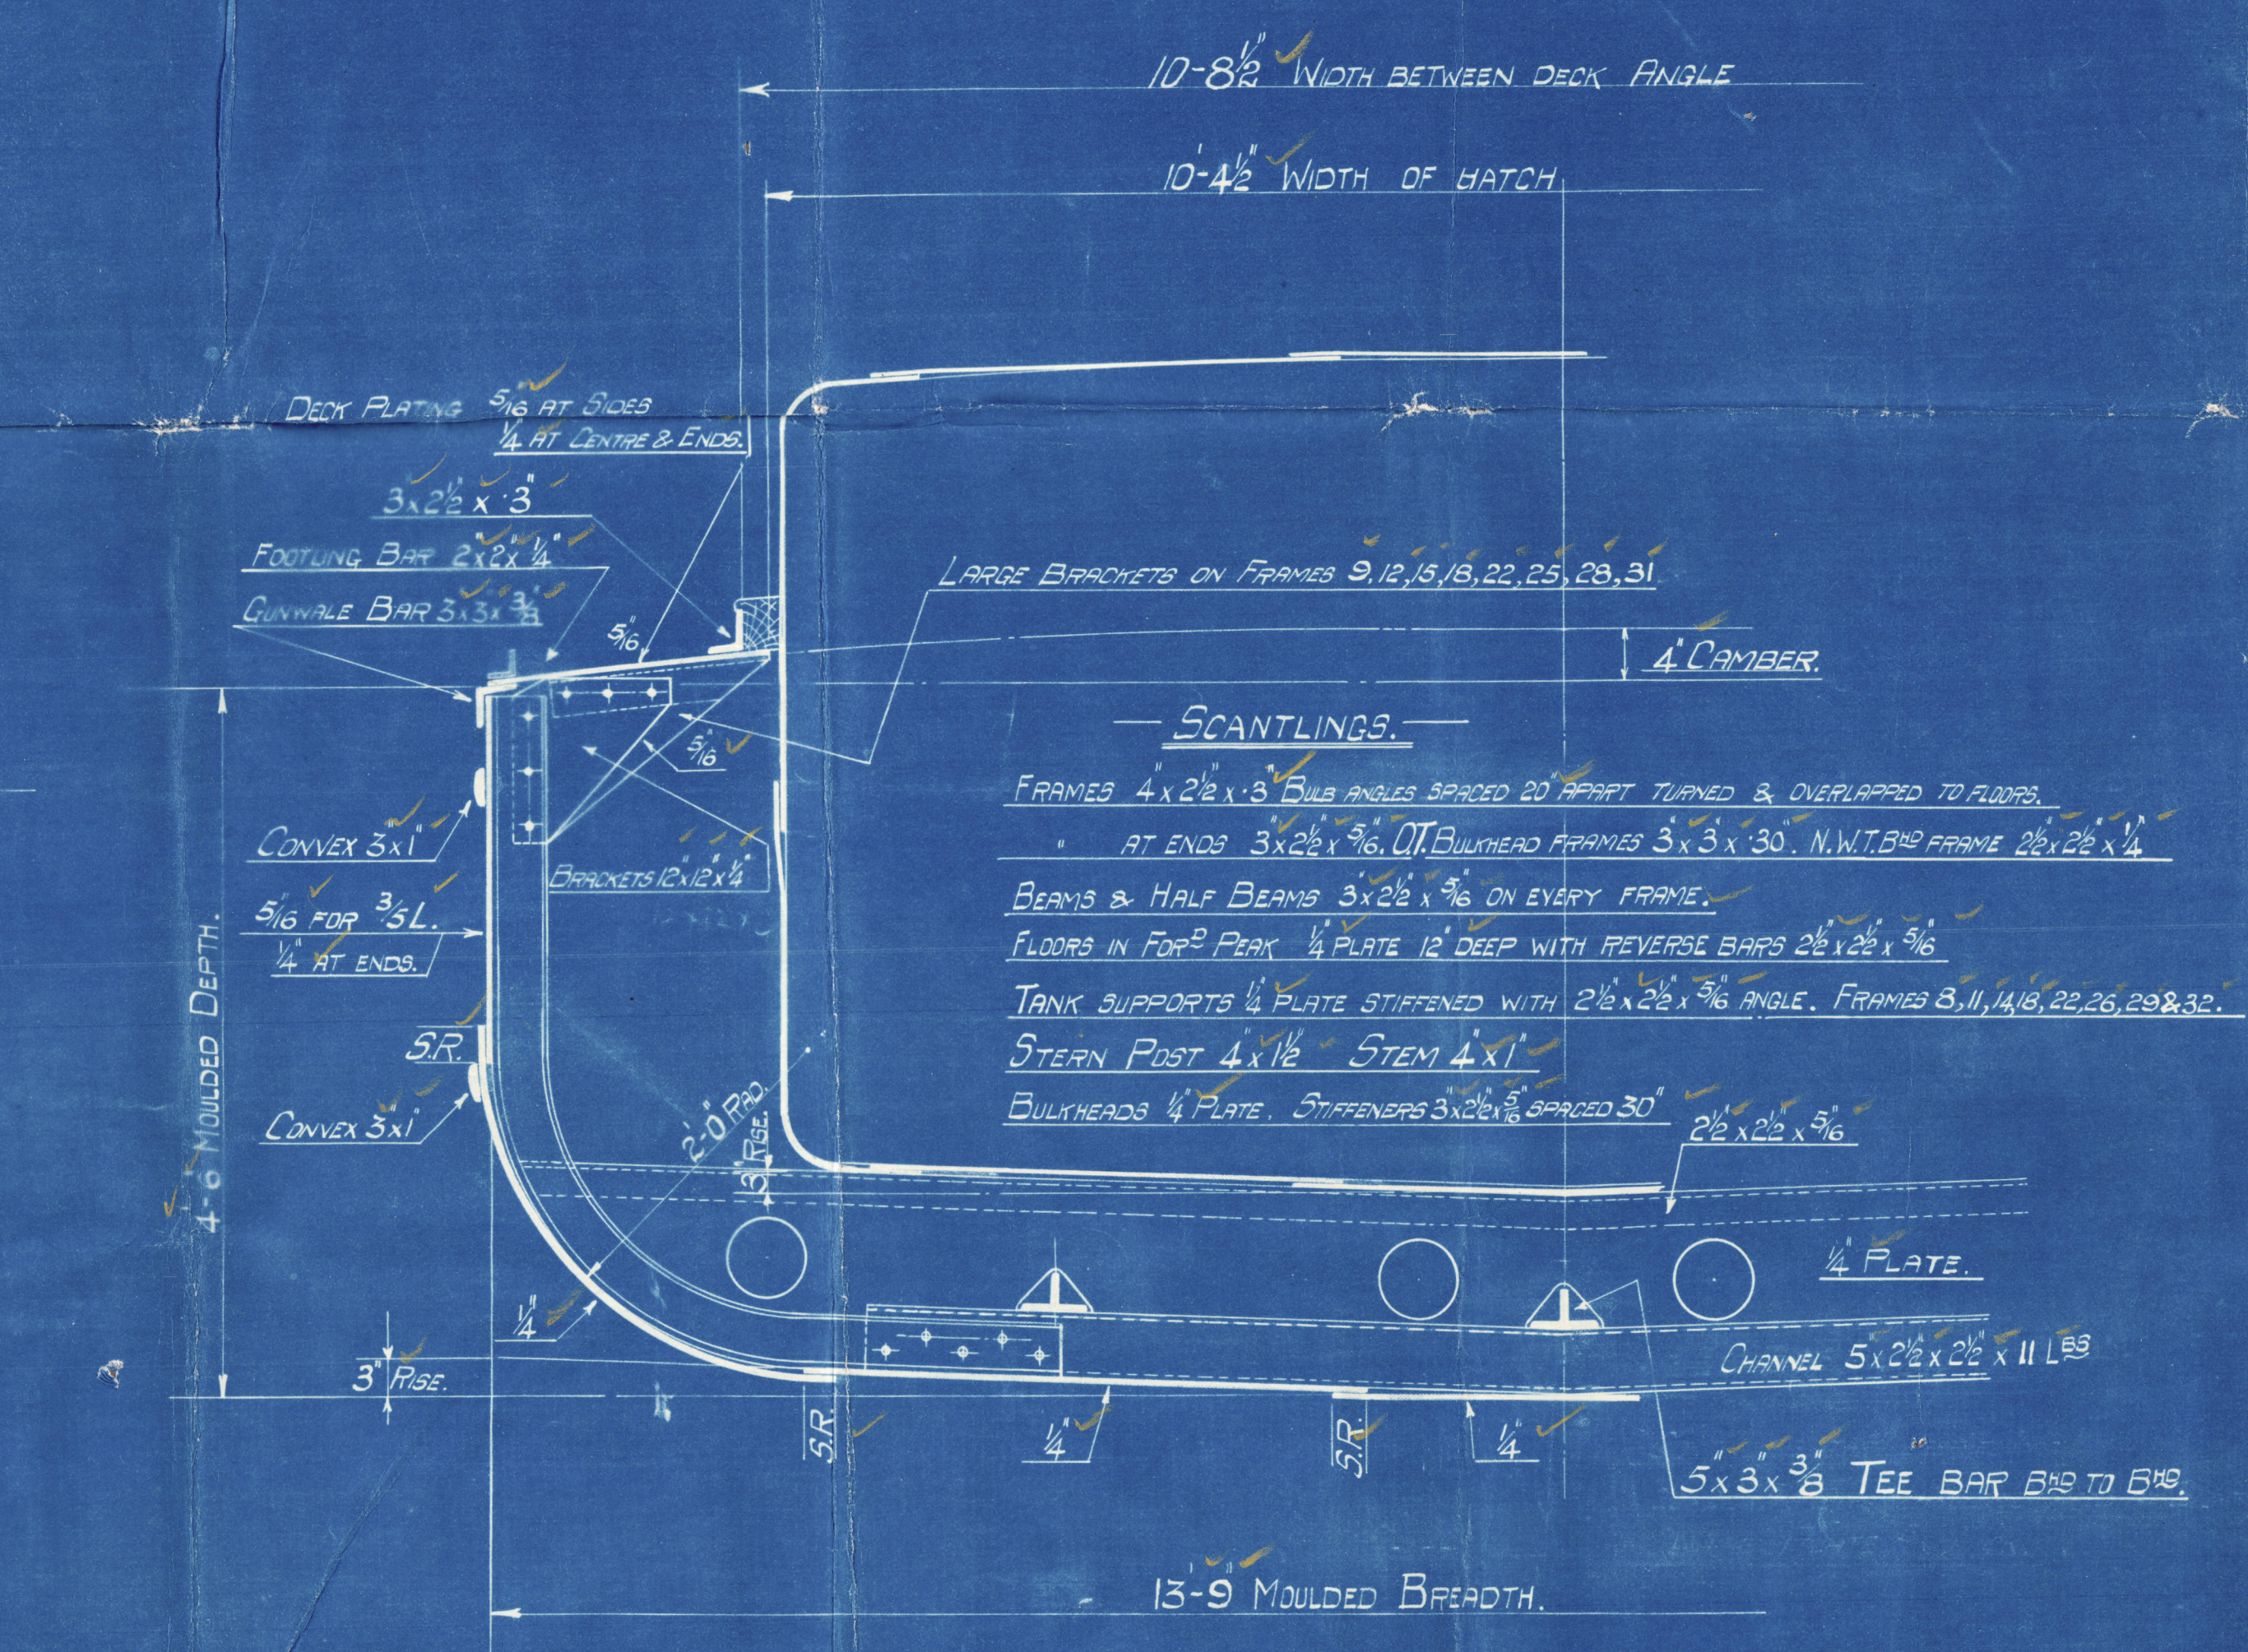
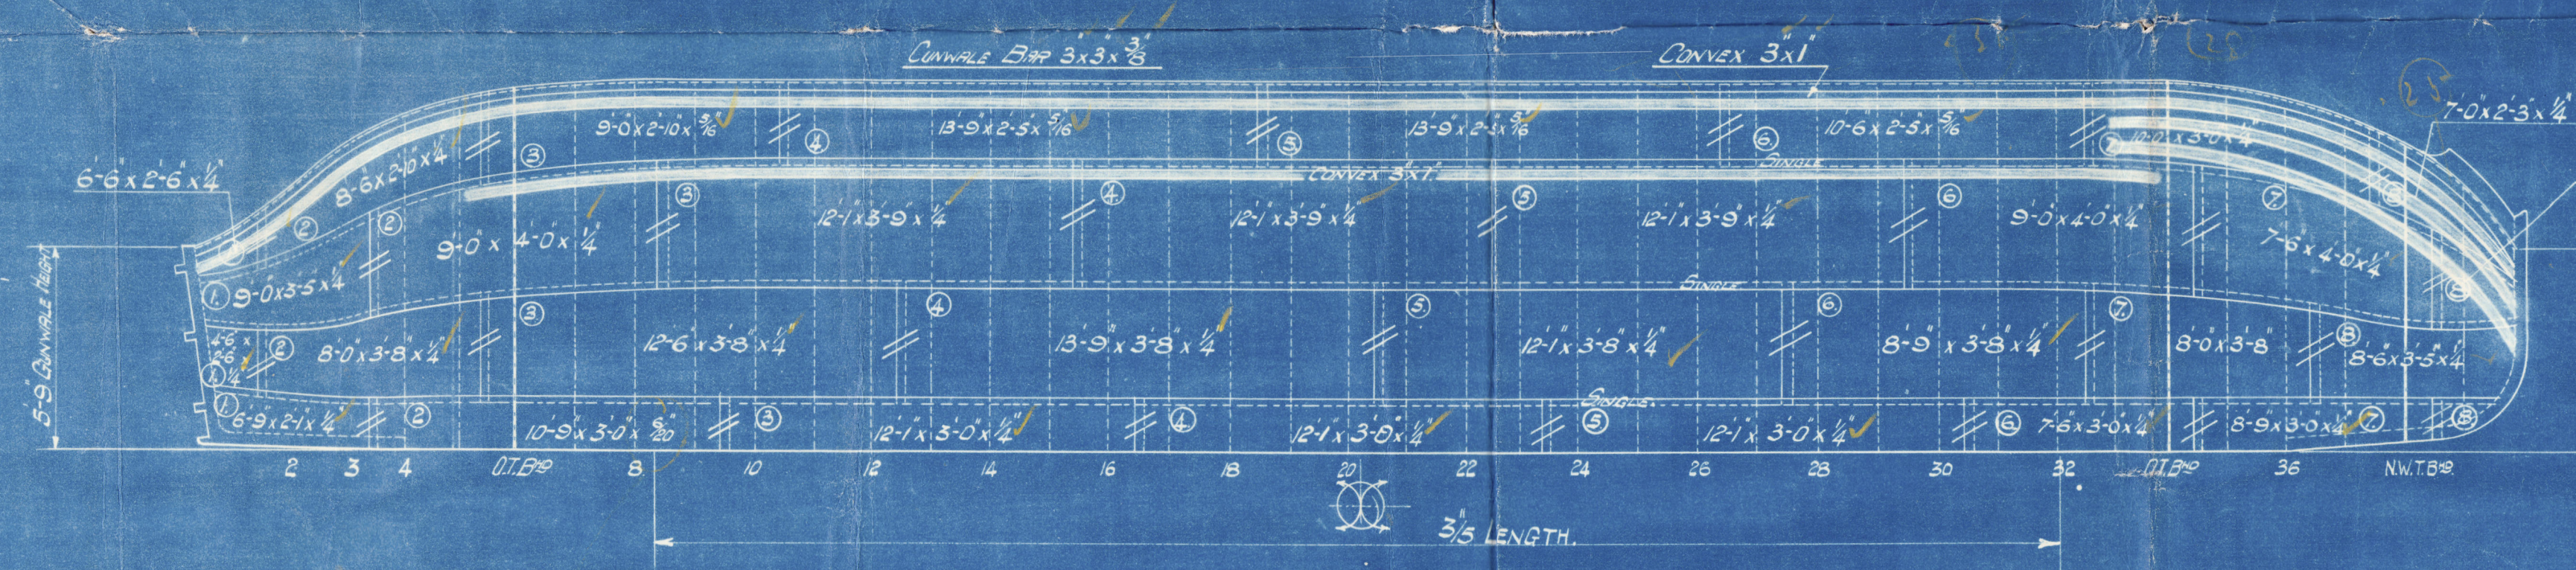
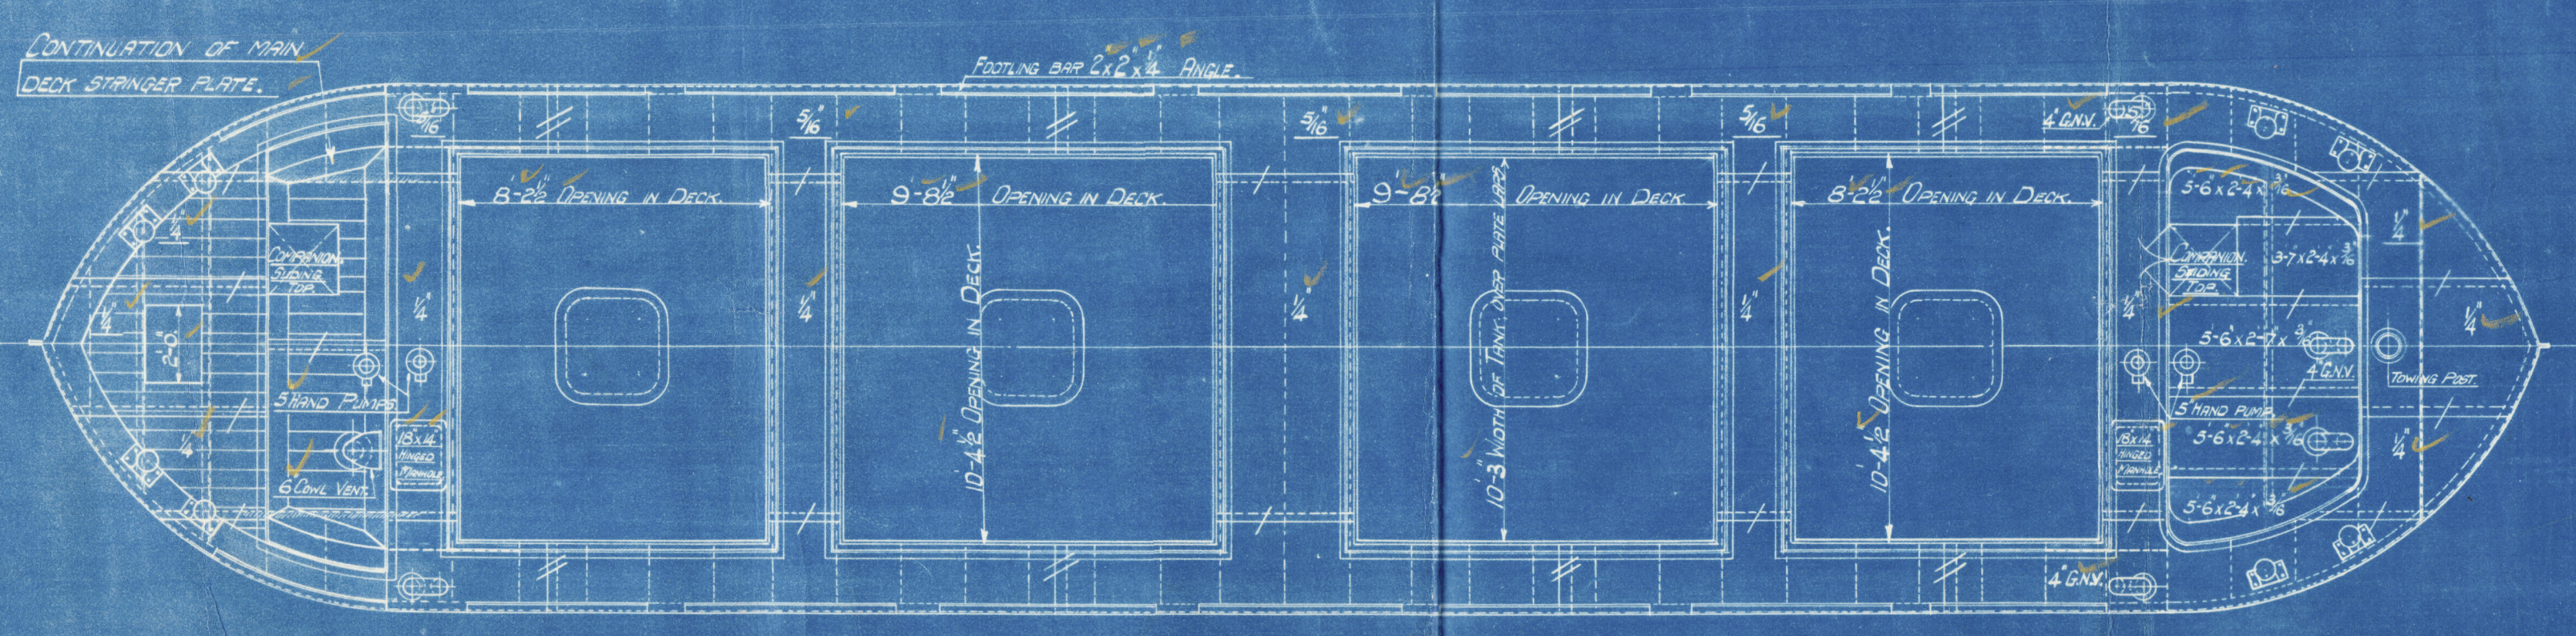


116/157

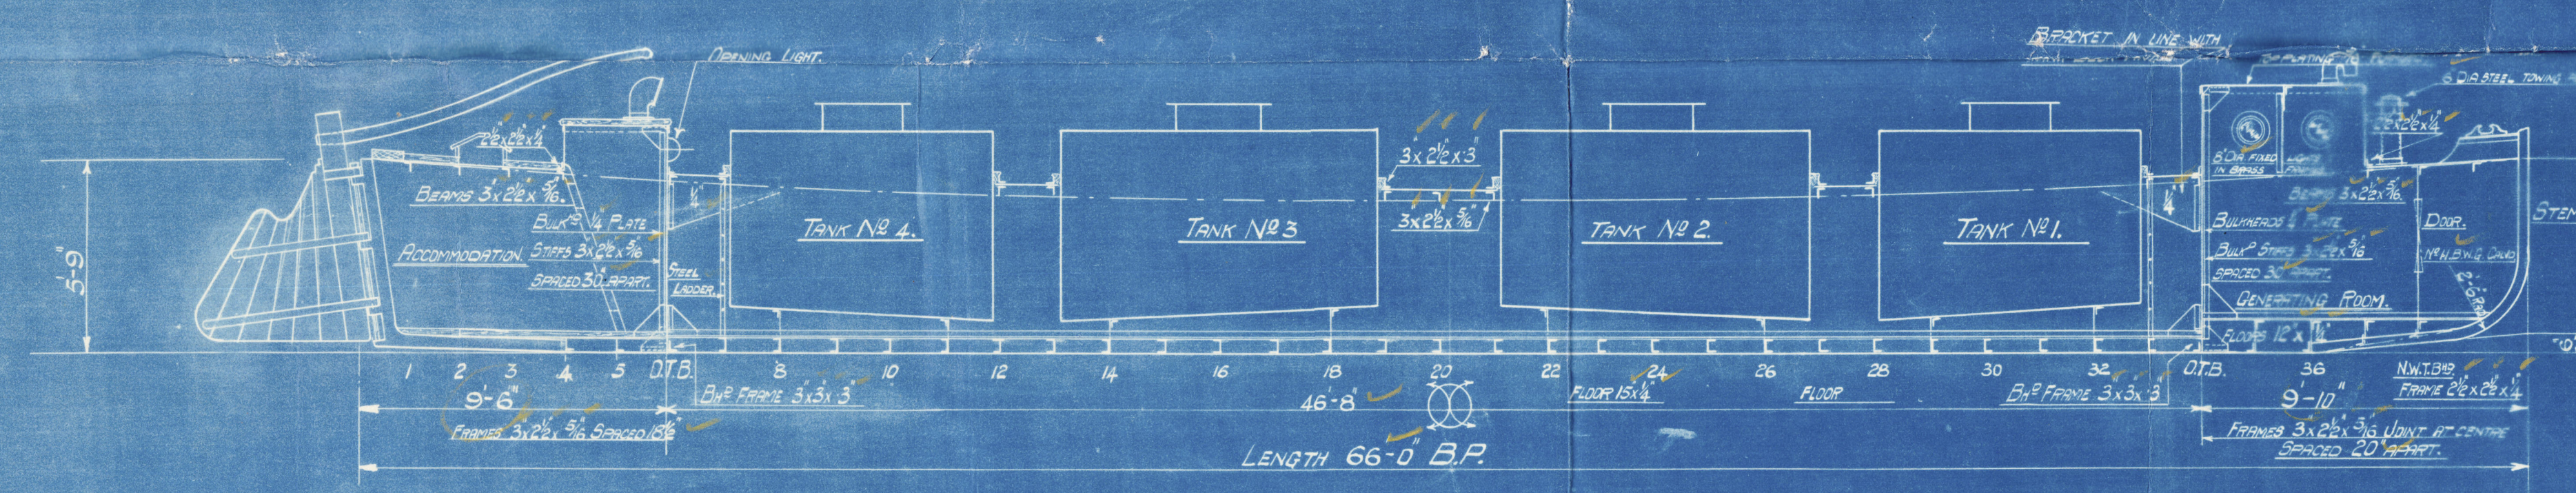

SCANTLING PLAN FOR SPIRIT TANK BARGE.
SCALE 1/4" = 1'-0"

PRINT No 6876
Date 5-9-27

W. J. YARWOOD & SONS LTD
ENGINEERS AND
BOILER MAKERS
THE DOCK, NORTHWICH

W. J. YARWOOD & SONS LTD
ENGINEERS AND
BOILER MAKERS
THE DOCK, NORTHWICH
11-2-27
DRG No 2555
DRAWN BY
CHECKED BY
INDEXED BY

11664-0251

Messrs W. J. Yarnood's
Steel Dumb Barge
P.M.S. P & D
Leantling Plan

No 310

S. S. British Girl

LIVERPOOL:

Report No. 93010



© 2021

Lloyd's Register
Foundation

W6640281