



29.1.07
6.2.07


MIDSHIP SECTION S.S. No 403.

DIMENSIONS AS PER RULE

LENGTH 357.16
BREADTH (INCLUDED) 47.33
DEPTH (AT CENTER) TO MAIN DECK 28.66
MAIN 18.70

Class 100 A.1. Spar Deck

JOHN READHEAD & SONS,
SHIPBUILDERS,
SOUTH SHIELDS.

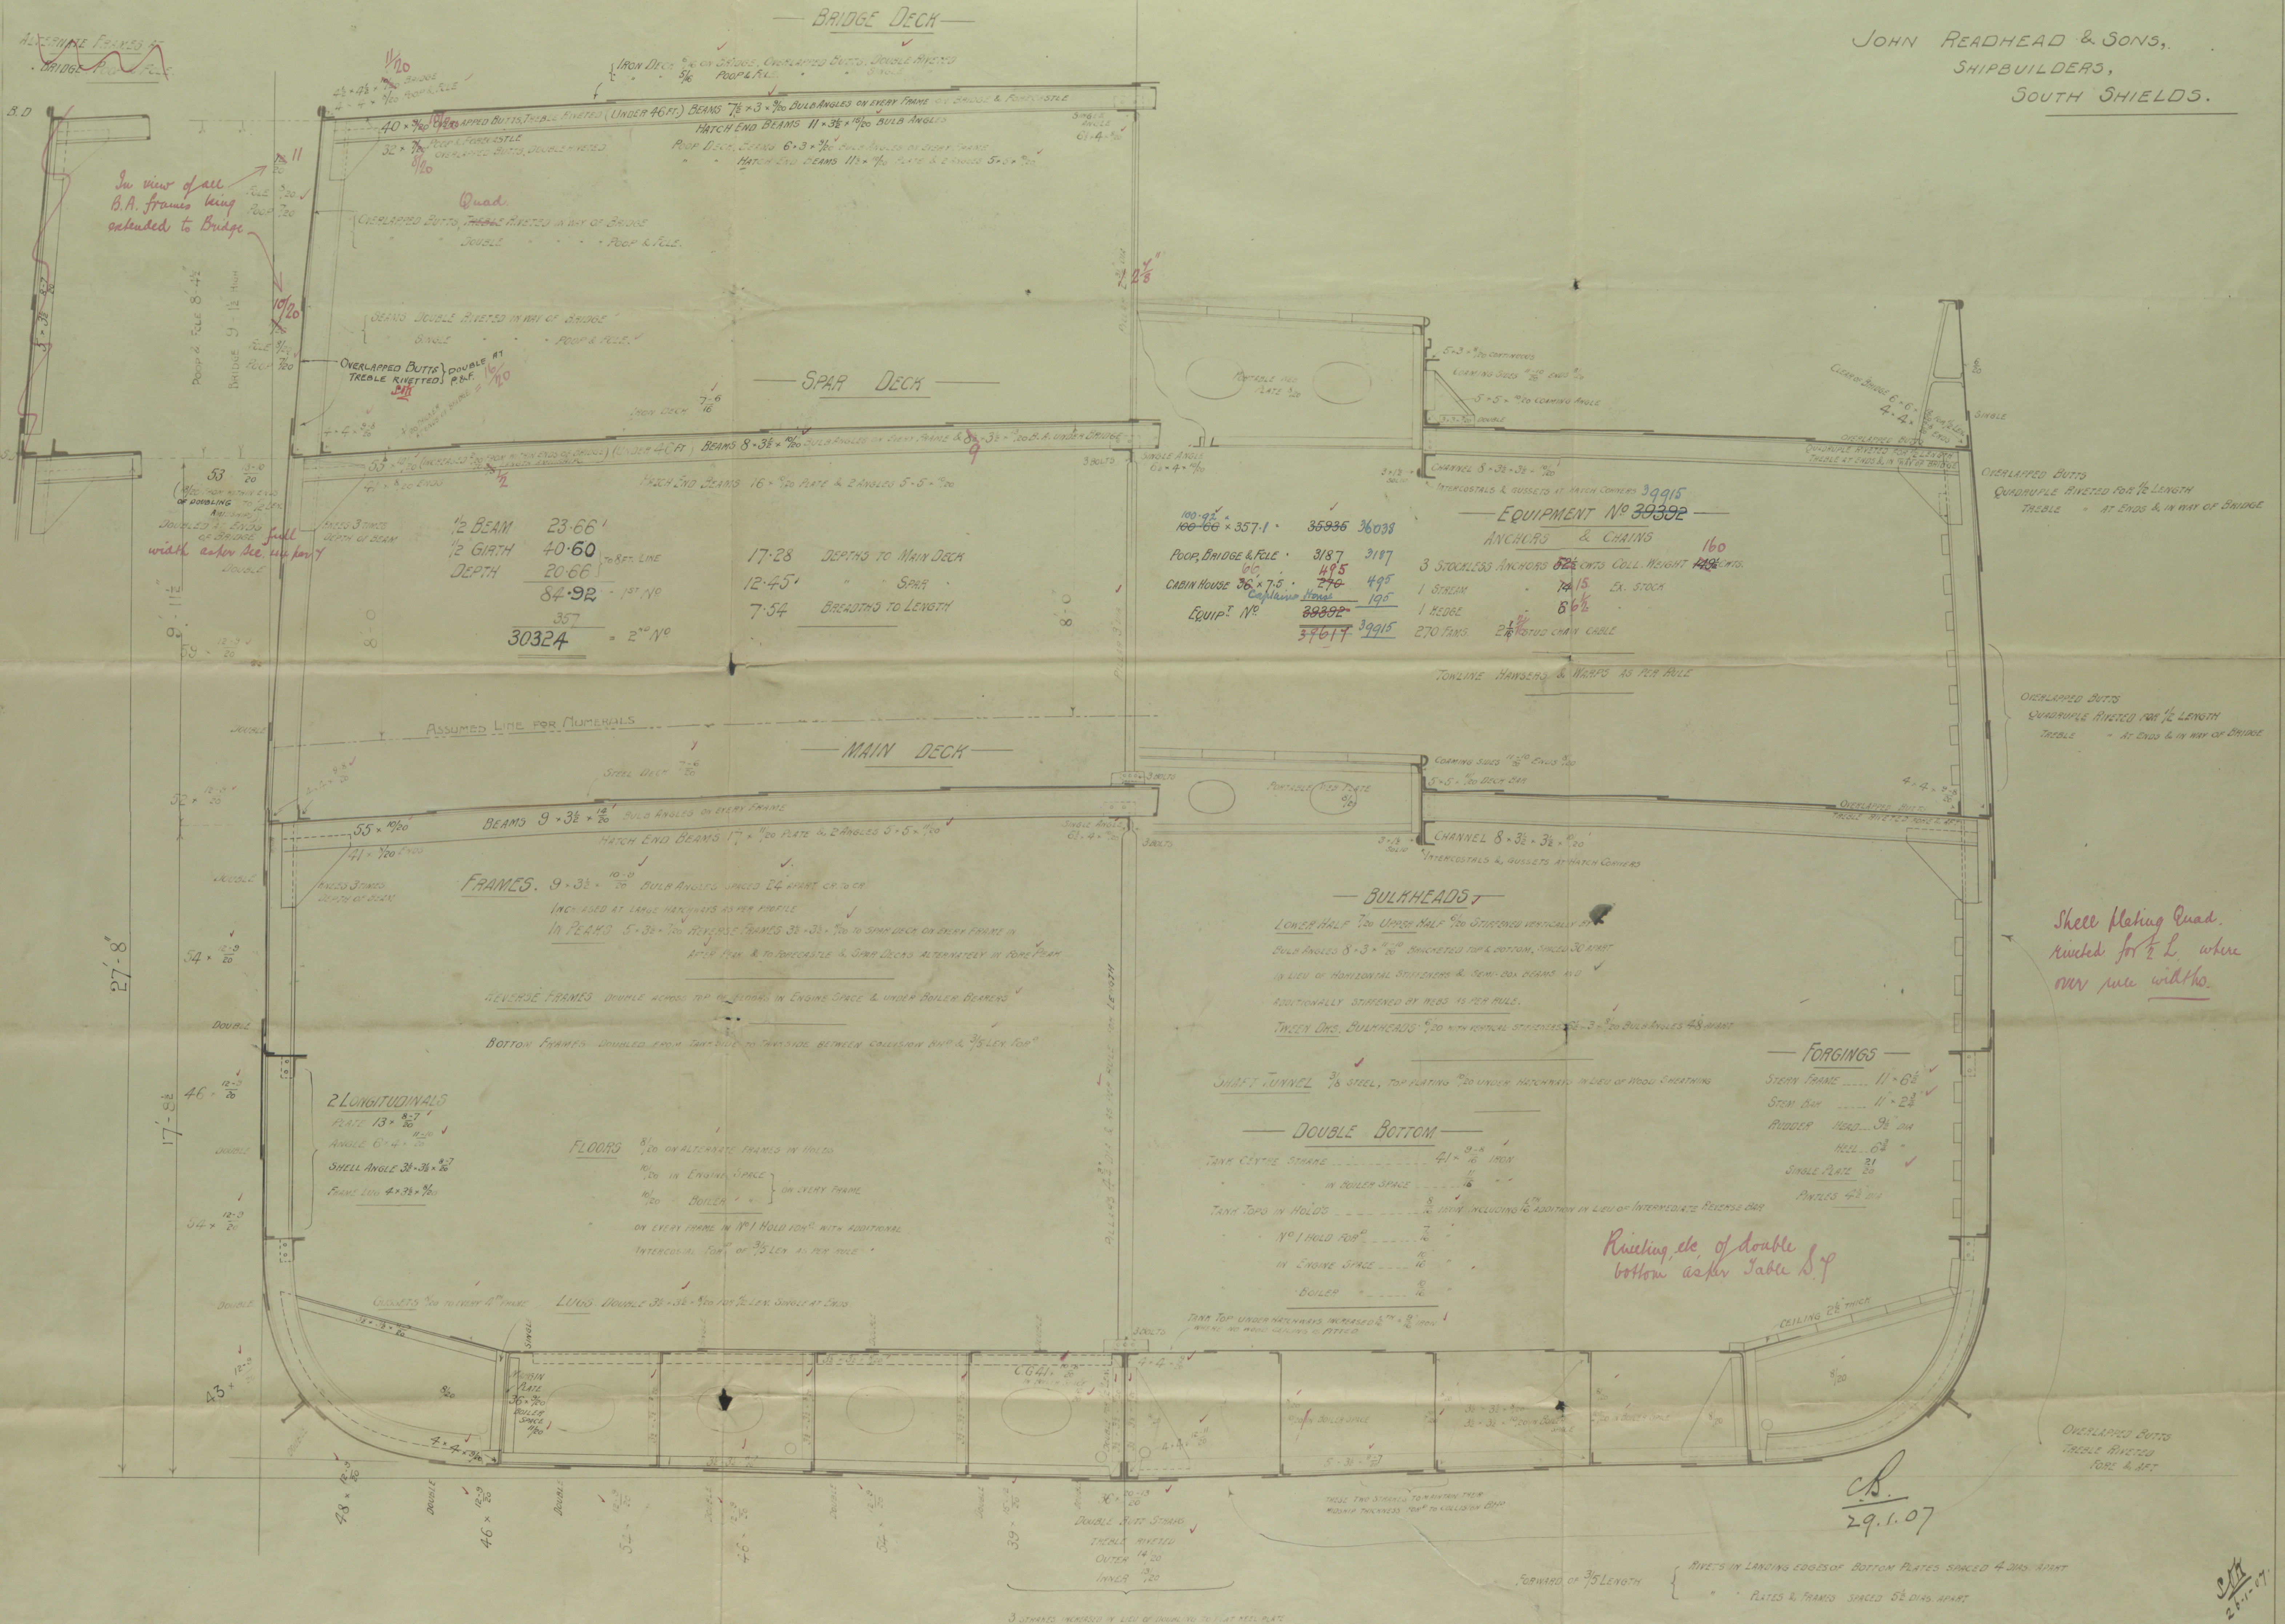

Newcastle.

Messrs. John Readhead & Sons,


S. S. No. 403.

Midship Section.

J. I. Spheroid.

Newcastle Post
No 535654

RETAIN

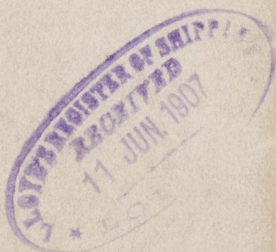

© 2020

Lloyd's Register
Foundation

W665-0078