
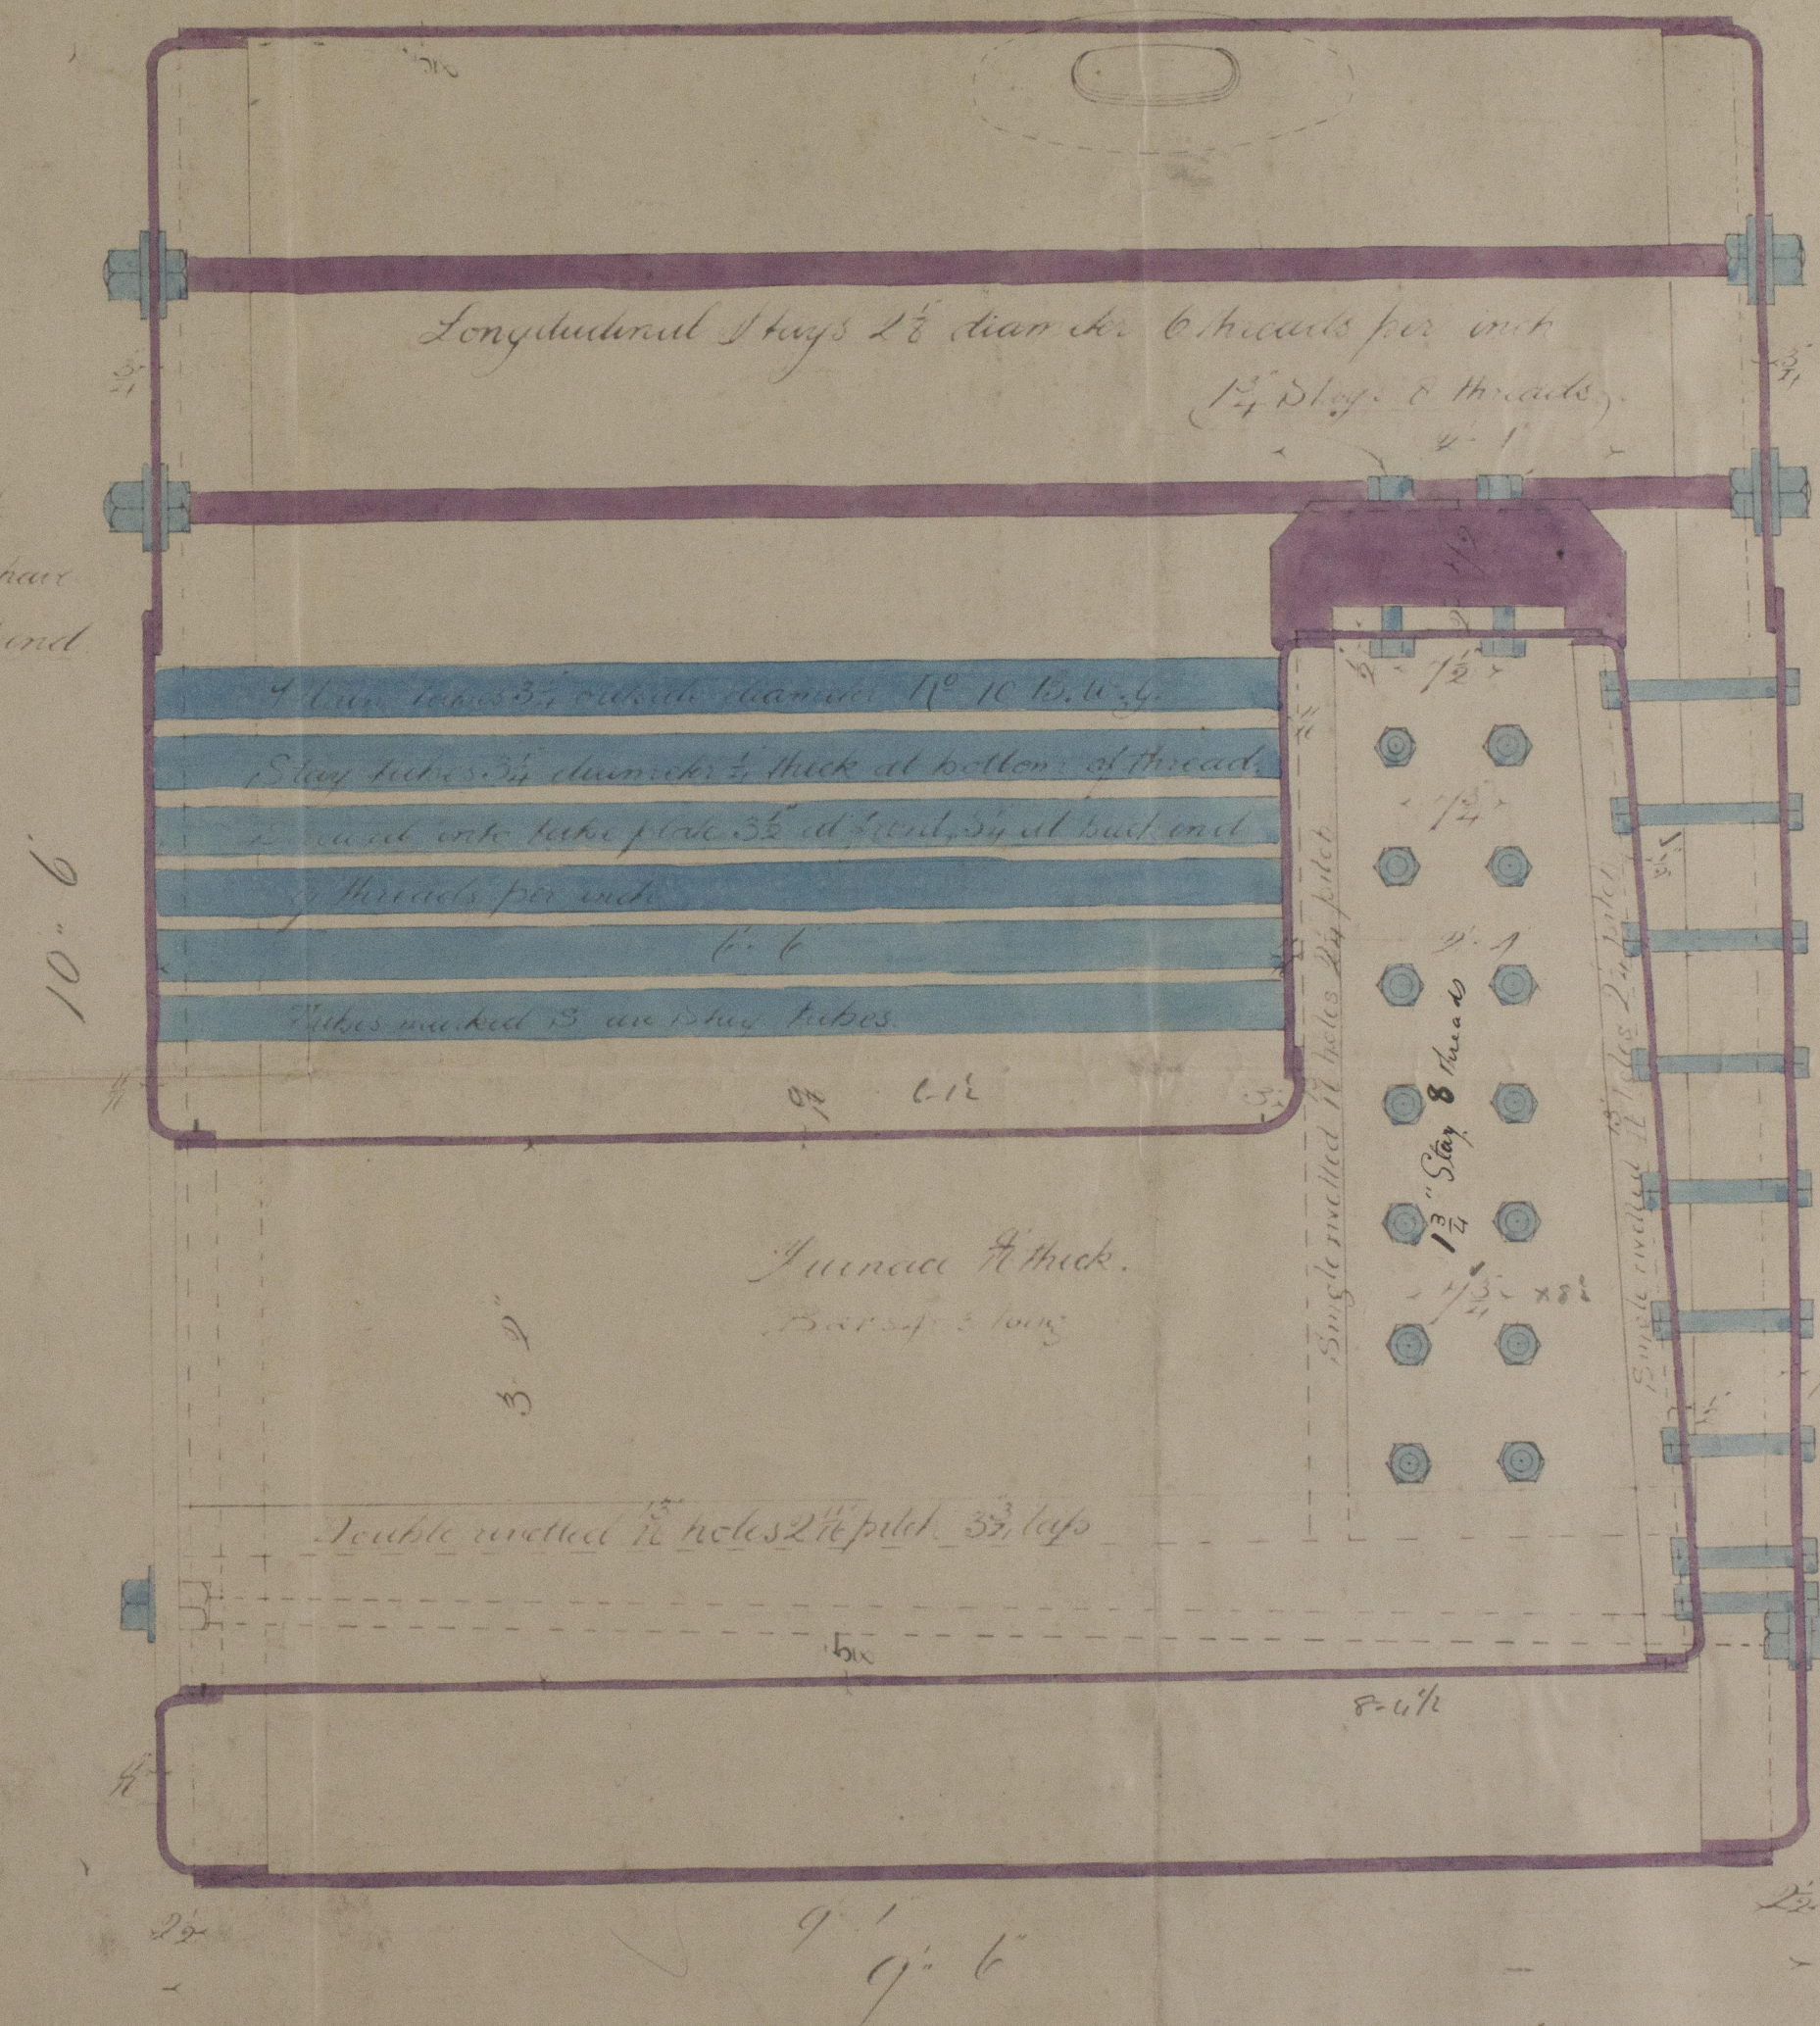


EXACT DUPLICATE OF 387 SHIP. DONKEY BOILER.

Working pressure 80 lbs per sq inch
Test " " " " " "

Mantle 12 x 16 covering plate Swich x 2
Double ended 3 pilot

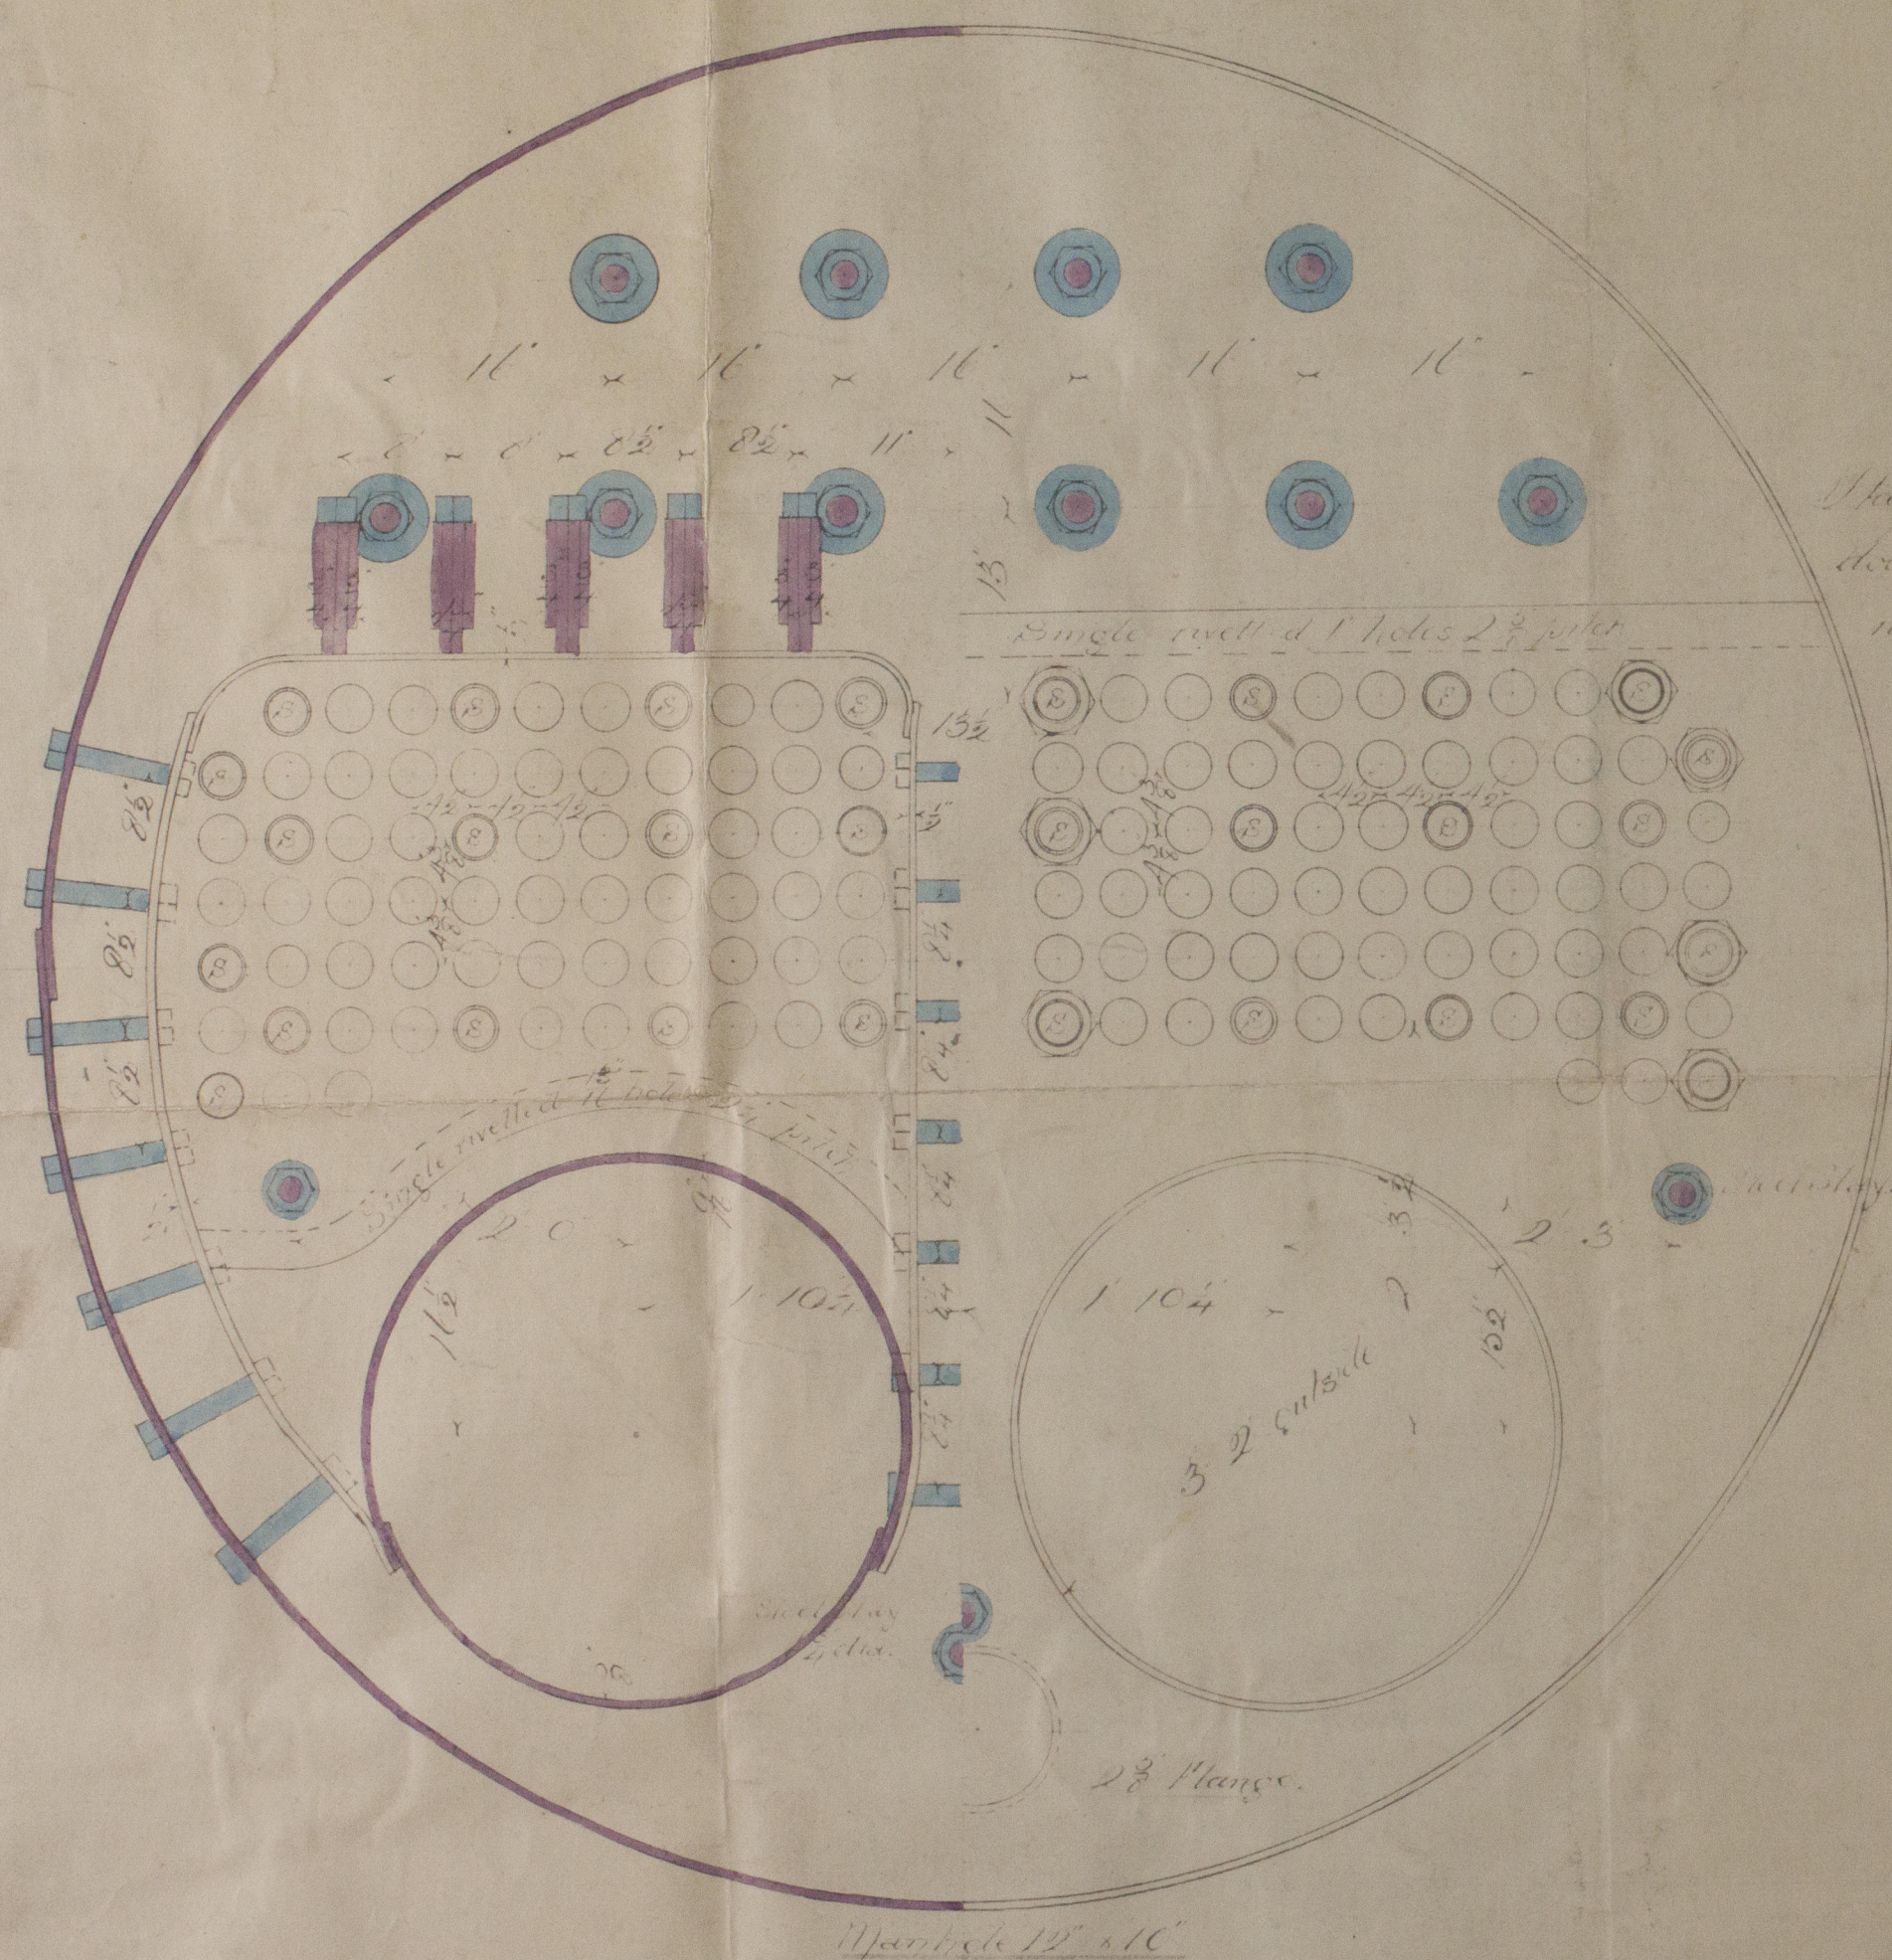

DONKEY BOILER SHIP N^o 403

JOHN READHEAD & SONS
Engineers, Boiler Makers,
Iron & Steel Shipbuilders,
SOUTH SHIELD.


 © 2020
 Lloyd's Register
 Foundation
 W665-0080

Newcastle

MESSRS.

J. READHEAD & SONS.

DKY. BLR.

S. 403.

E. 1833.

W. P. 80765⁰


MARK.

hi. 7557
dlyas Test
160 lb
13-8-07. W.L.

J. P. Spheroid.

Newcastle Register

N^o 5356 7

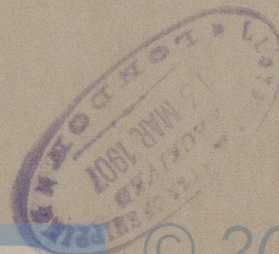

© 2020

Lloyd's Register
Foundation

W665-0080