


MIDSHIP SECTION.

SHEPWOOD SYSTEM

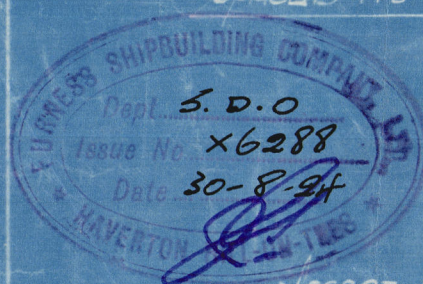

S. S. Kamloops.

Jurnes Ship & Coys No. 68

Midship Section

(as Built).

S.S. Kamloops

MDB. RPT. No. 11981

(see lab.)



© 2020

Lloyd's Register
W666-0106
Foundation