




8. 9. 03  
28. 9. 03  
30. 9. 03  
5. 10. 03  
5. 11. 03  
17. 11. 03  
20. 11. 03

# S.S. N<sup>o</sup> 416.

SCALE  $\frac{1}{8}$  = 1 FOOT.

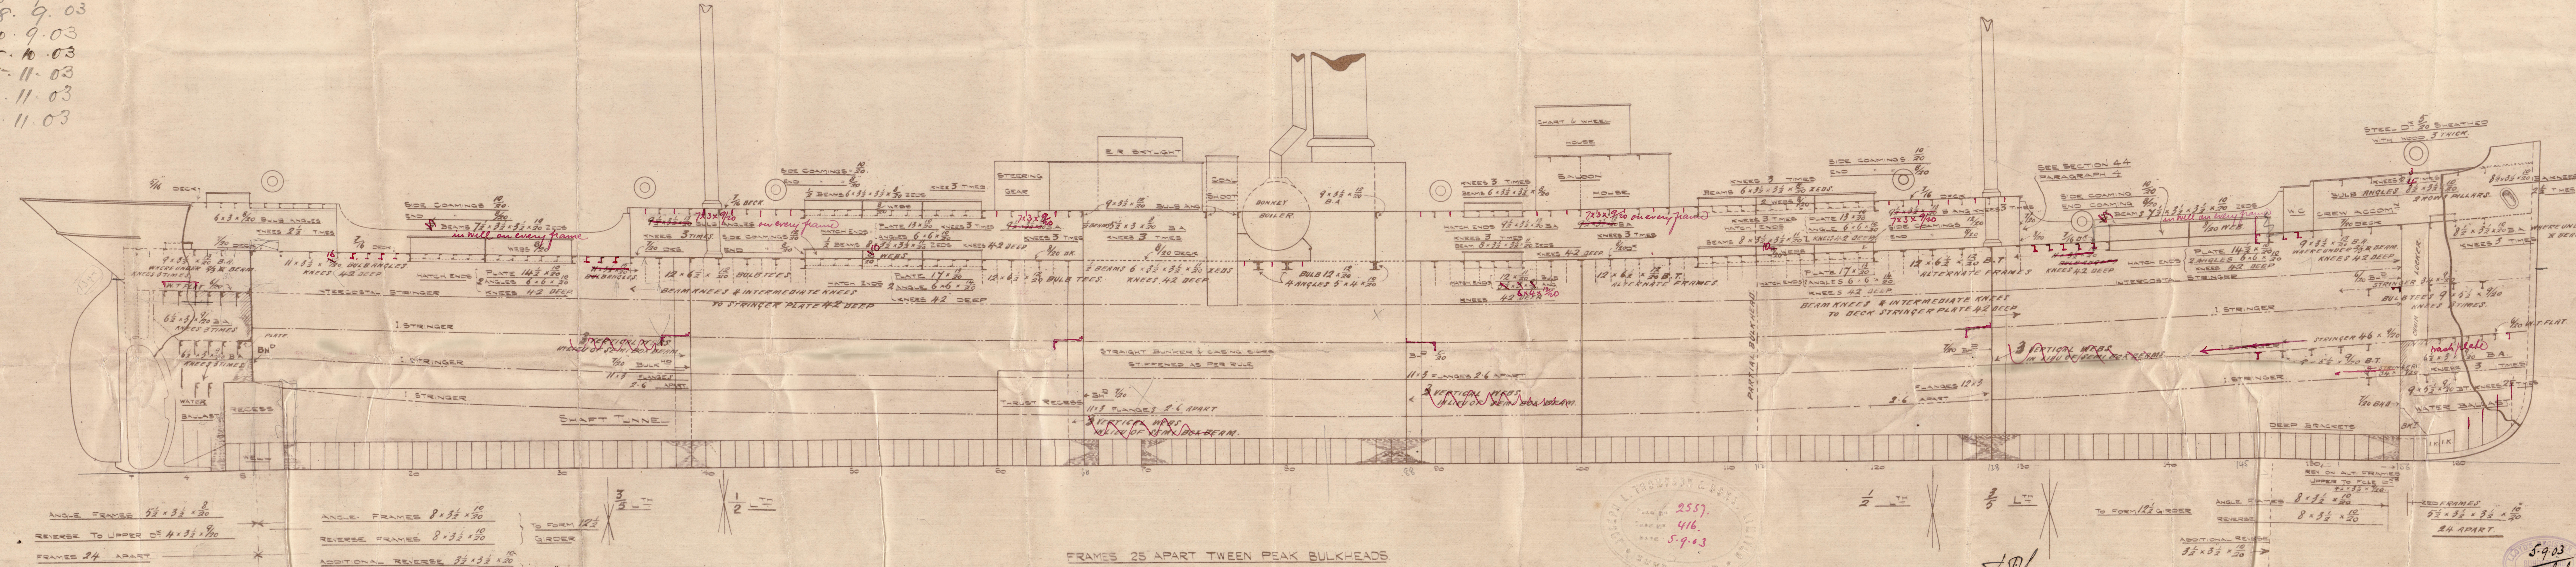

ANGLE FRAMES  $5\frac{1}{2} \times 3\frac{1}{2} \times \frac{8}{20}$   
REVERSE TO UPPER DECK  $4 \times 3\frac{1}{2} \times \frac{8}{20}$   
FRAMES 24 APART

ANGLE FRAMES  $8 \times 3\frac{1}{2} \times \frac{10}{20}$   
REVERSE FRAMES  $8 \times 3\frac{1}{2} \times \frac{10}{20}$   
ADDITIONAL REVERSE  $3\frac{1}{2} \times 3\frac{1}{2} \times \frac{10}{20}$

TO FORM 12" GIRDER

FRAMES 25 APART TWEEN PEAK BULKHEADS.



J.P.L.  
9/10/03

ANGLE FRAMES  $8 \times 3\frac{1}{2} \times \frac{10}{20}$   
REVERSE  $8 \times 3\frac{1}{2} \times \frac{10}{20}$   
ADDITIONAL REVERSE  $3\frac{1}{2} \times 3\frac{1}{2} \times \frac{10}{20}$

TO FORM 12" GIRDER

ANGLE FRAMES  $8 \times 3\frac{1}{2} \times \frac{10}{20}$   
REVERSE  $8 \times 3\frac{1}{2} \times \frac{10}{20}$   
ADDITIONAL REVERSE  $3\frac{1}{2} \times 3\frac{1}{2} \times \frac{10}{20}$

TO FORM 12" GIRDER



A. L. Thompson & Sons




Amended Profile

416

S.S. BURNHAM

Std. Ford. 21753

Std. F.E. 21770

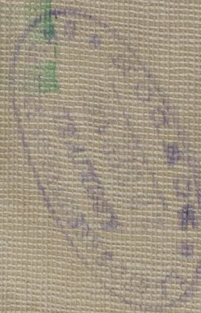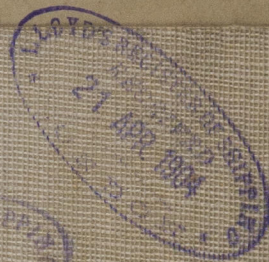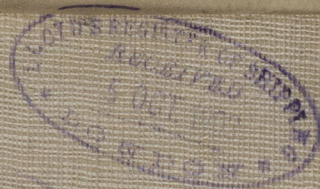

© 2020

Lloyd's Register  
Foundation