

S.S. N^o 416.

SCALE $\frac{1}{2}$ = 1 FOOT.

CLASS 100 A1 LLOYDS.

THREE DECK RULES.


HALF GIRTH 18.33
 HALF BREADTH 23.41
 DEPTH AS PER RULE 28.60
 100.34
 LESS 7.00
 23.34 FRAME 1/2
 343 LENGTH
 320.56 PLATING N^o
 34420 TWO DECK LUMBER

EQUIPMENT NUMBER
 = 37737.

Erection above bridge to be included.

PRINCIPAL DIMENSIONS
 LENGTH 345.0
 BREADTH EXT. 47.2
 MLE 46.10
 DEPTH V. 3 (UPPER D^o) 27.8

PROPORTIONS
 DEPTHS TO LENGTH (UPPER D^o) 11.99
 BREADTHS " 7.32

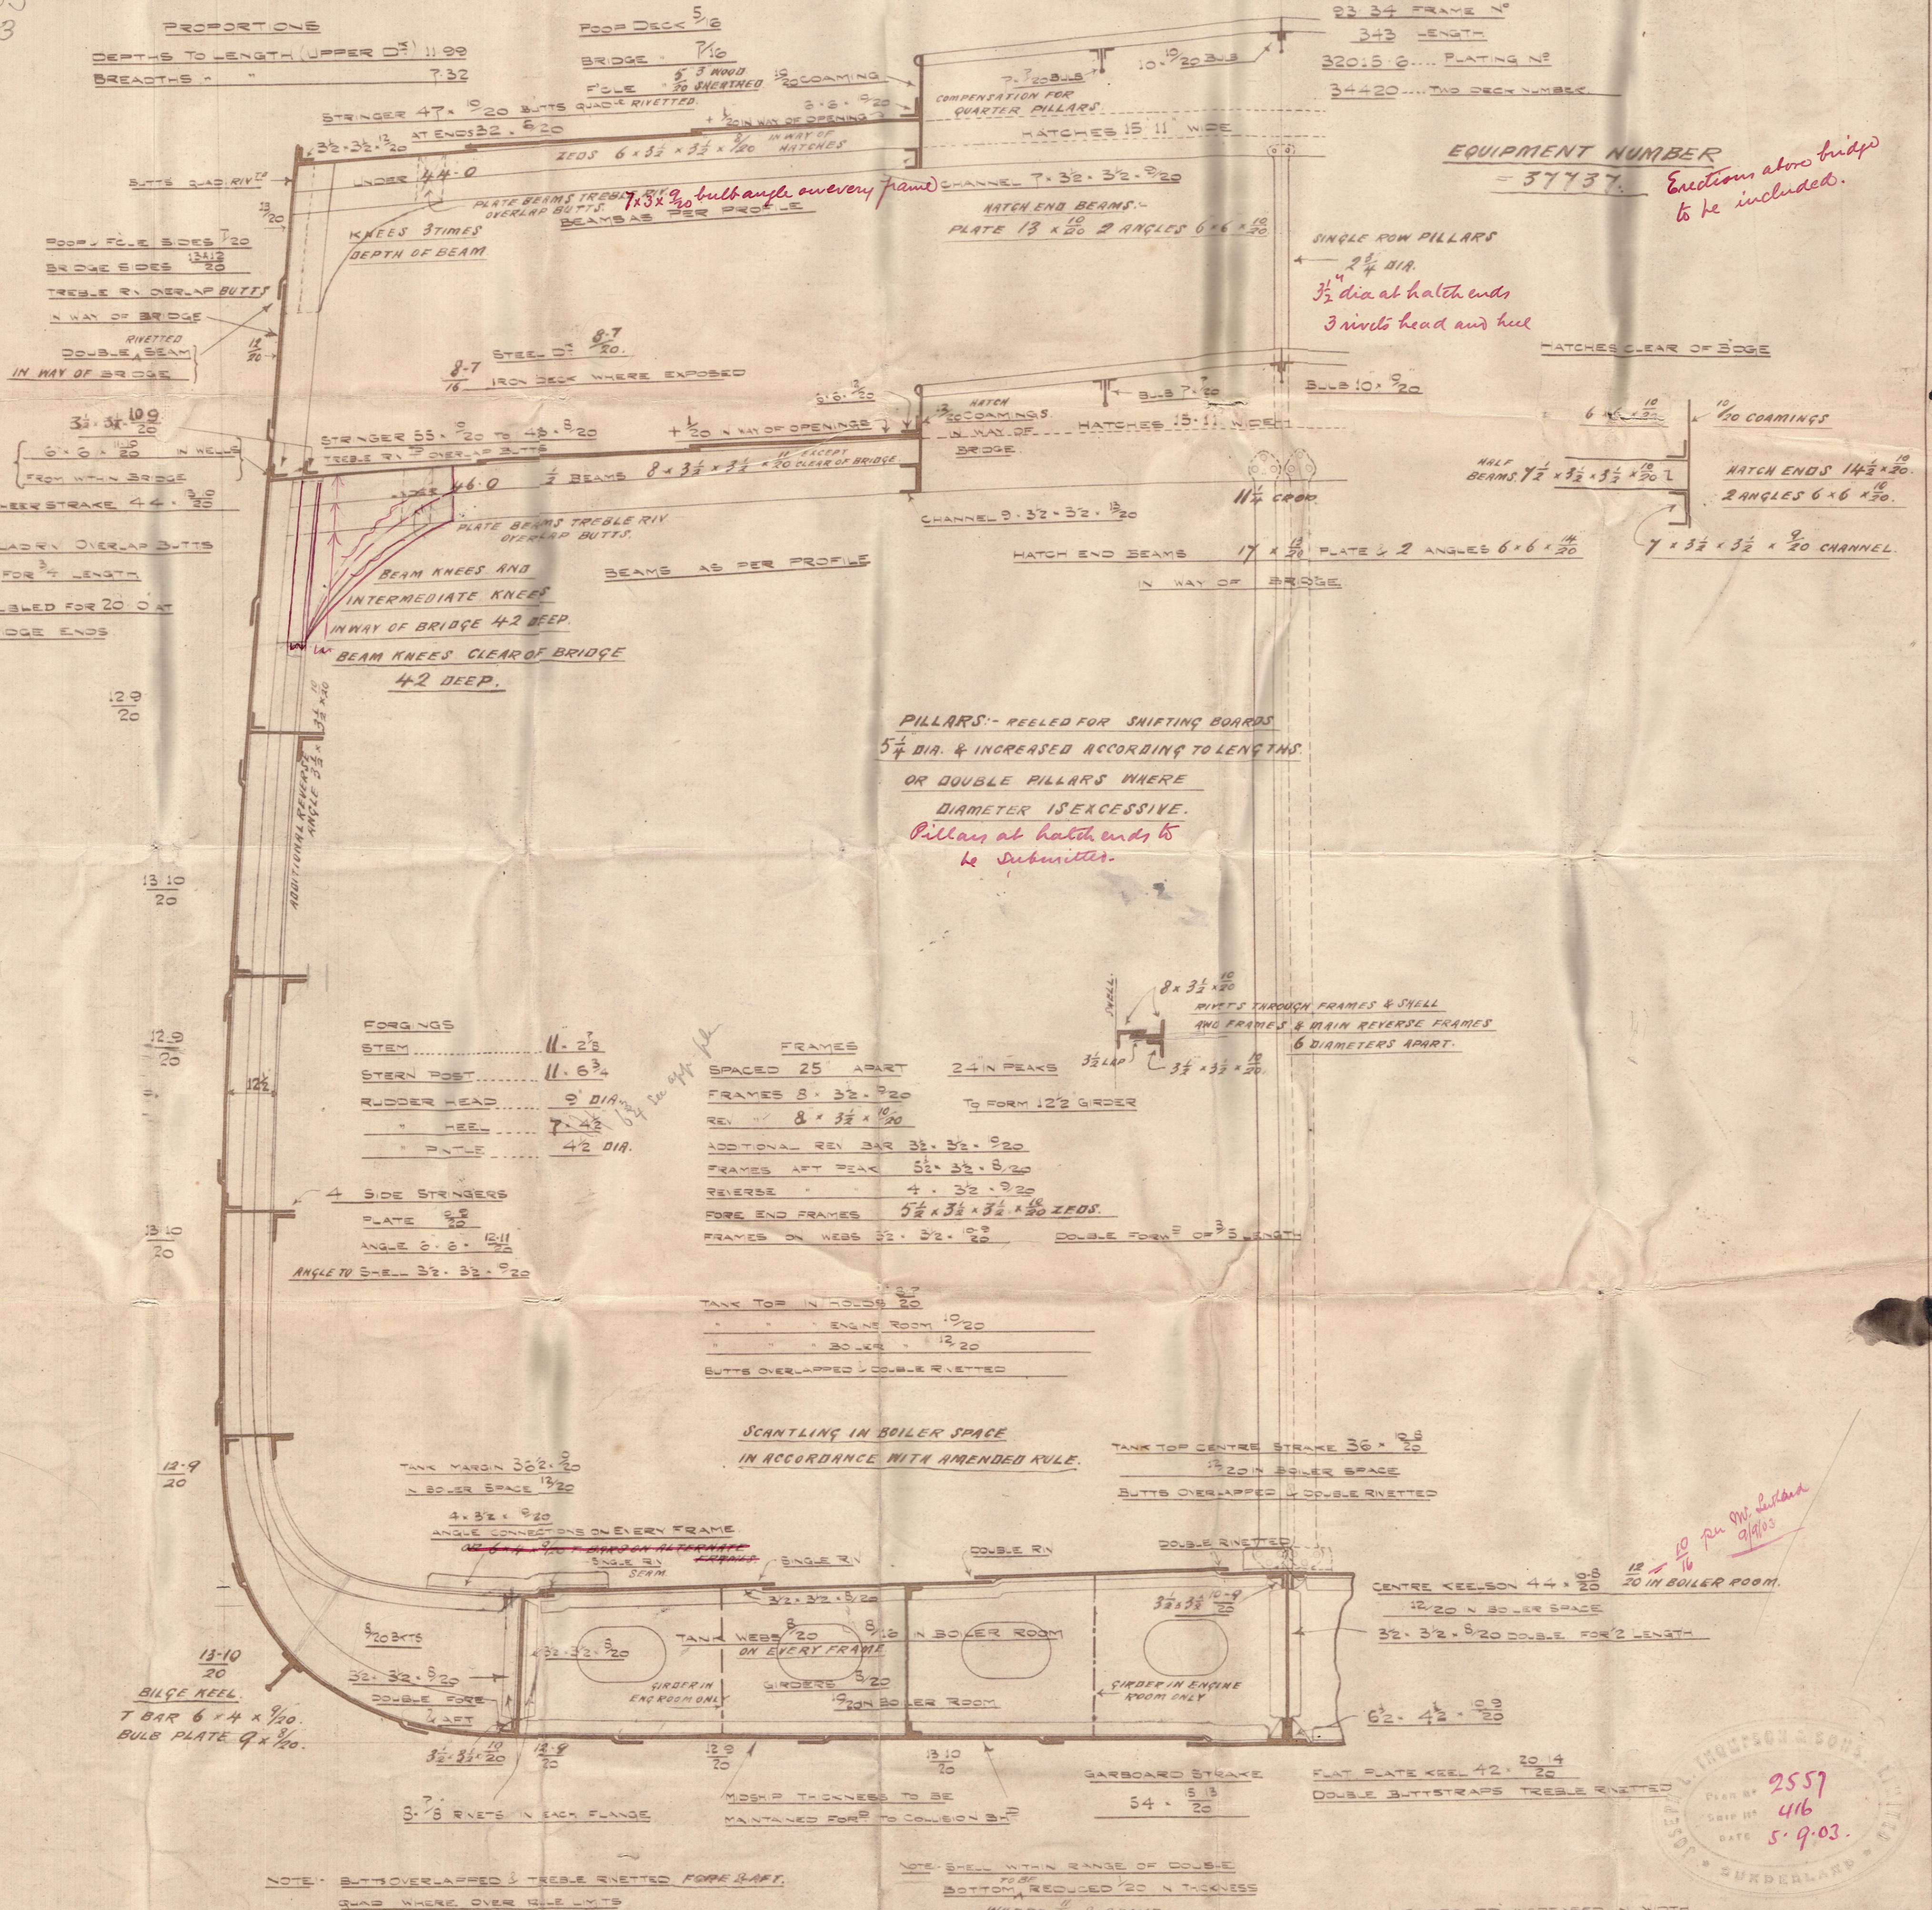

2557
 416
 5.9.03.

5.9.03
 Let

LLOYD'S REGISTER

© 2020 Lloyd's Register
 W666-0198 Indation

W. L. THOMPSON & SONS

Amended SECTION

416

SS BURNHOLME
Slid Ford 21753

W666-0198



© 2020

Lloyd's Register
Foundation