
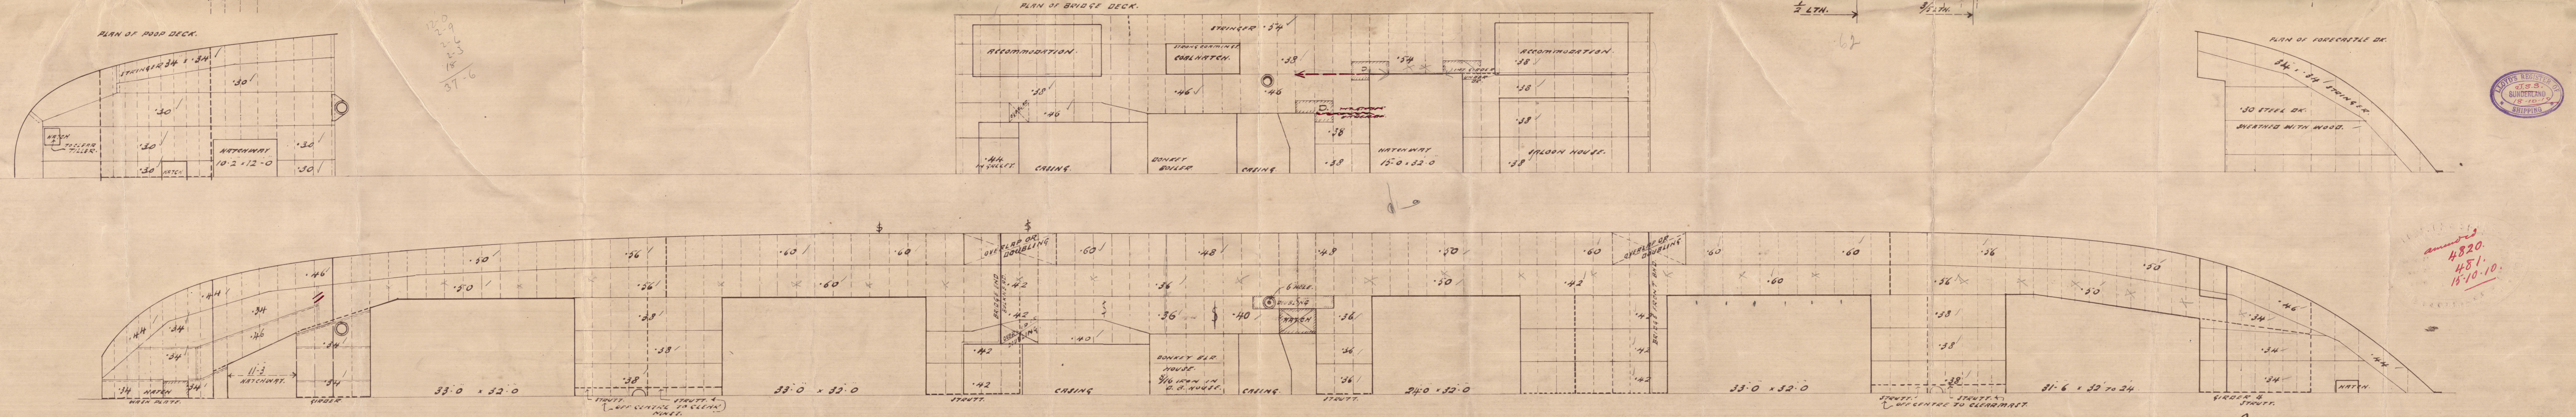


# S. S. N<sup>o</sup> 481.

380-0 B.P. x 53-7' H.T. x 29-6' L.P.  
53-3' M.D. 29-7 1/2' M.D.

PATENT CANTILEVER TYPE.

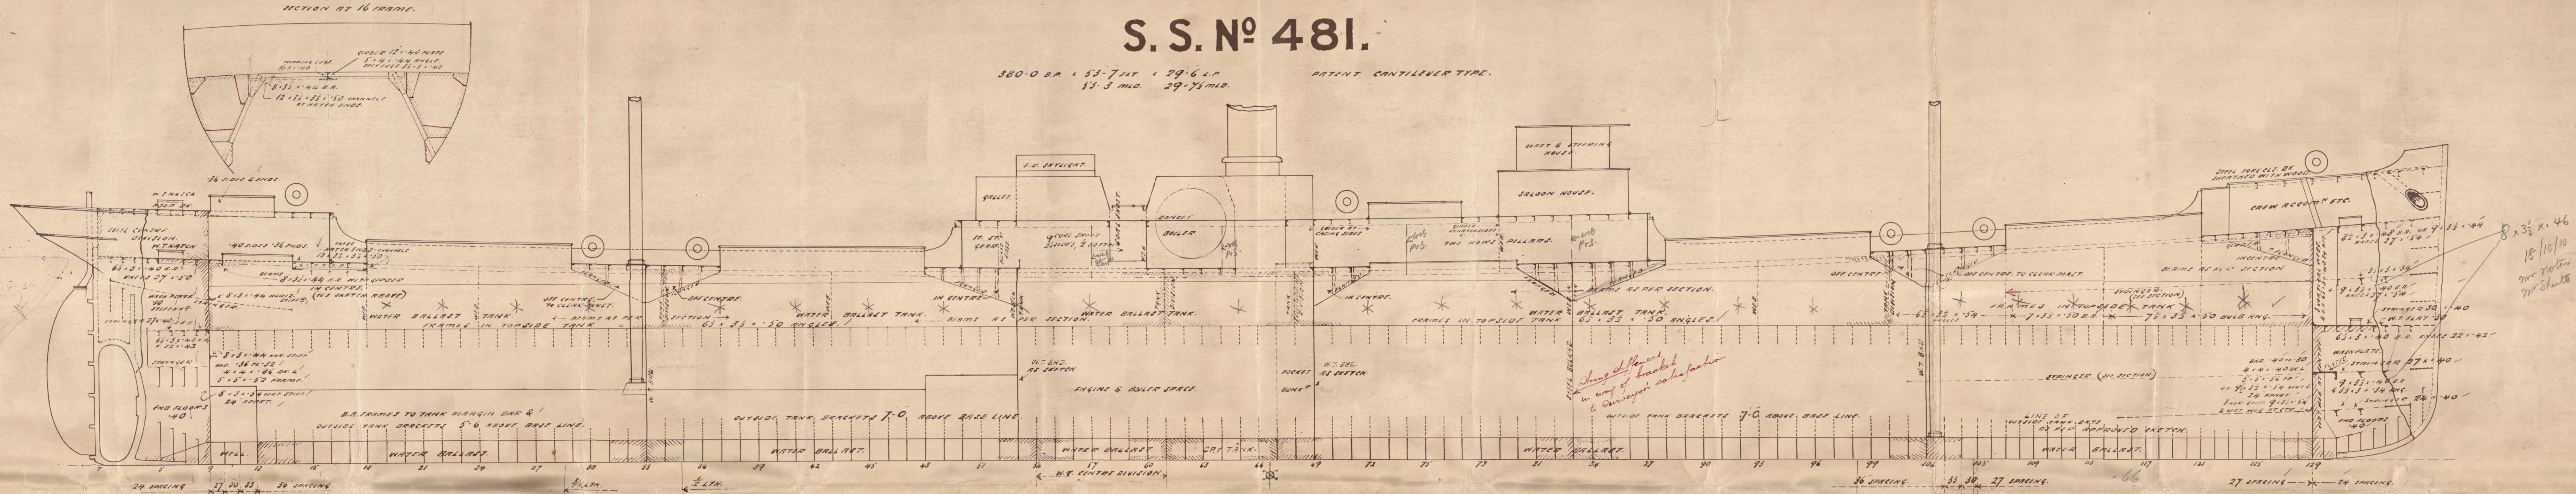

4820.  
481.  
15-10-10.


C.B.  
26-10-10.

J L Thompson &  
Sons

No 481

Amended Profile

Sld Rpt 24866

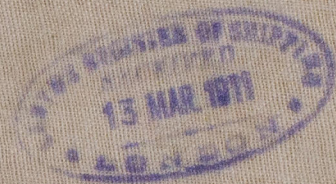

RETAIR

TENPAISAN MARU

Sld Rpt 24908

W668-0109



© 2020

Lloyd's Register  
Foundation