


Nº 4219

20/9/11

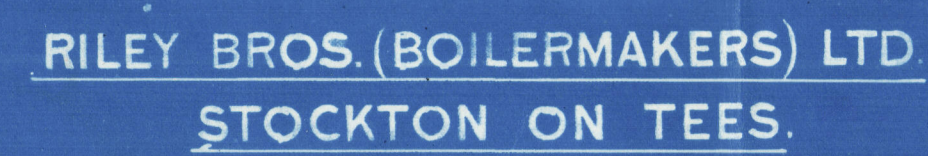

Lloyds

Messrs Niley Bros
Boiler No 4219
for 4240

Messrs J. L. Thompson & Sons Ltd

S. S. No 481
Sir R. Dixon & Co Ltd S. S. No 559
Working Press 180 lbs.



4219

No. 4565
LLOYD'S TEST.
360 lbs.
1.2.11
WM

Messrs J. L. Thompson & Sons
S. S. No 481
S. S. Tenpaisean Maru
Indl Report No 6637

4240

No. 4634
LLOYD'S TEST.
360 lbs.
29.4.11
WM

Sir Raylton Dixon & Co
S. S. No 559
S. S. Kinkasan Maru
Indl Report No 6881

RETAIN

4-5-0



© 2020

Lloyd's Register
Foundation

W668-011