

N^o DIMENSIONS 400 - 80 - 30

LOYDS 1st N^o 88
2nd N^o 38200
Equip^t N^o 36254

ANCHORS & CHAINS

2 BOWERS (STOCKLEYS)	7" 140" EACH
1 BOWER	6" 104"
STREAM	6" 455"
KEG	12" 100"
CHAIN CABLE	6" 70" 104"
STREAM CHAIN	6" 104"
TOWLINE	12" 104"
HAWKERS	6" 104"
WARES	6" 104"

SECTION IN WAY OF DEEP TANK AT TRANSVERSE 10 1/2

SECTION IN WAY OF DEEP TANK AT TRANSVERSE 10 1/2

Midship Seehon

119

126

S. "Pacific"

S. No. 2257

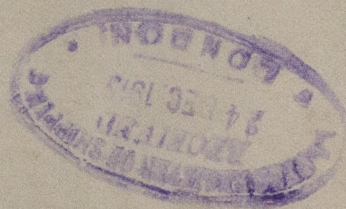

W67-0177



© 2020

Lloyd's Register
Foundation