

6. 2. 13
13. 2. 13.
21. 2. 13
3. 3. 13

Equipment

Longitudinal handles	=	33819.634 ✓
Seller's etc. 400.98 x 8' x 3/4" =		2789.58 ✓
Handle etc. 185.08 x 7.5 x 3/8 =		694.05 ✓
Equip. etc.		36343.20 ✓

2 Bowser Buckles	51	Buts	in stock	✓
1 Bowser Buckles	43 $\frac{3}{4}$	"	"	✓
1 Stream	"	17 $\frac{5}{8}$	"	✓
1 Ridge	"	7 $\frac{5}{8}$	"	✓
270 Slat	2 $\frac{1}{2}$ "	slat chain	with 68 $\frac{1}{2}$ "-1-11	✓
90 "	1 $\frac{1}{2}$ "	stream chain	or 2 $\frac{3}{4}$ " slat wire	✓
120 "	1 $\frac{1}{2}$ "	Twine	or 5" slat wire	✓
2 Slaps	at 8"	90 Slat	with or 2 $\frac{3}{4}$ " "	✓
2 Slaps	"	7"	90 " " 2 $\frac{3}{4}$ " "	✓

55'0" Alld Breadth
30'0" " Depth 38'0" to shell on beach
88'04" Lagoon Rk.
40'0" 92' Length
33'19'63' Length Rk.

Back Plating ³⁴ for 5 d, 1.30 at ends.
Butte Copper L. & S. d. for 5 d, 1.00 at ends.

Stringer #7" x .444 to 5.2 ✓
to 35" x .444 at ends. ✓
On the capped + 3. 9. ✓

C.B.
6.2.13.

For corrected plan of vessel
as built see mill ship section
dated 12/8/13 - J.S.

647



Midship Section

Messrs

Russell & Co.



Capt. H. Scipio Mann
Greenock Report No. 16520

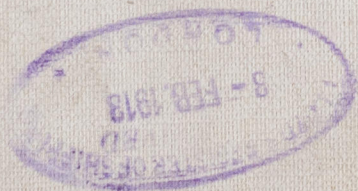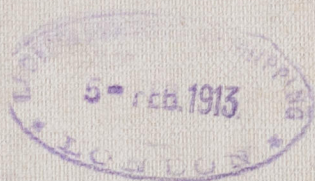

RECEIVED



© 2020

Lloyd's Register
Foundation