

STEAM HOUSE BOAT

LENGTH ON WL. 85'-0" BREADTH 20'-0" DEPTH 15'-9" M^d TO SHADE DECK.


SCALE $\frac{1}{4}$ " INCH = 1' FOOT

Speed abt 8 Knots.



28.11.03
1.1.04
12.2.04

*Proposed Plan
for the
Steam House Boat*

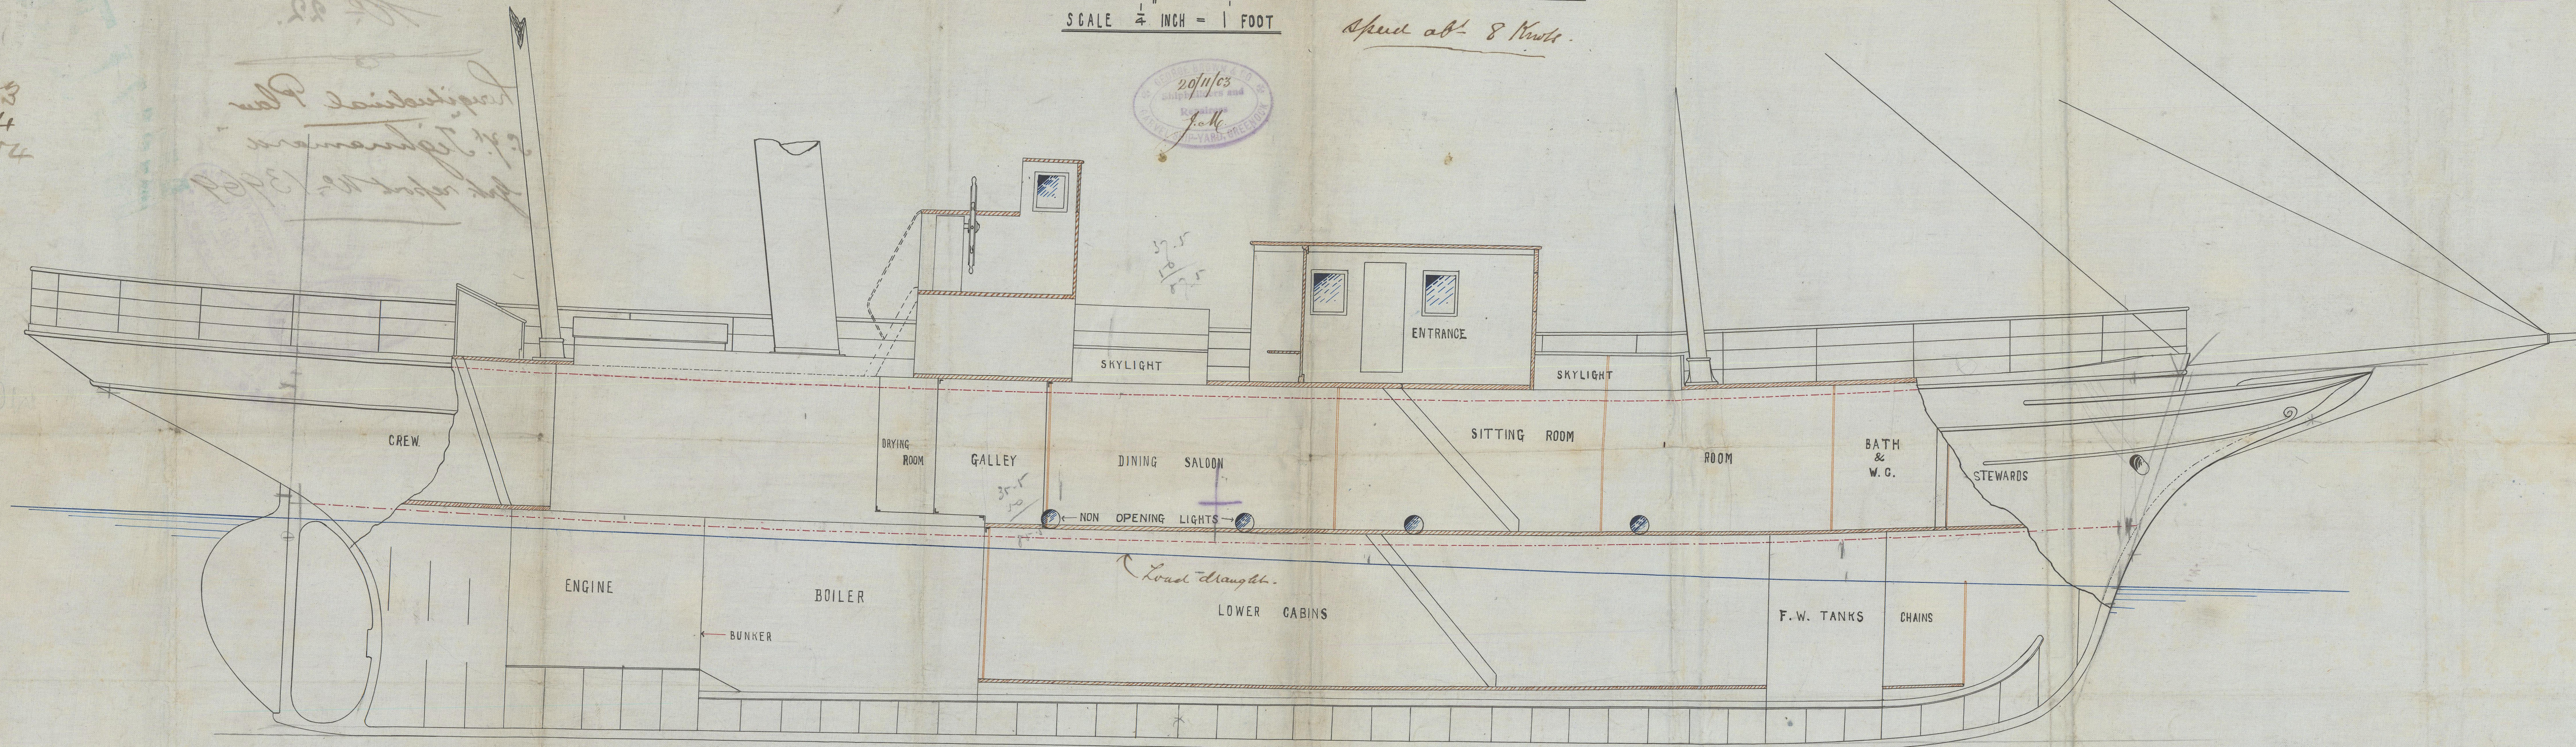

J.H.
27/11/03



© 2020

Lloyd's Register
Foundation

W672-0246

Geo. Brown & Co's

Steam House Boat

No. 22.

Longitudinal Plan
S. Y. Tighnamara
Grk. report No. 13969



© 2020

Lloyd's Register
Foundation