

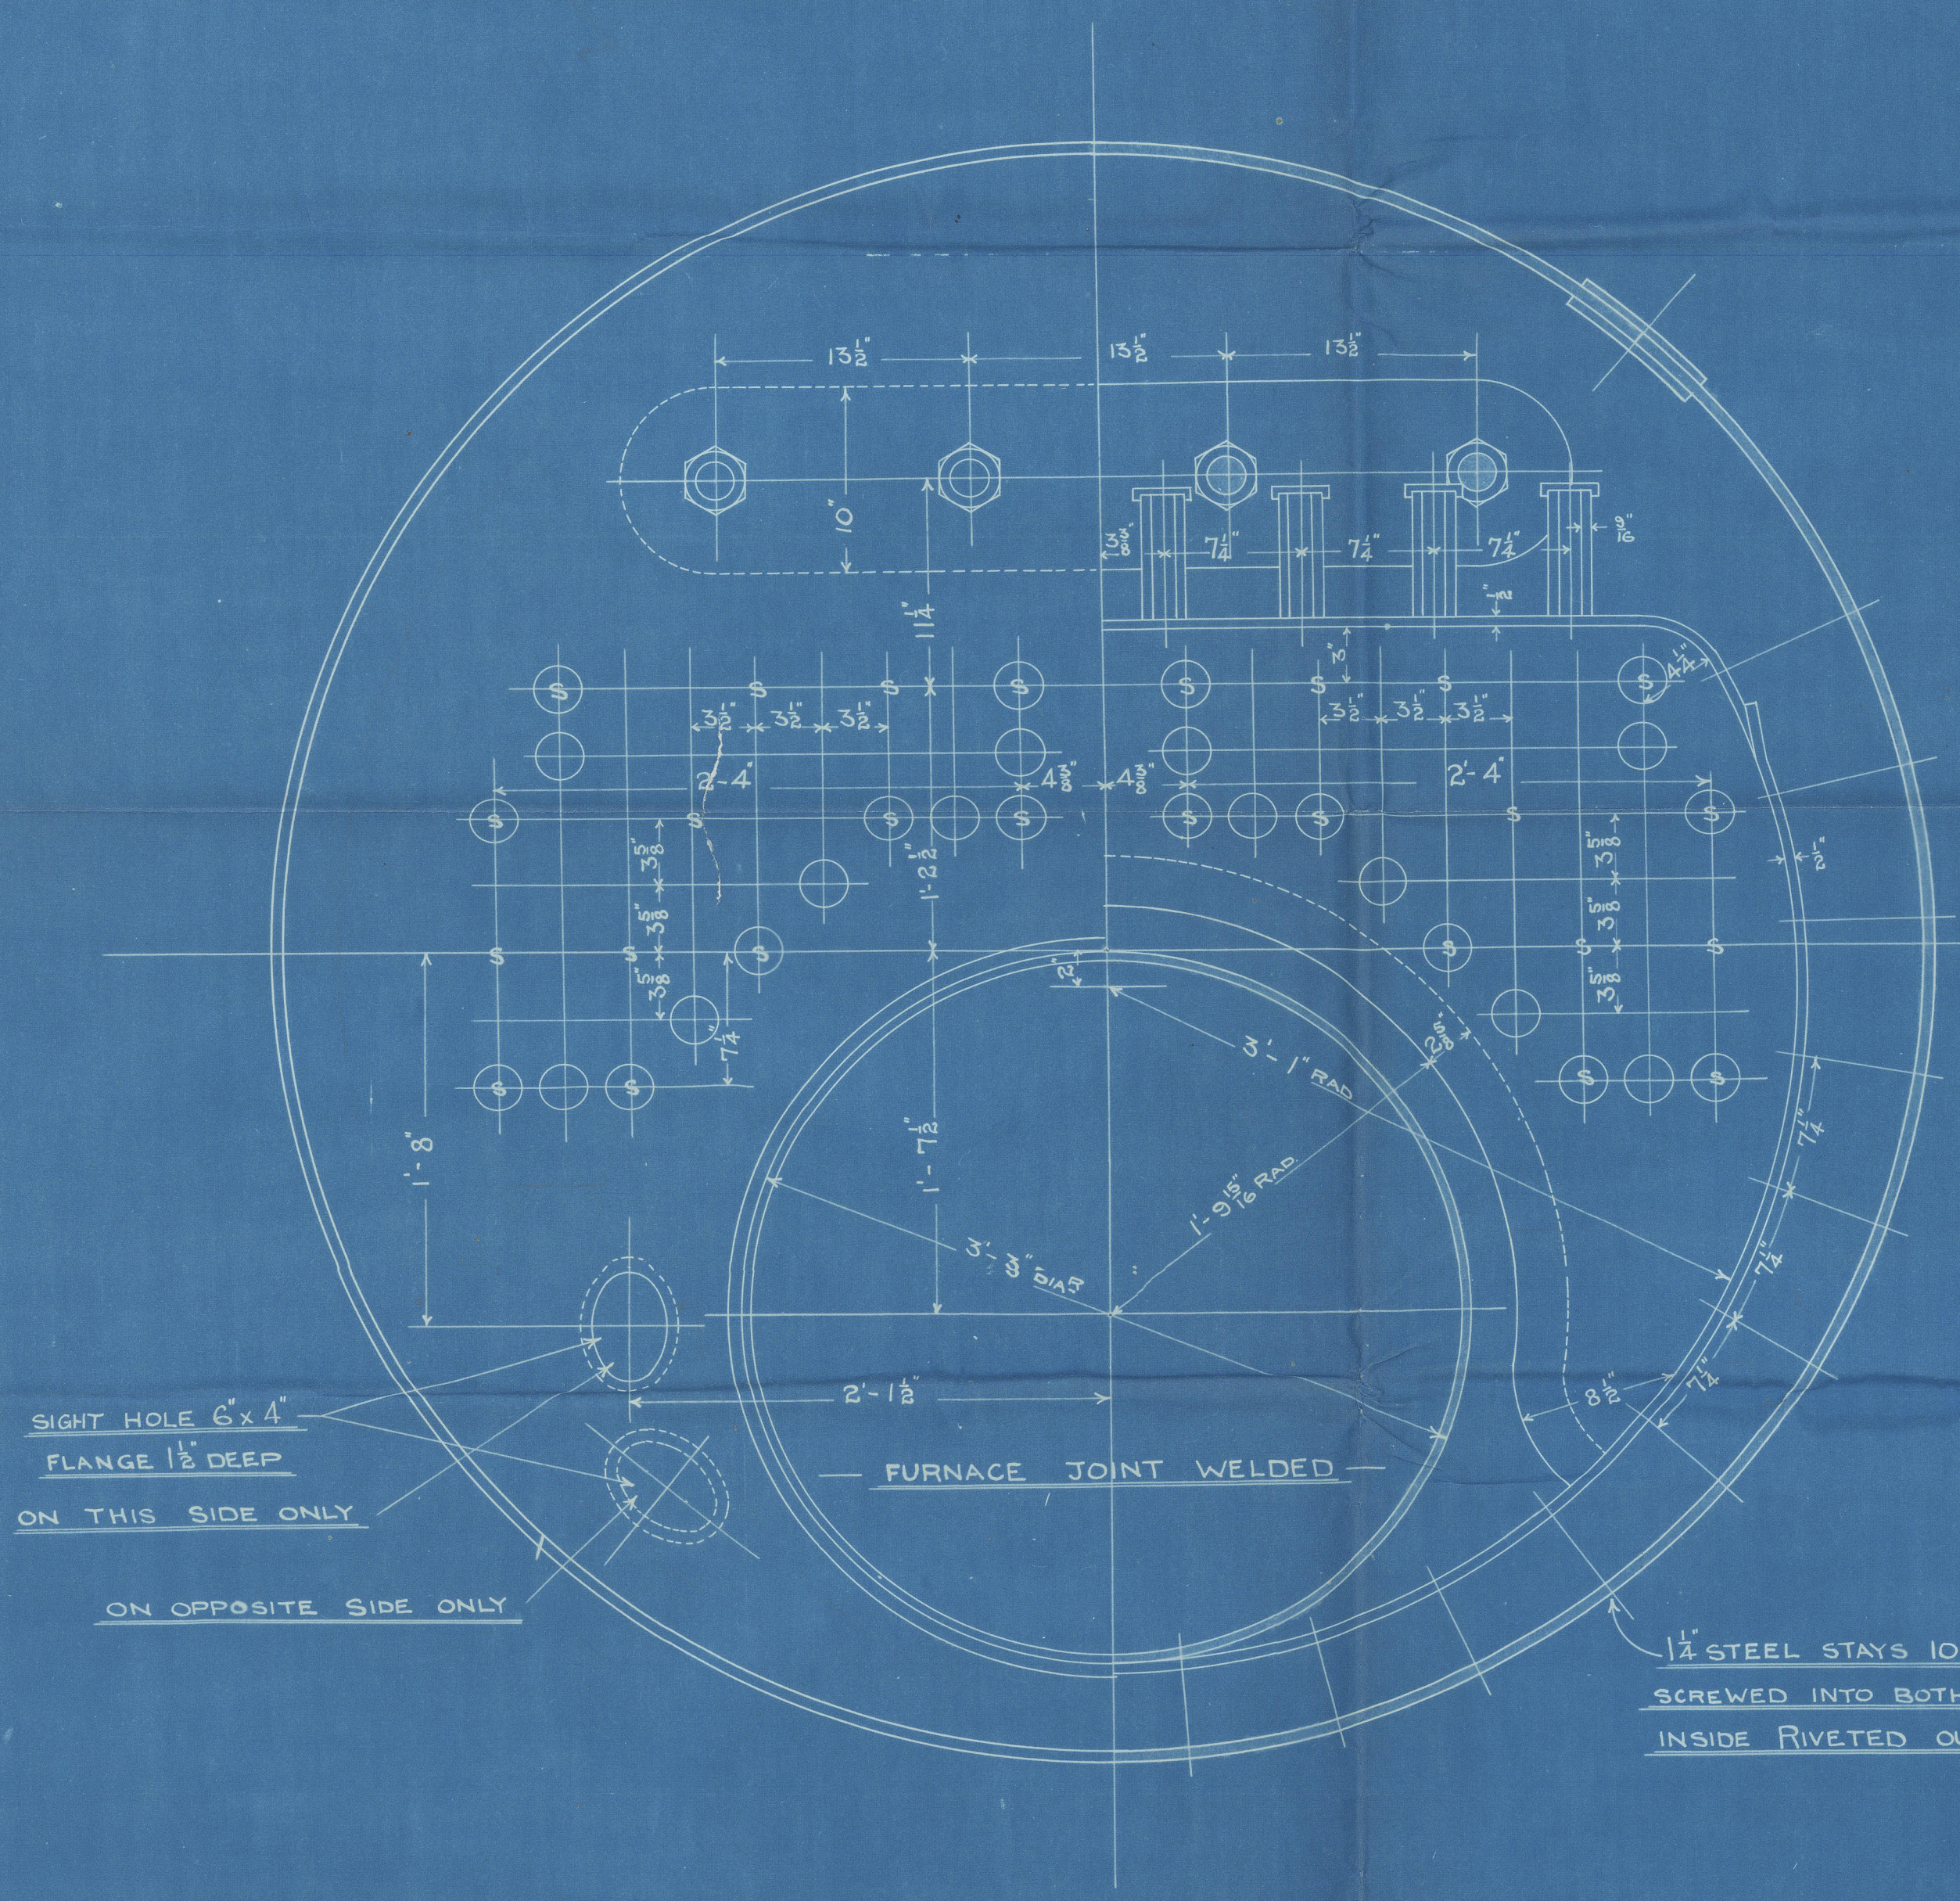
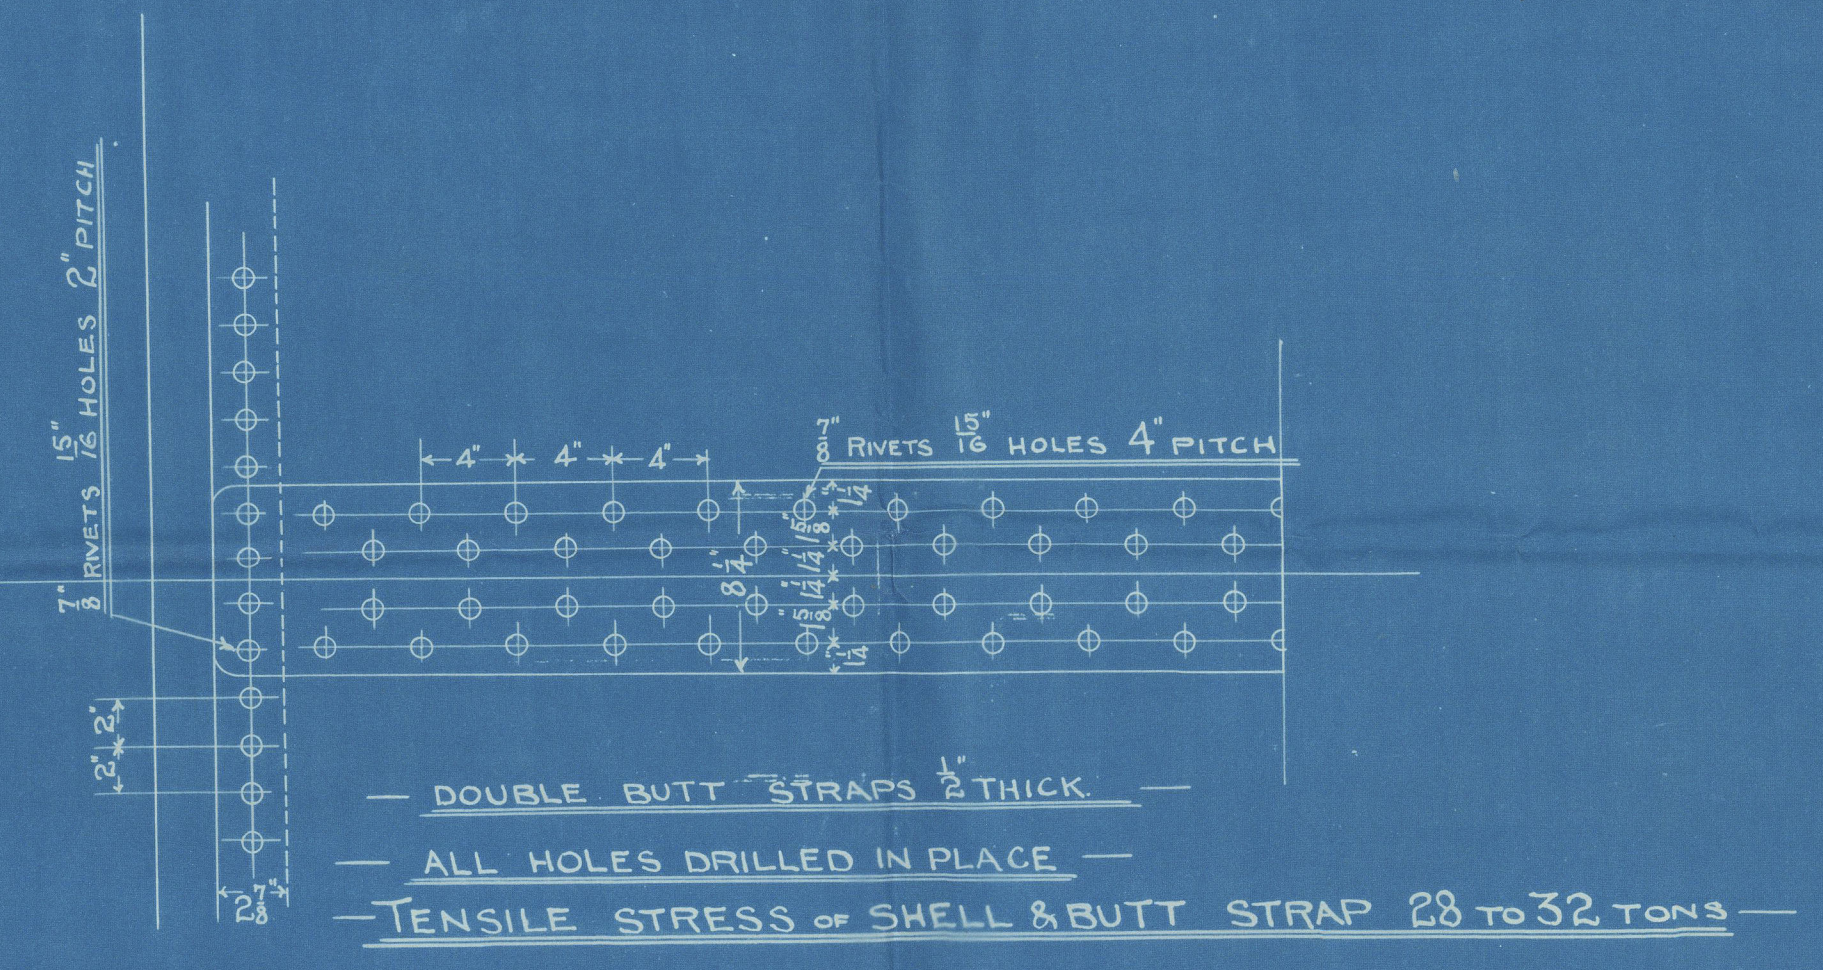


Mr. 23.12.03

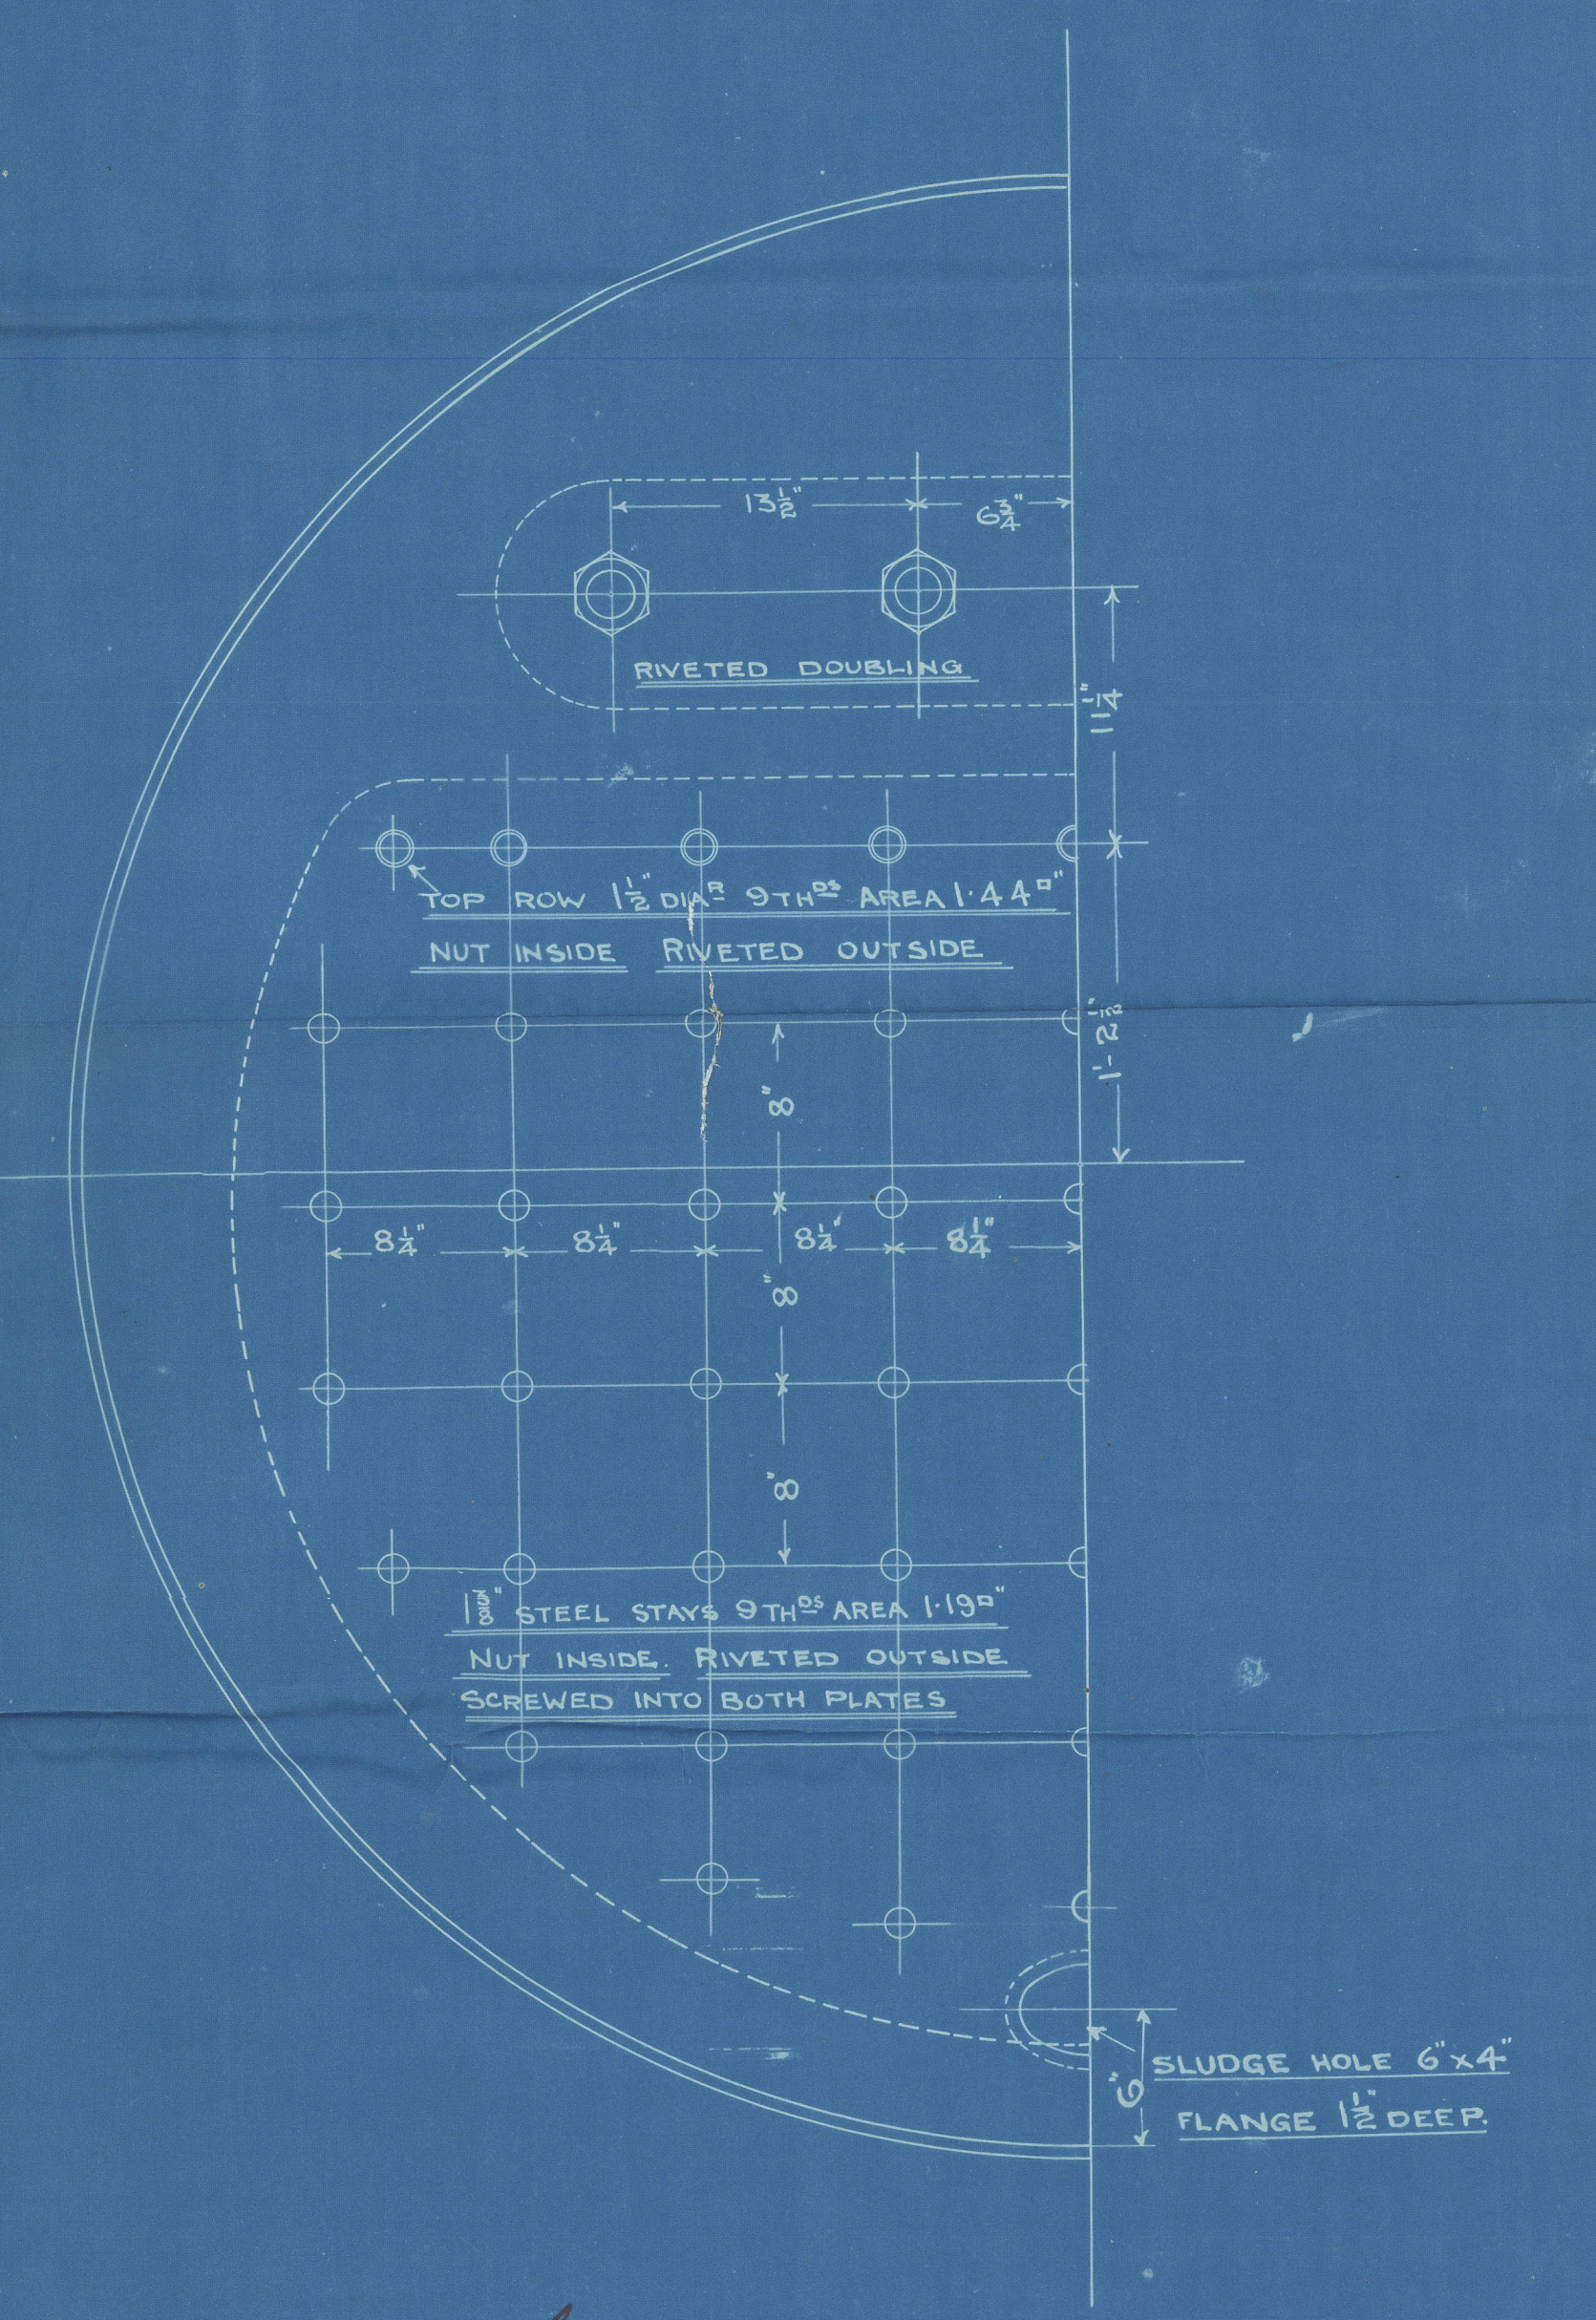

SIGHT HOLE 6"x4"
FLANGE 1 1/2" DEEP
ON THIS SIDE ONLY
ON OPPOSITE SIDE ONLY

1 1/2" STEEL STAYS 10 TH^{RS} AREA 98"
SCREWED INTO BOTH PLATES, NUT
INSIDE RIVETED OUTSIDE

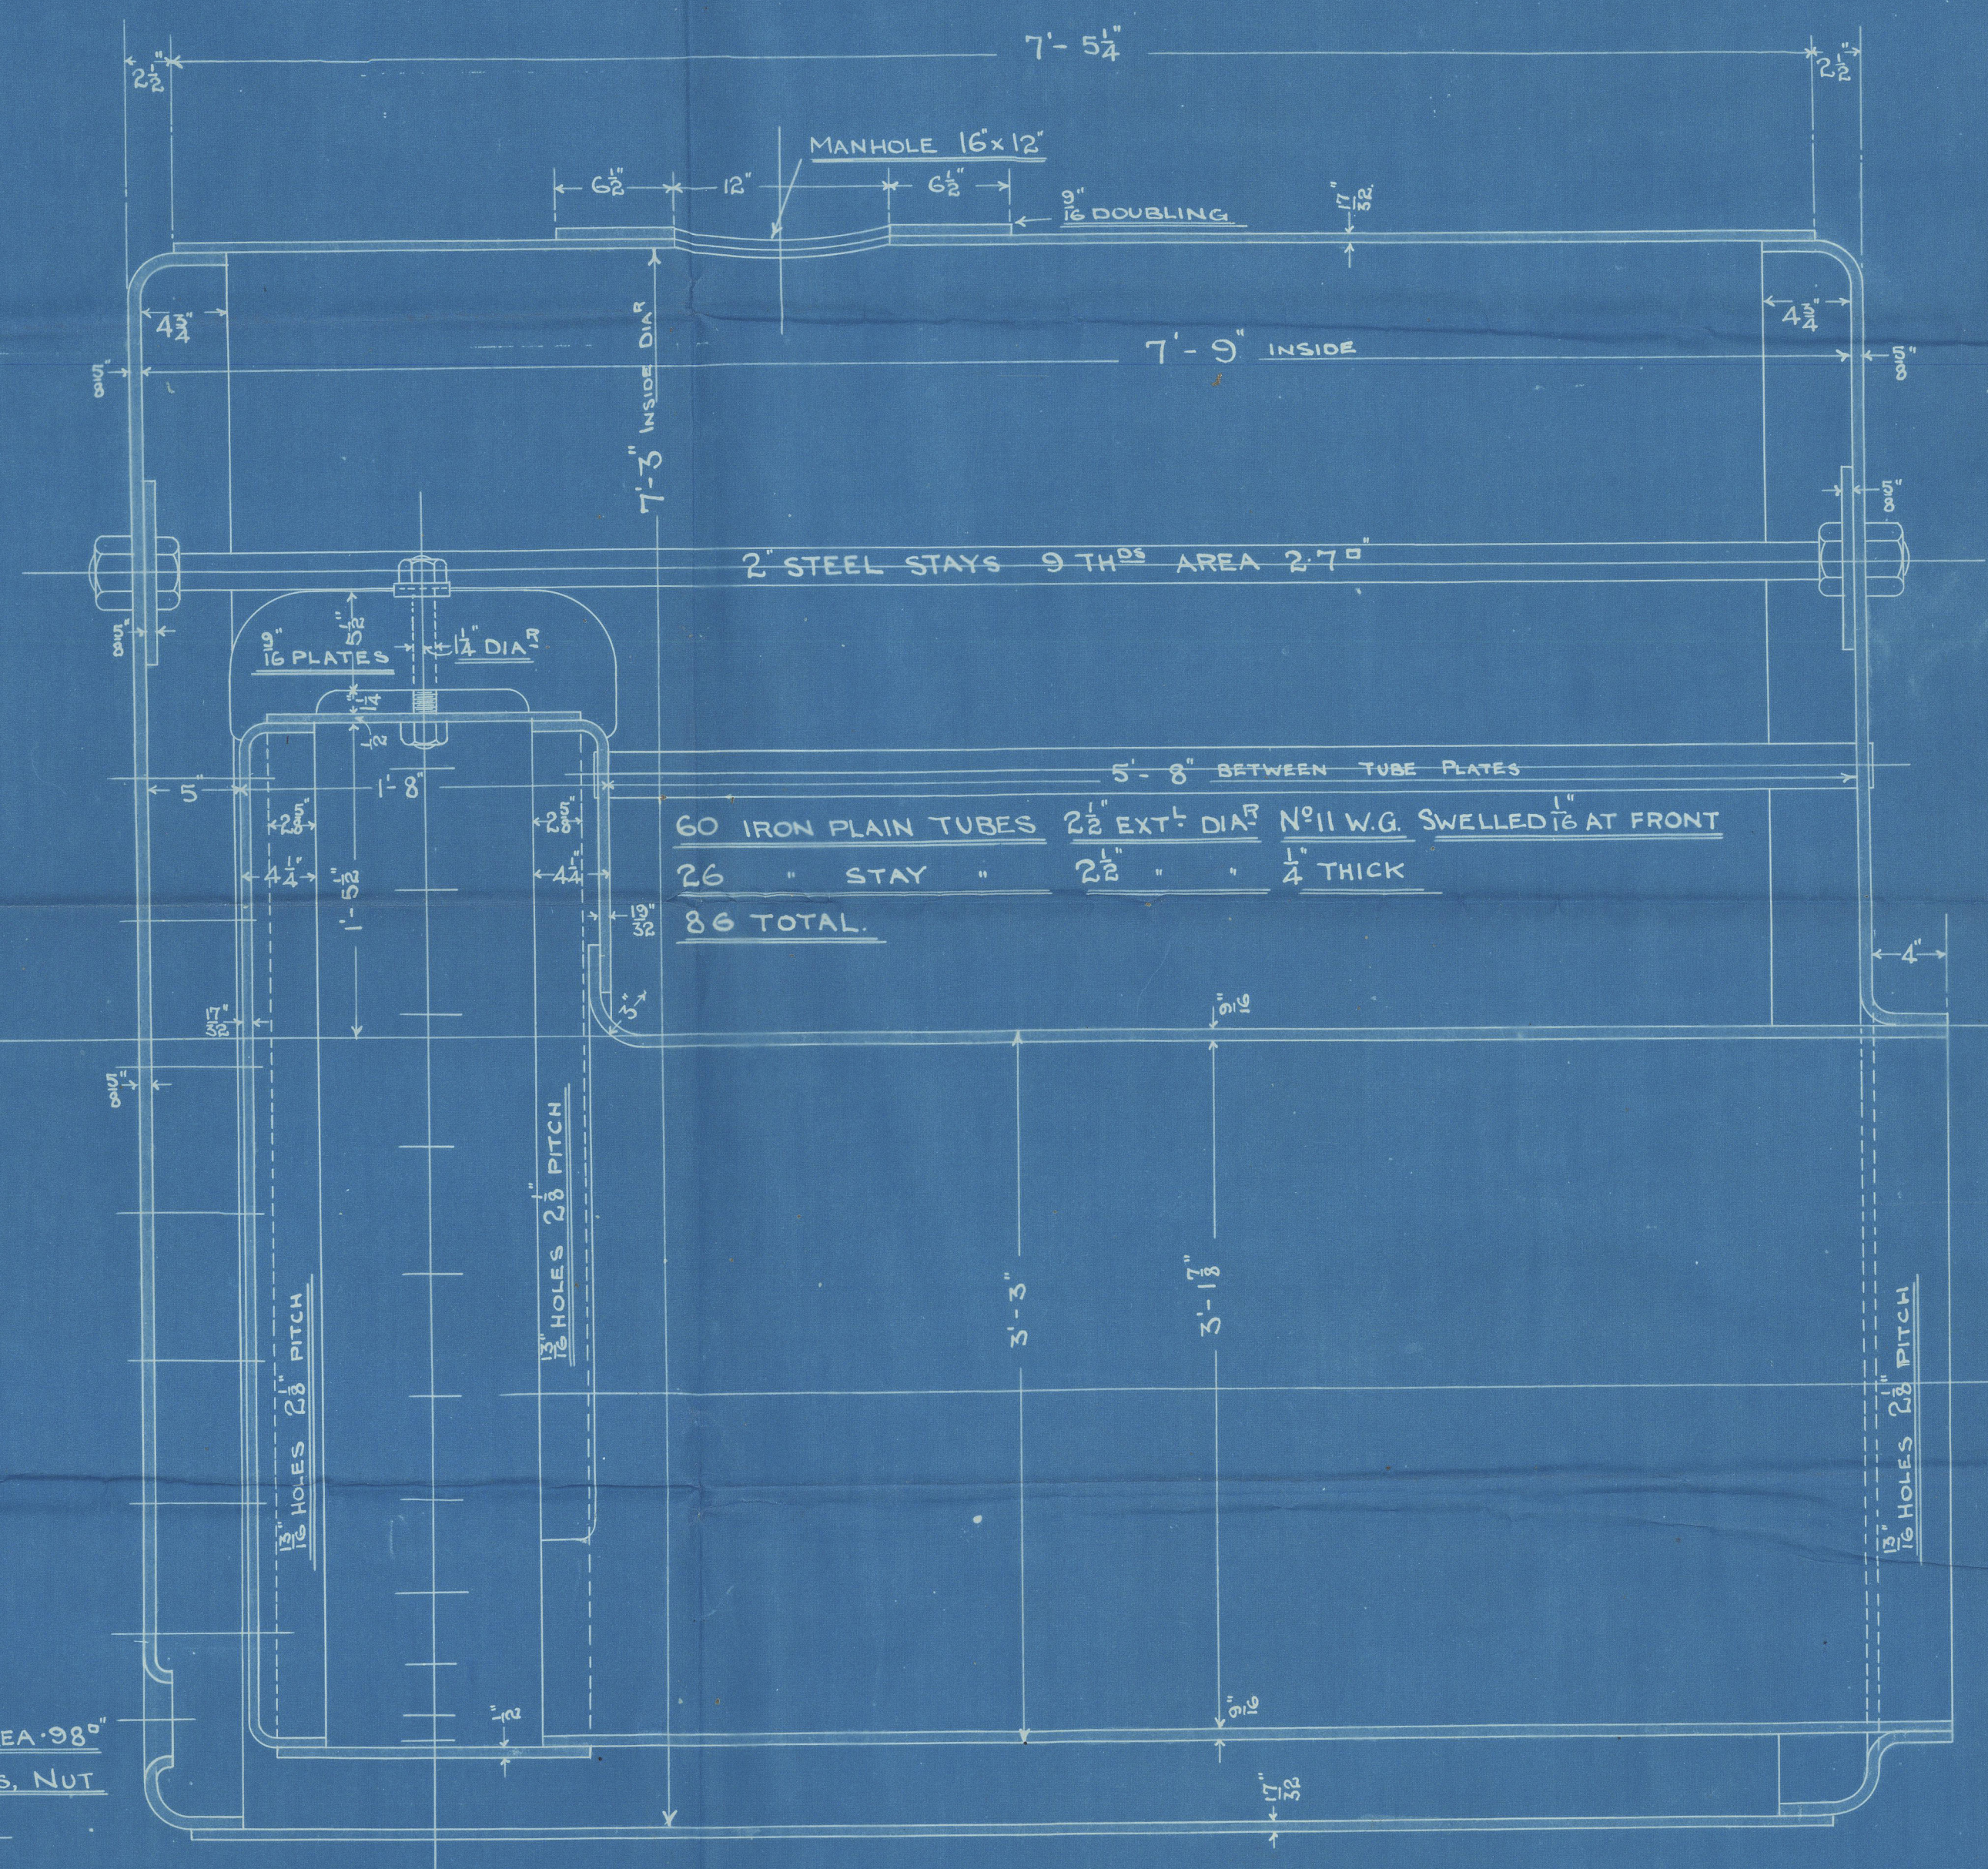

PARTICULARS	
HEATING SURFACE TUBES	318 1/2
" FURNACE	29 1/2
" CHAMBER	49 1/2
" TOTAL	396 1/2
GRATE AREA	


23.12.03

23.12.03

STEEL BOILER 7'-3" INT^L DIA^R x 7'-9" LONG 120 LBS W.P.

SCALE 1/2" = 1 FOOT.
ORDER N° 928


TO LLOYD'S SURVEY

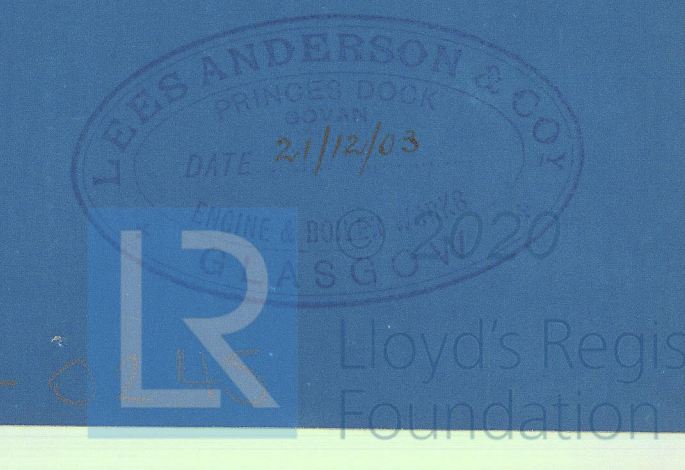

Lees Anderson & Co
Boiler No 928

s. yacht "Lighnamara."

Glasgow No Number 21882.

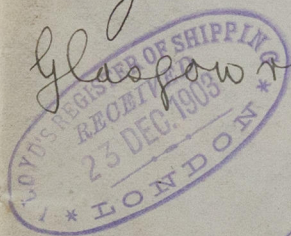

RECEIVED



© 2020

Lloyd's Register
Foundation

W672 Q45