— No 366 —

— MIDSHIP SECTION —

— STEEL S.S 600-0" × 68-6" × 48-0" (TOP OF KEEL TO AWNING DECK BEAMS.) —

— TO CLASS 100 A.1. AT LLOYDS —

— AWNING DECK RULE. —

— SCALE ½" = 1 FOOT. —

26 · 10 · 03
12. 2. 04
27. 3. 05
9. 10. 05
26. 1. 06

— NUMERALS —

34·25 + 68·12 + 40·64 = 143·04 FRAMING No
143·04 × 594·84 = 85515·03 PLATING No
85515·03 + 26494·77 = 112309·8 EQUIPMENT No

— PROPORTIONS. —

12·45 DEPTHS TO AWNING DECK
14·94 " " MAIN "
8·72 BREADTHS TO LENGTH

Sun deck 6/20 3" Y.P. 50 × 10/20 4 × 4 × 11/20
7½ × 3½ × 10/20 Bulb angles
12/20 Channel frames continued 12/20

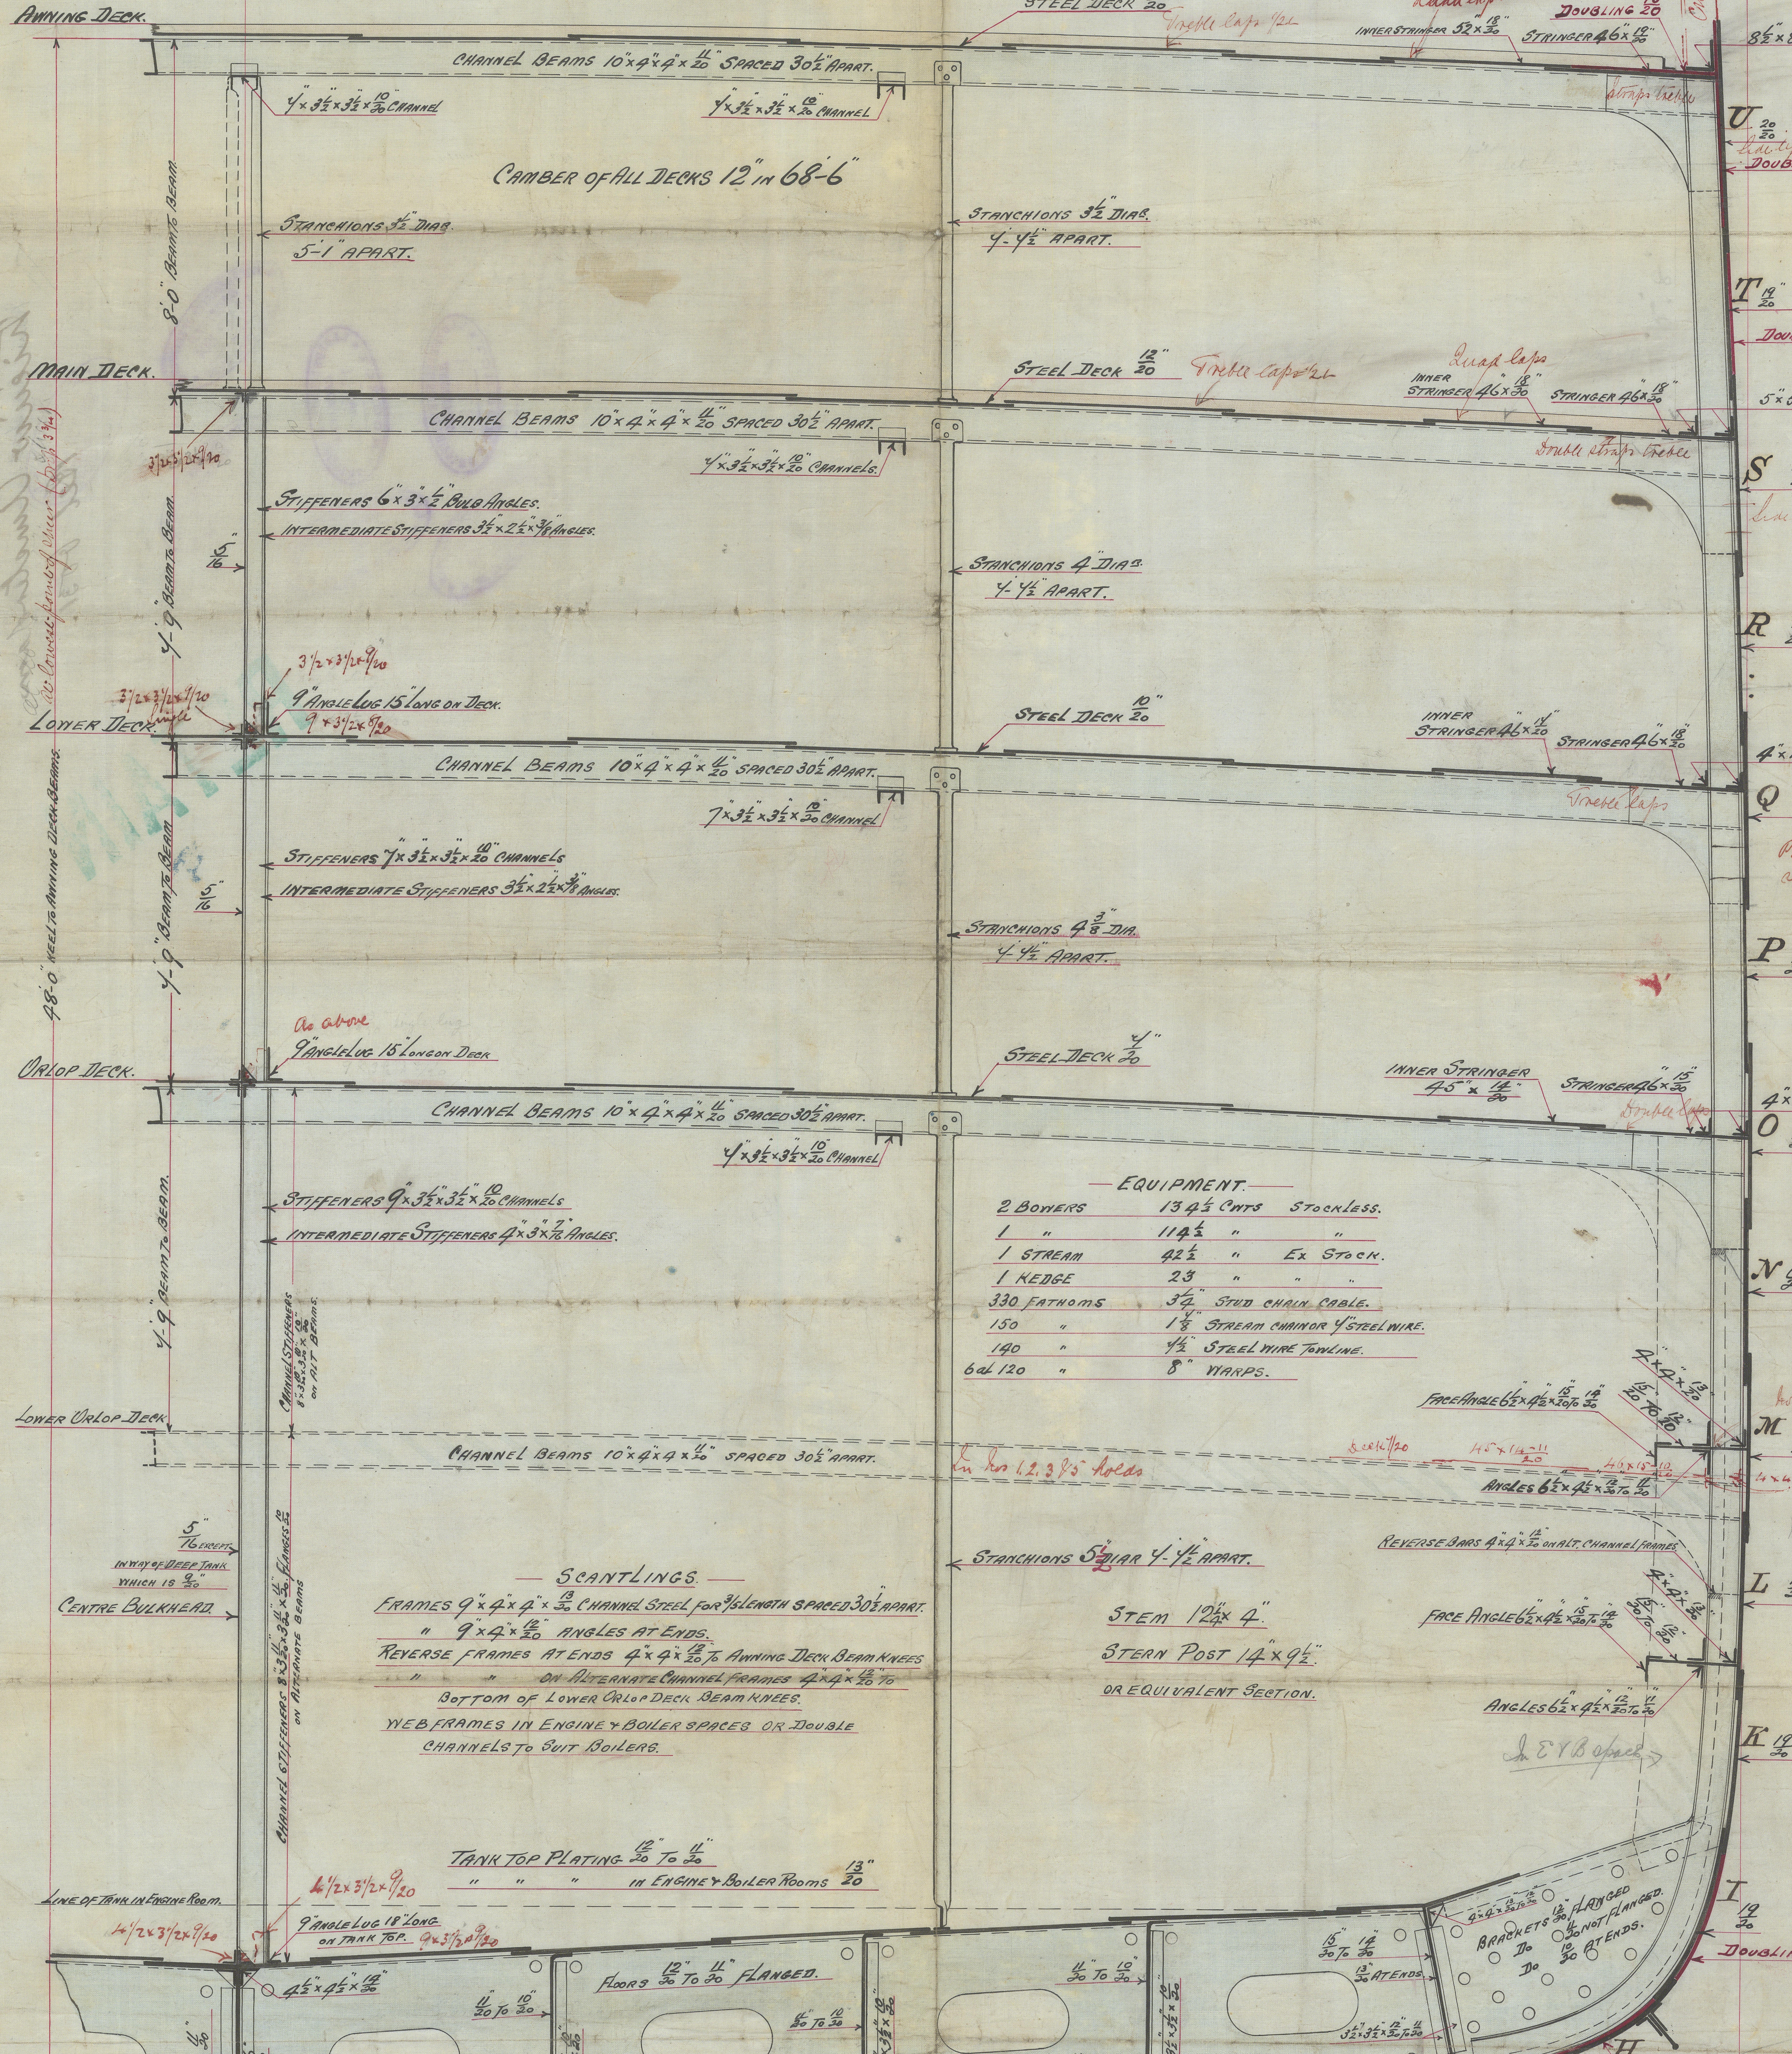

26/10/03

Belfast

Harland & Wolff's

S. S. No 366

Midship Section

"Nieuw Amsterdam"

Rel 6031.