

Boyd's Mark
10/9/17





PROFILE & DECK PLANS.

DIMENSIONS: LENGTH 374'0" BREADTH 44'0" DEPTH 14'3 1/2"



ISHERWOOD SYSTEM (PATENT)

SCALE 1/2" = 1'0"


PLAN OF OIL-TIGHT COVERS
TO BE REPAIRED.

 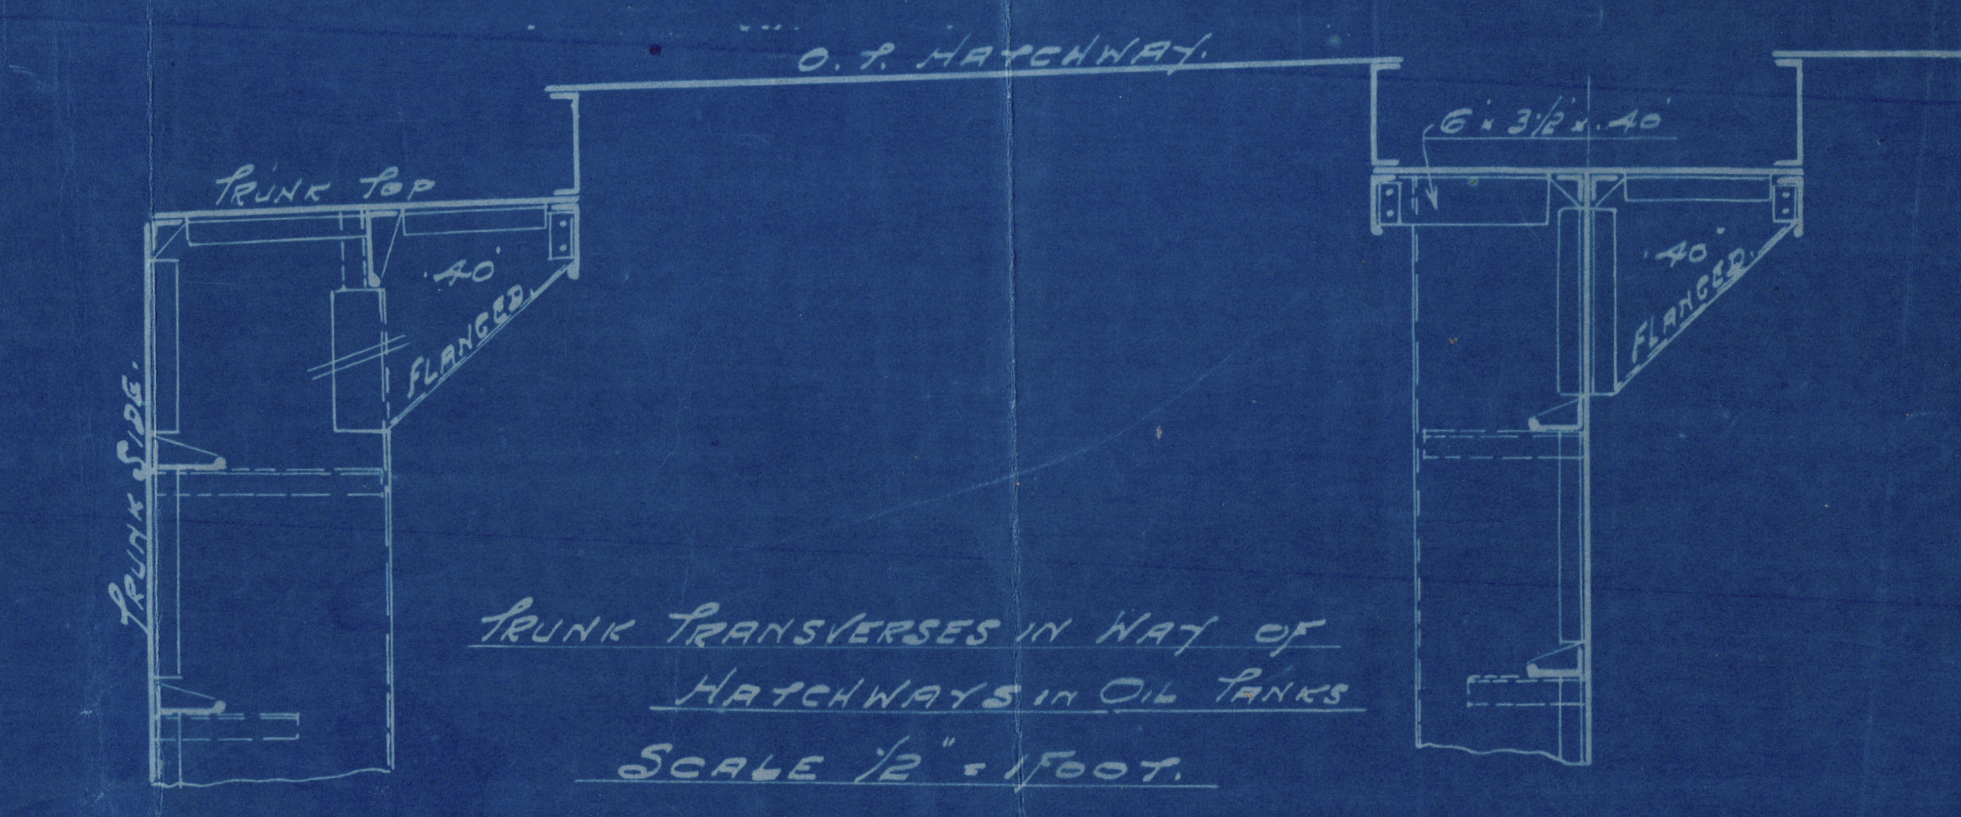

BRIDGE SIDE PLATING CARRIED
DOWN TO DECK AT BRIDGE ENDS.

  


Sign'd
C. S.
10/9/17

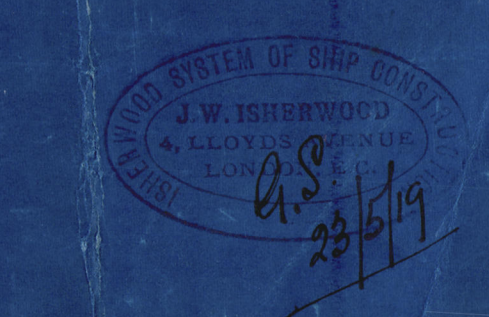

Profile and deck plans
S.S. "Homa" (ex. War Wagon)
Messrs. Robt. Duncan & Co. Ltd.

Nº 339.

Greenock Kpt. Nº 17481.

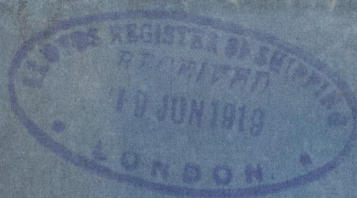




© 2020

Lloyd's Register
Foundation