

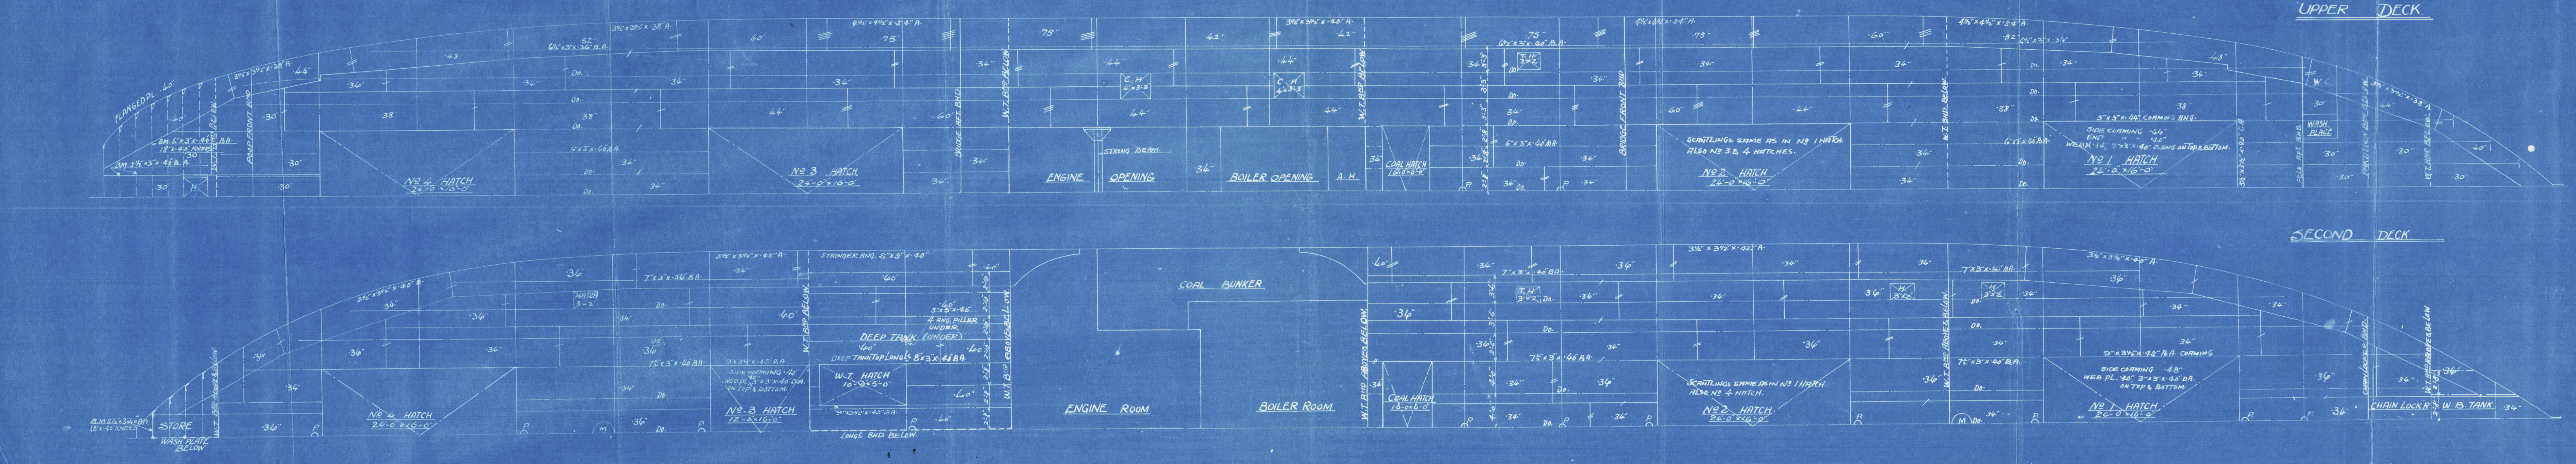
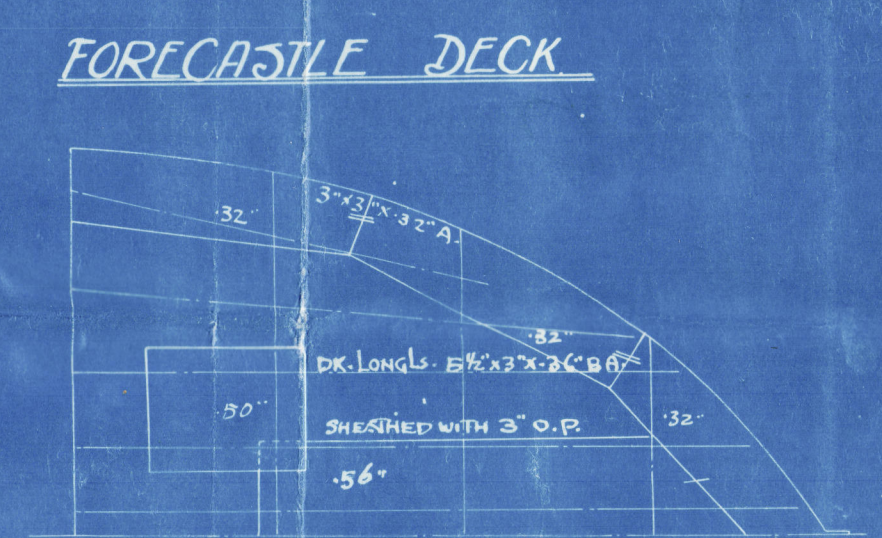
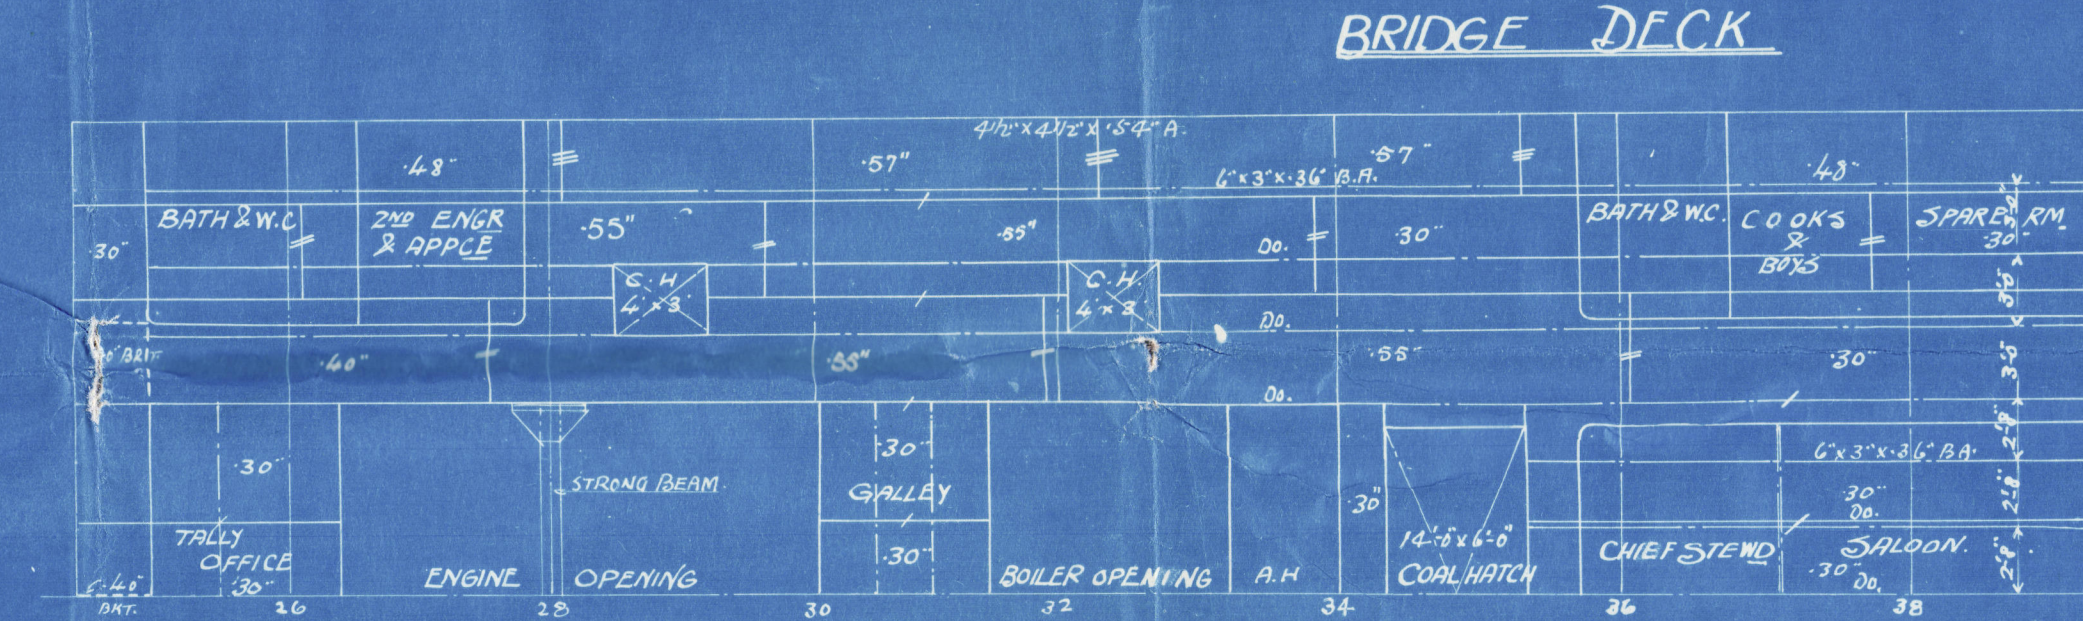


Nº 932 S.S. GENZAN MARU.  
STRUCTURAL ARRANGEMENT  
SCALE 1/8 IN TO ONE FT

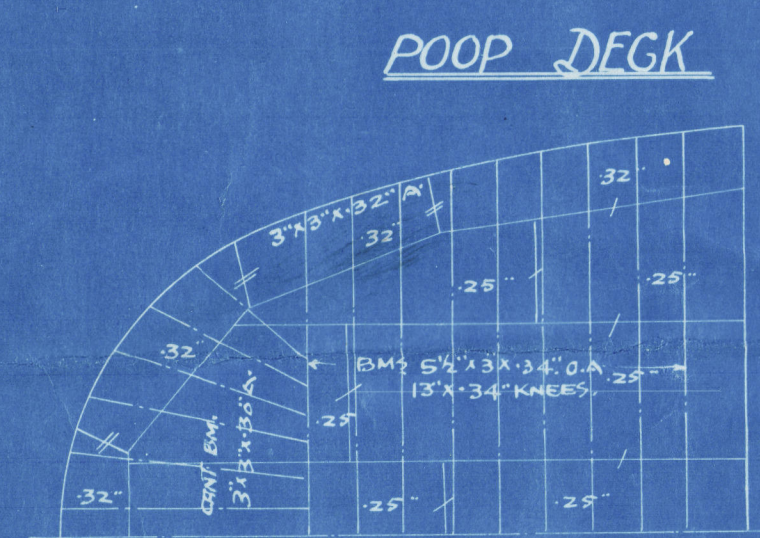

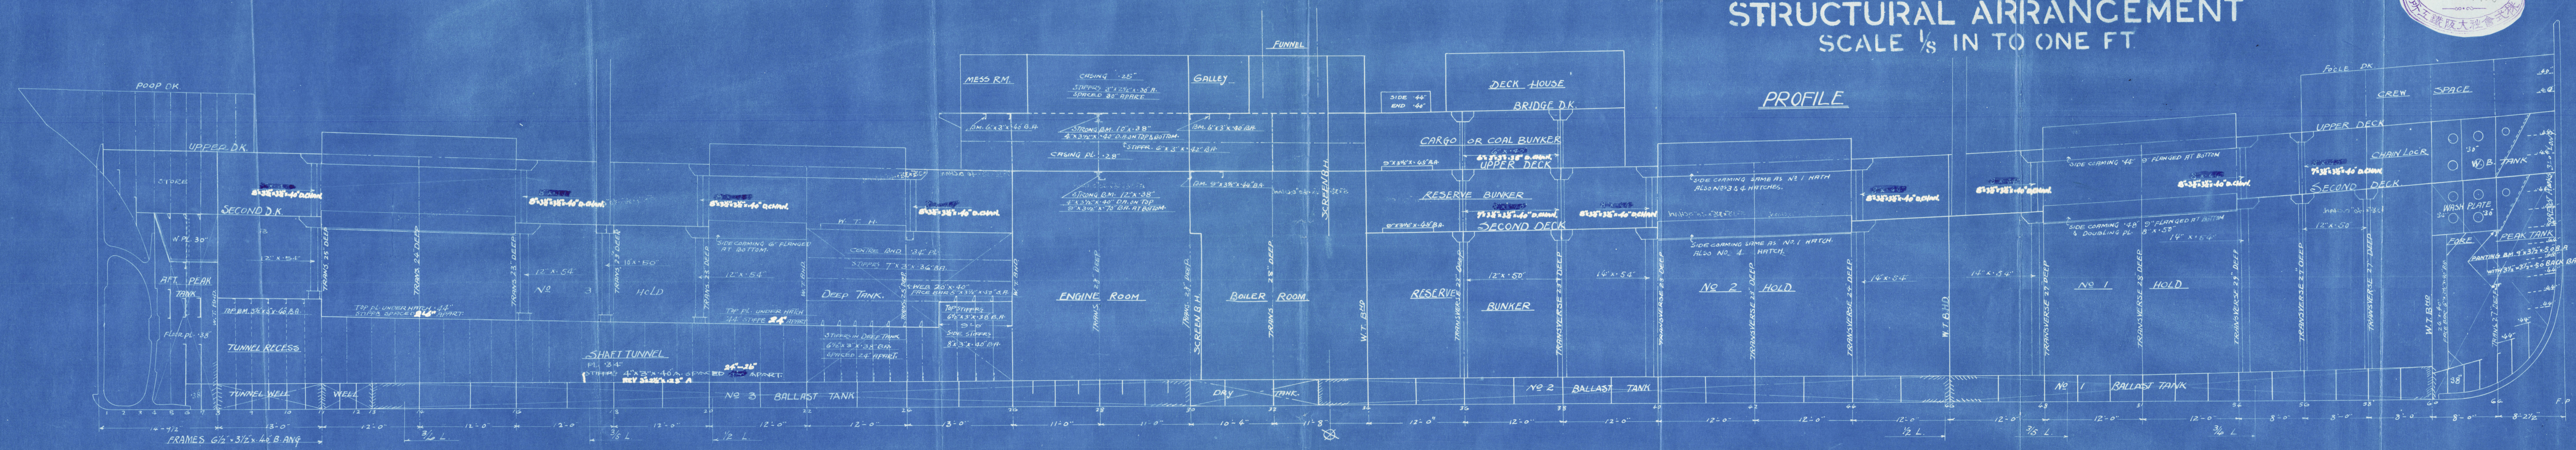

Osaka Inm marks  
Vessel 932.  
"Genzan Maru"  
Profile.

Kobe Rpt No 2226

RECEIVED  
12 JUN 1918  
LONDON

W678-0103



Genzan Maru.  
Profile



© 2021

Lloyd's Register  
Foundation