


2.11.05
10.11.05
25.11.05
18.12.05
8.3.06

"Edmiran" - "Blamorgan" - "O.A. Knudsen"
S.S. Nos 117, 120 & 121
LONGITUDINAL SECTIONS, SCALE 1/8" = 1'.

See amended profile Edmiran

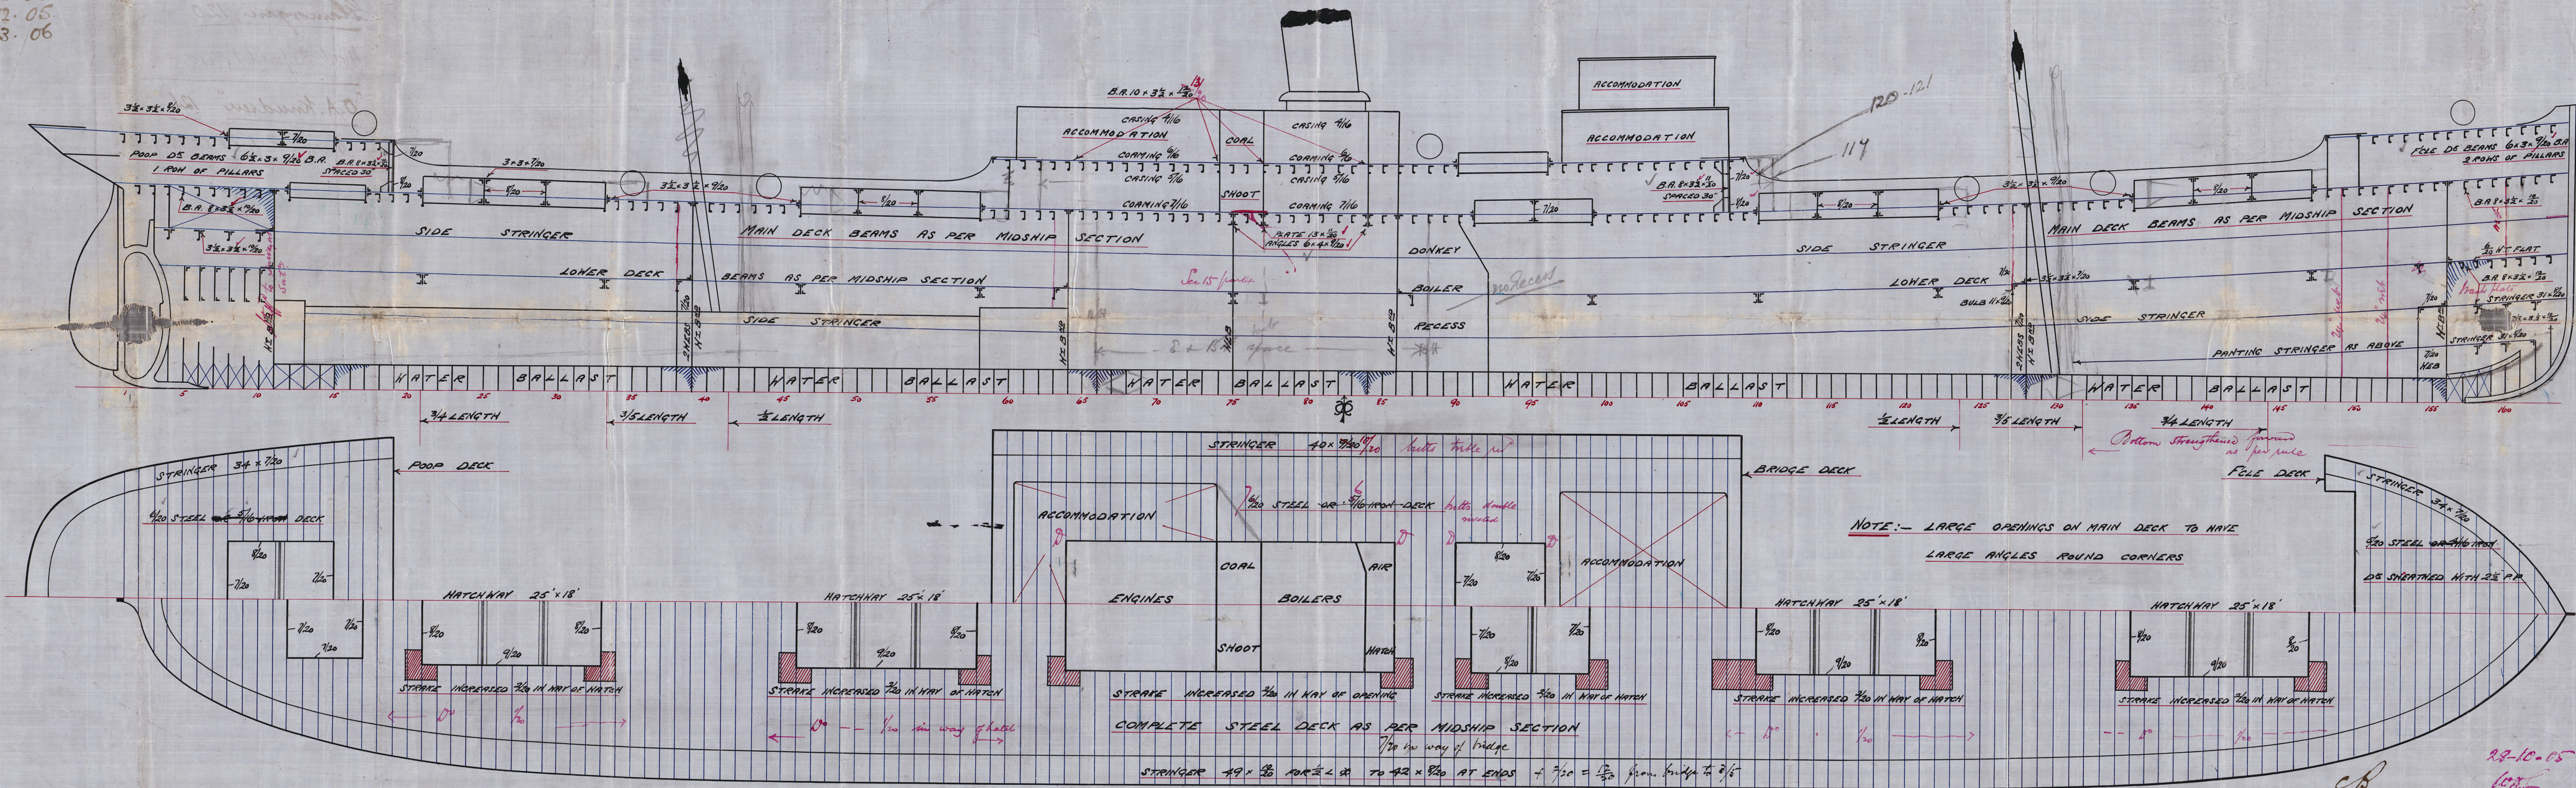

NOTE: - LARGE OPENINGS ON MAIN DECK TO HAVE
LARGE ANGLES ROUND CORNERS

C.B.
2.11.05.

28.10.05

Craig Taylor

No 117, 120 + 121

Profile & Deck plans

"Edernian" 117

Mar Report No 4732

Glamorgan 120

Mar Report No 4815

"O.A. Knudsen" 121

Mar Report No 4888



© 2021

Lloyd's Register
Foundation