


27. 8. 09.
9. 9. 09
20. 9. 09.
72. 9. 09.
30. 9. 09
12. 10. 09
30. 10. 17.
8. 11. 09.
70. 11. 09
23. 12. 09.
12. 3. 10.
18. 3. 10

SCALE $\frac{1}{2}$ = 1. FOOT.

CLASS. 100.A.I. LLOYDS, SHELTER DECK.

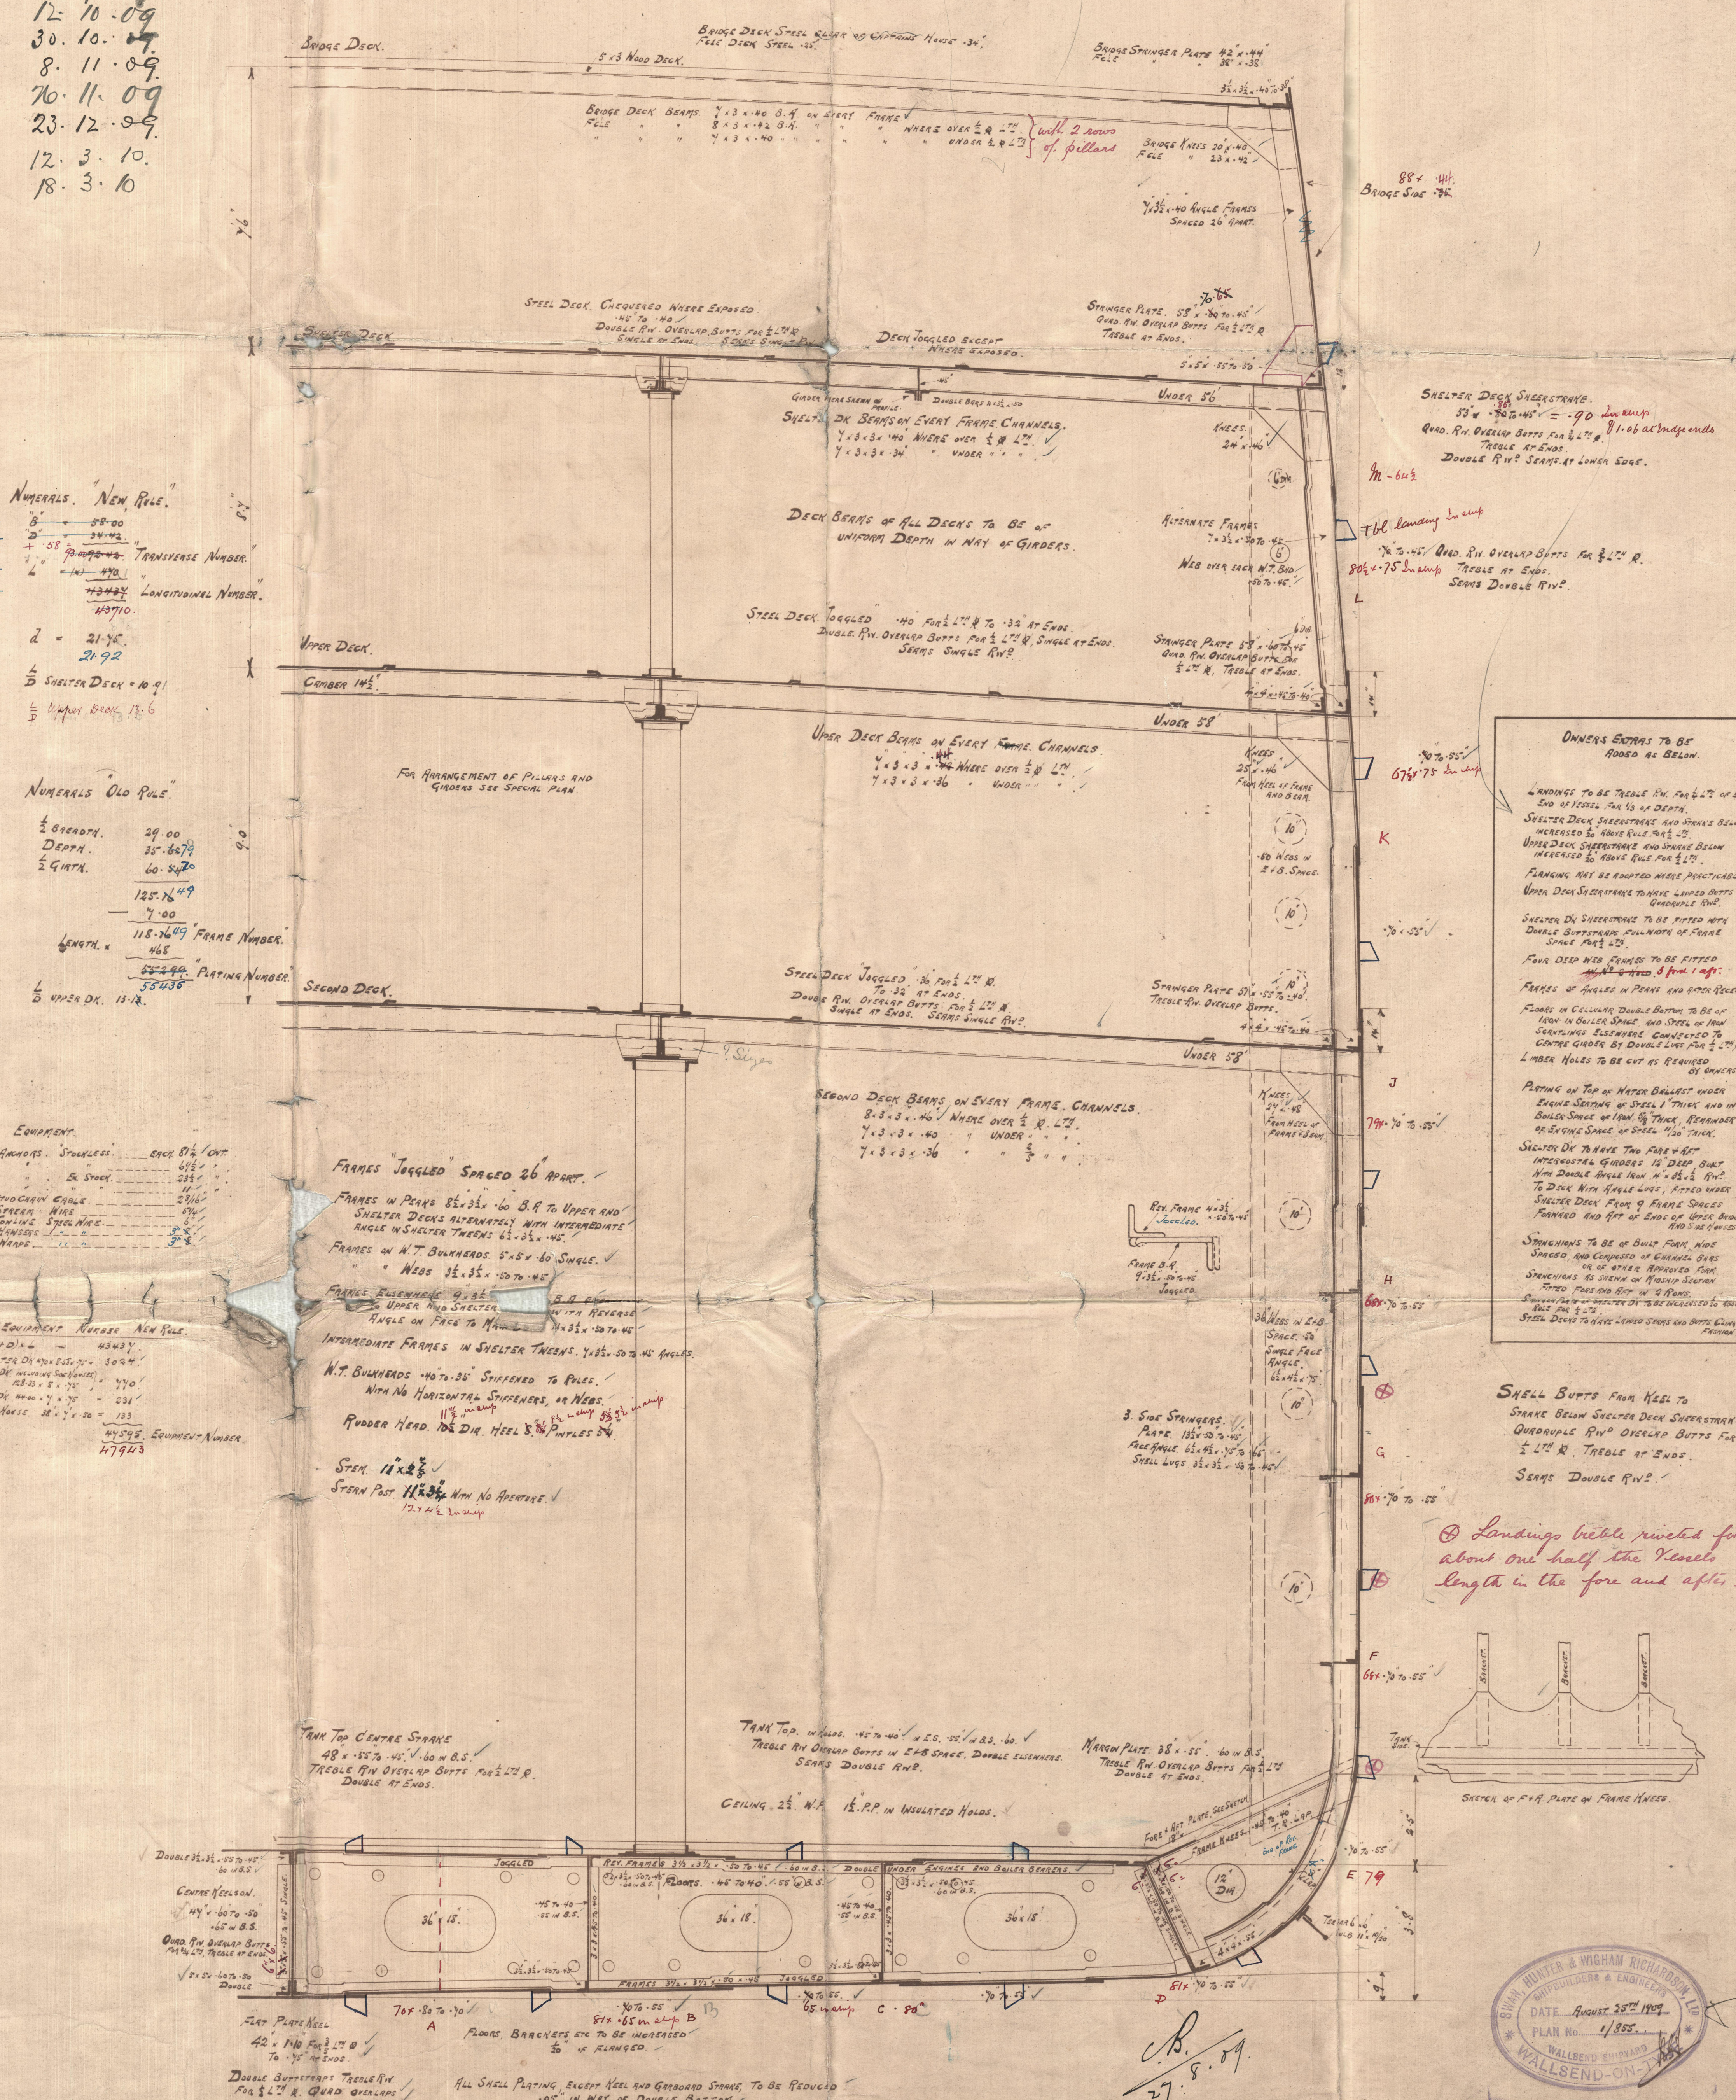

OWNERS EXTRAS TO BE
ADDED AS BELOW.



















SHELL BUTTS FROM KEEL TO
STAKE BELOW SHELTER DECK SHEERSTAKE
QUADRUPLE RIV^d OVERLAP BUTTS FOR
 $\frac{1}{2}$ 1TH \times TREDLE AT ENDS.
SEAMS DOUBLE RIV^d.

④ Landings trille riveted for about one half the vessels length in the fore and after bodies

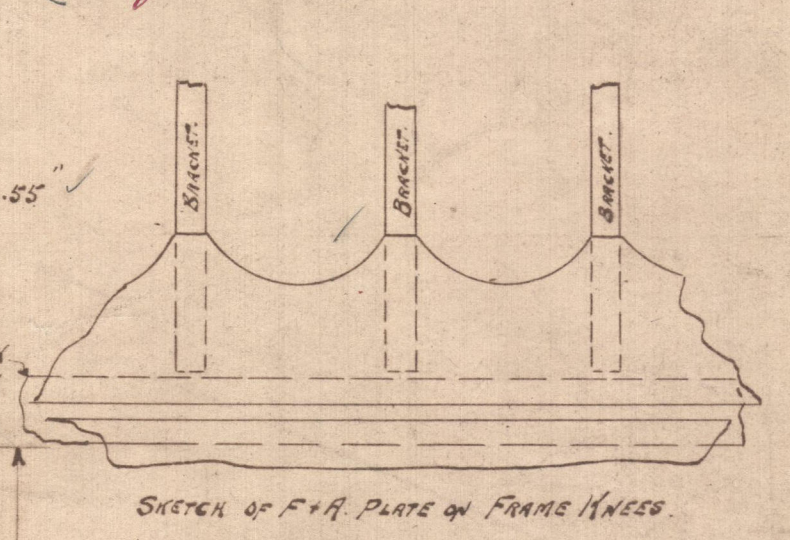

SWAN, HUNTER & WIGHAM RICHARDSON LTD.
SHIPBUILDERS & ENGINEERS
DATE August 25th 1909
PLAN No. 1/355
WALLSEND SHIPYARD
WALLSEND ON-1855

© 2020
Lloyd's Register
Foundation
W 622-0144

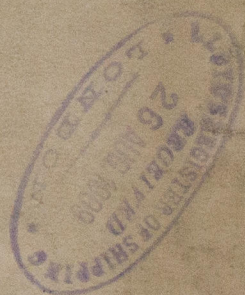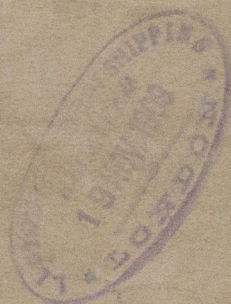

© 2020

Lloyd's Register
Foundation

Messrs Swan Hunter & Wyham Richardson

T. S. S. 855

Midship Section











Indrabarah

T. S. S. "INDRABARAH"

NEWCASTLE ON TYNE.

REPORT No

RECEIVED

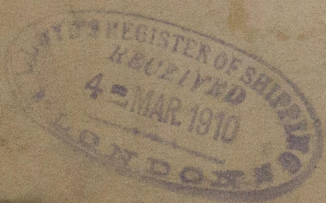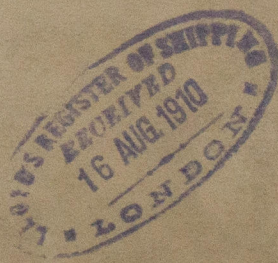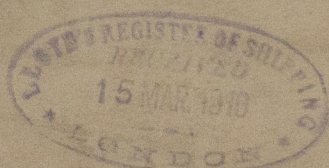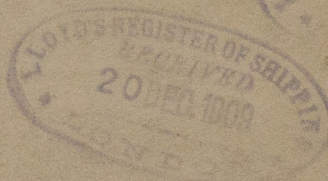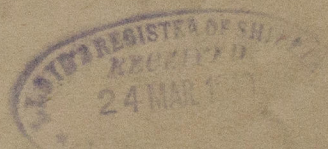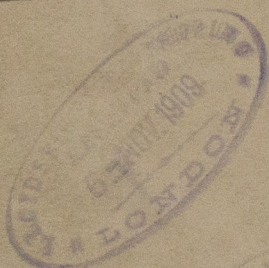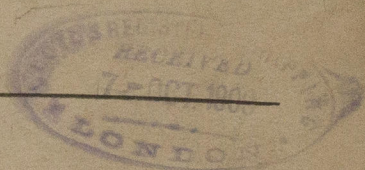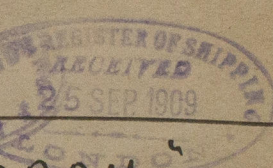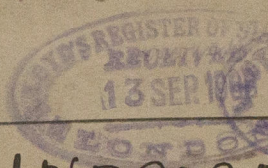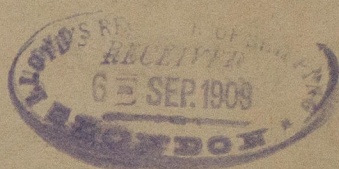

© 2020

Lloyd's Register Foundation