


Vertical multitubular boiler of a heating surface of 45 square meters and a working pressure of 7 atm. test pressure 14 atm.

Boiler no. 8823 u. 8824.

Scale: 1:15



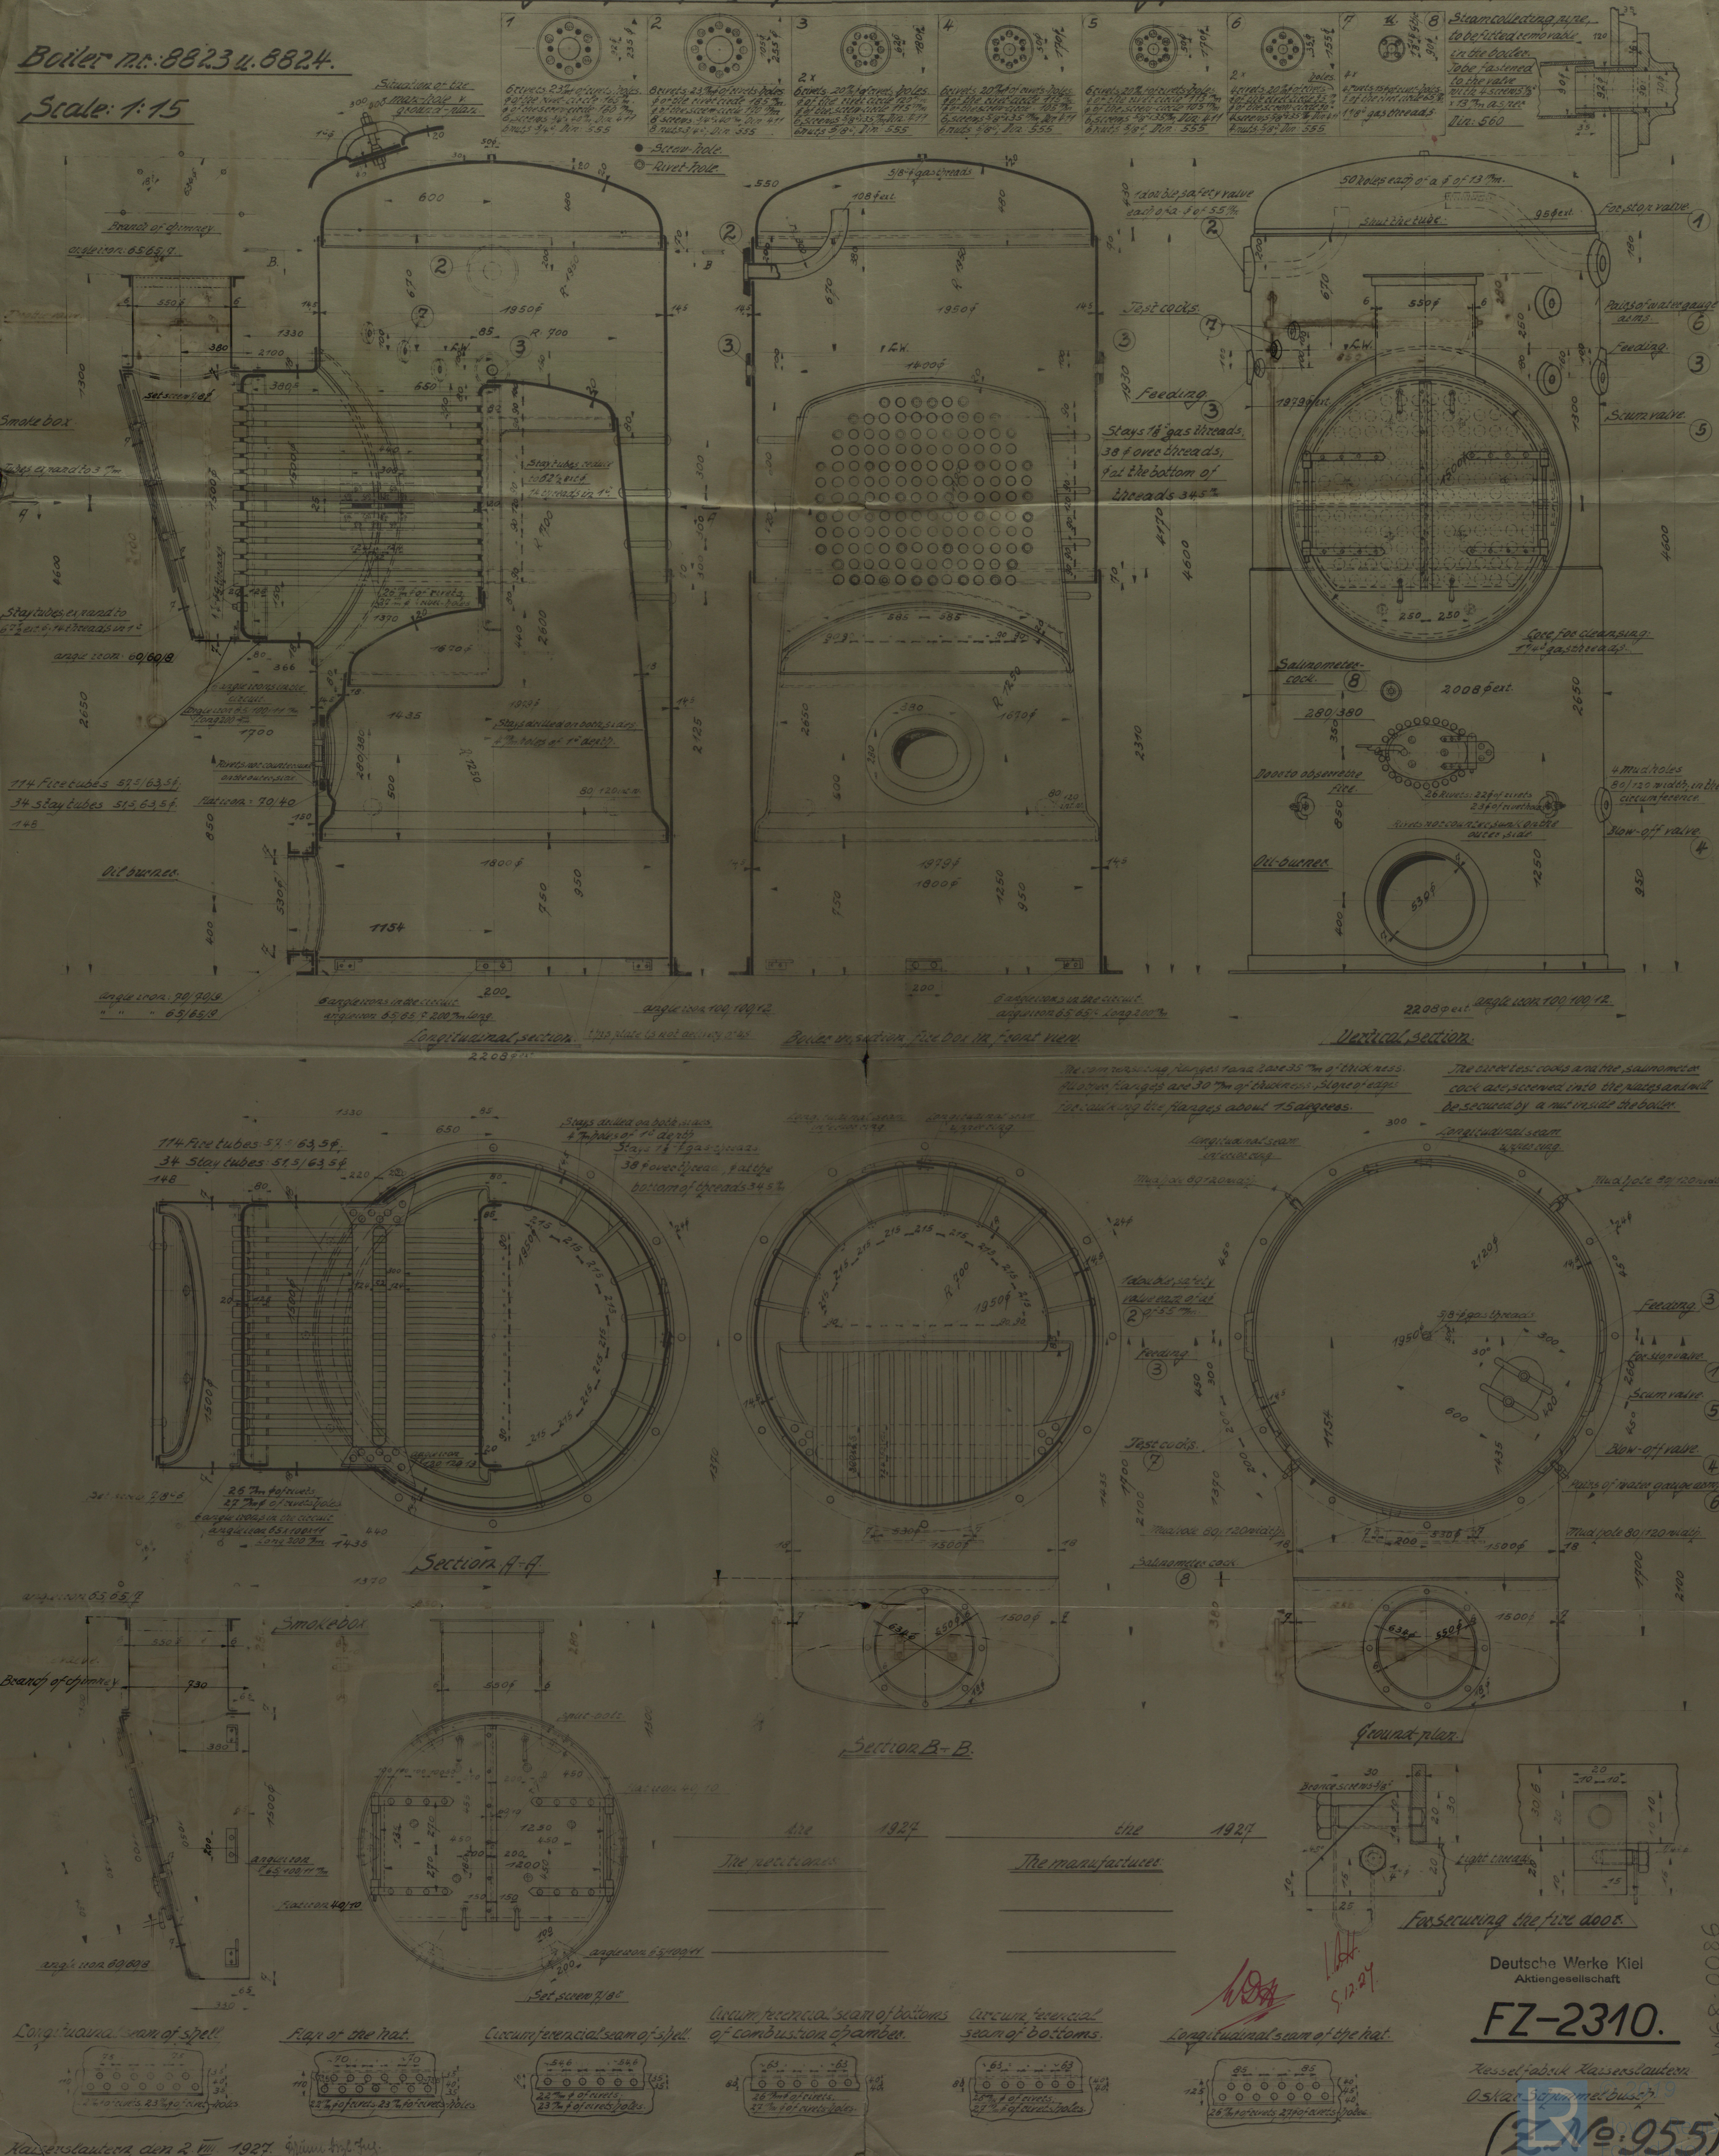

U.S. "PACIFIC PRESIDENT"  
HAM RPT NO 17971.

M.S. "PACIFIC GROVE"

Vertical Donkey Bailer  
Deutsche Werke's No. 212/3  
Hamburg letter 2. 12. 1927.

~~CUBLOXNE 797~~