
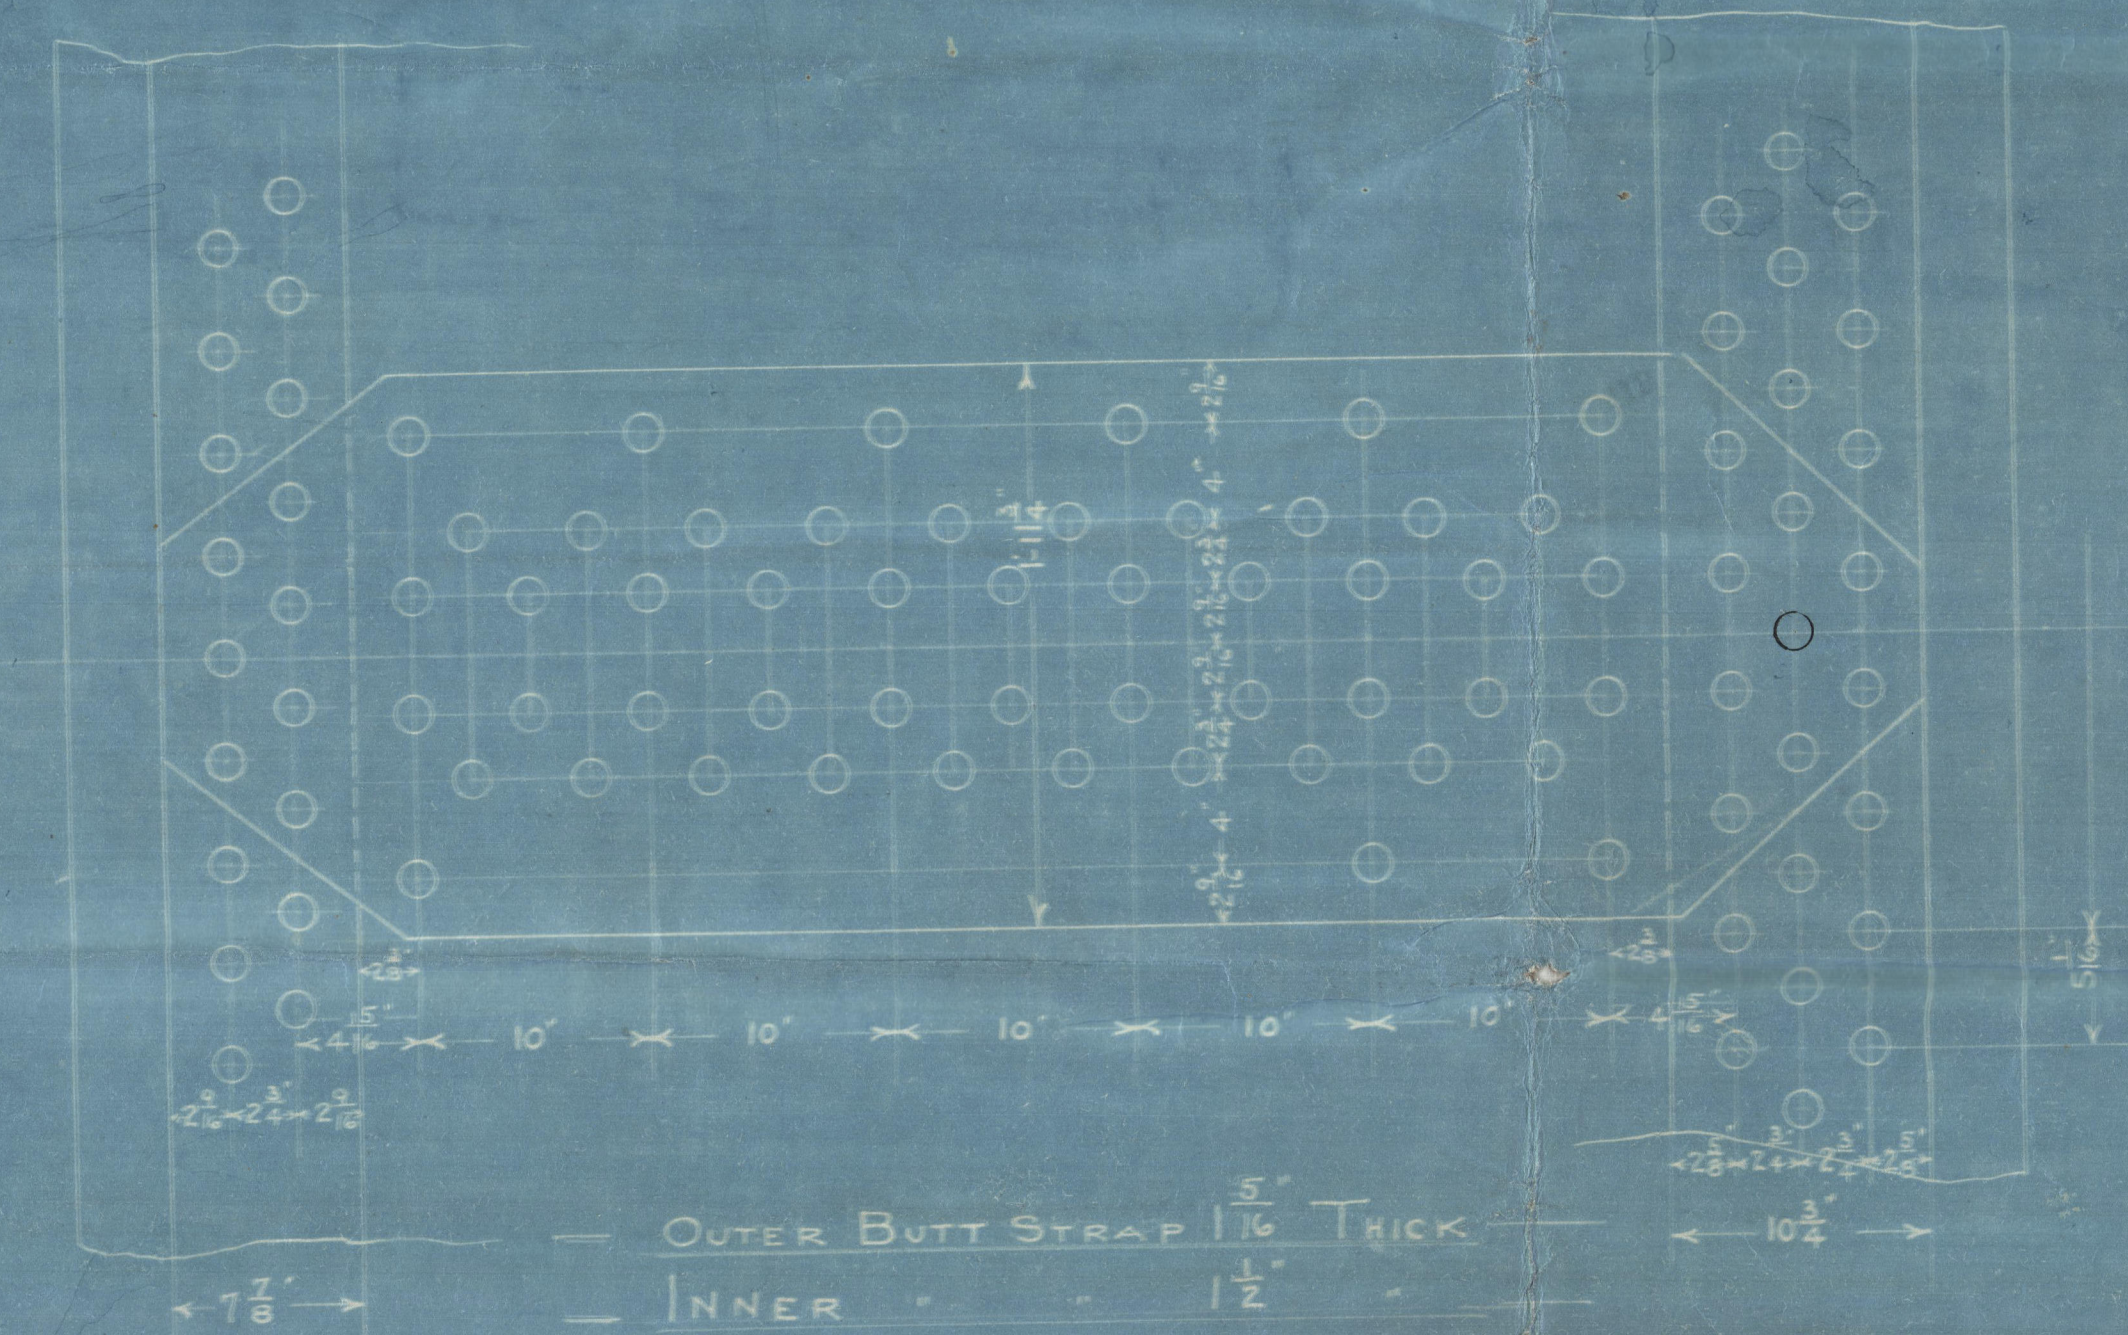
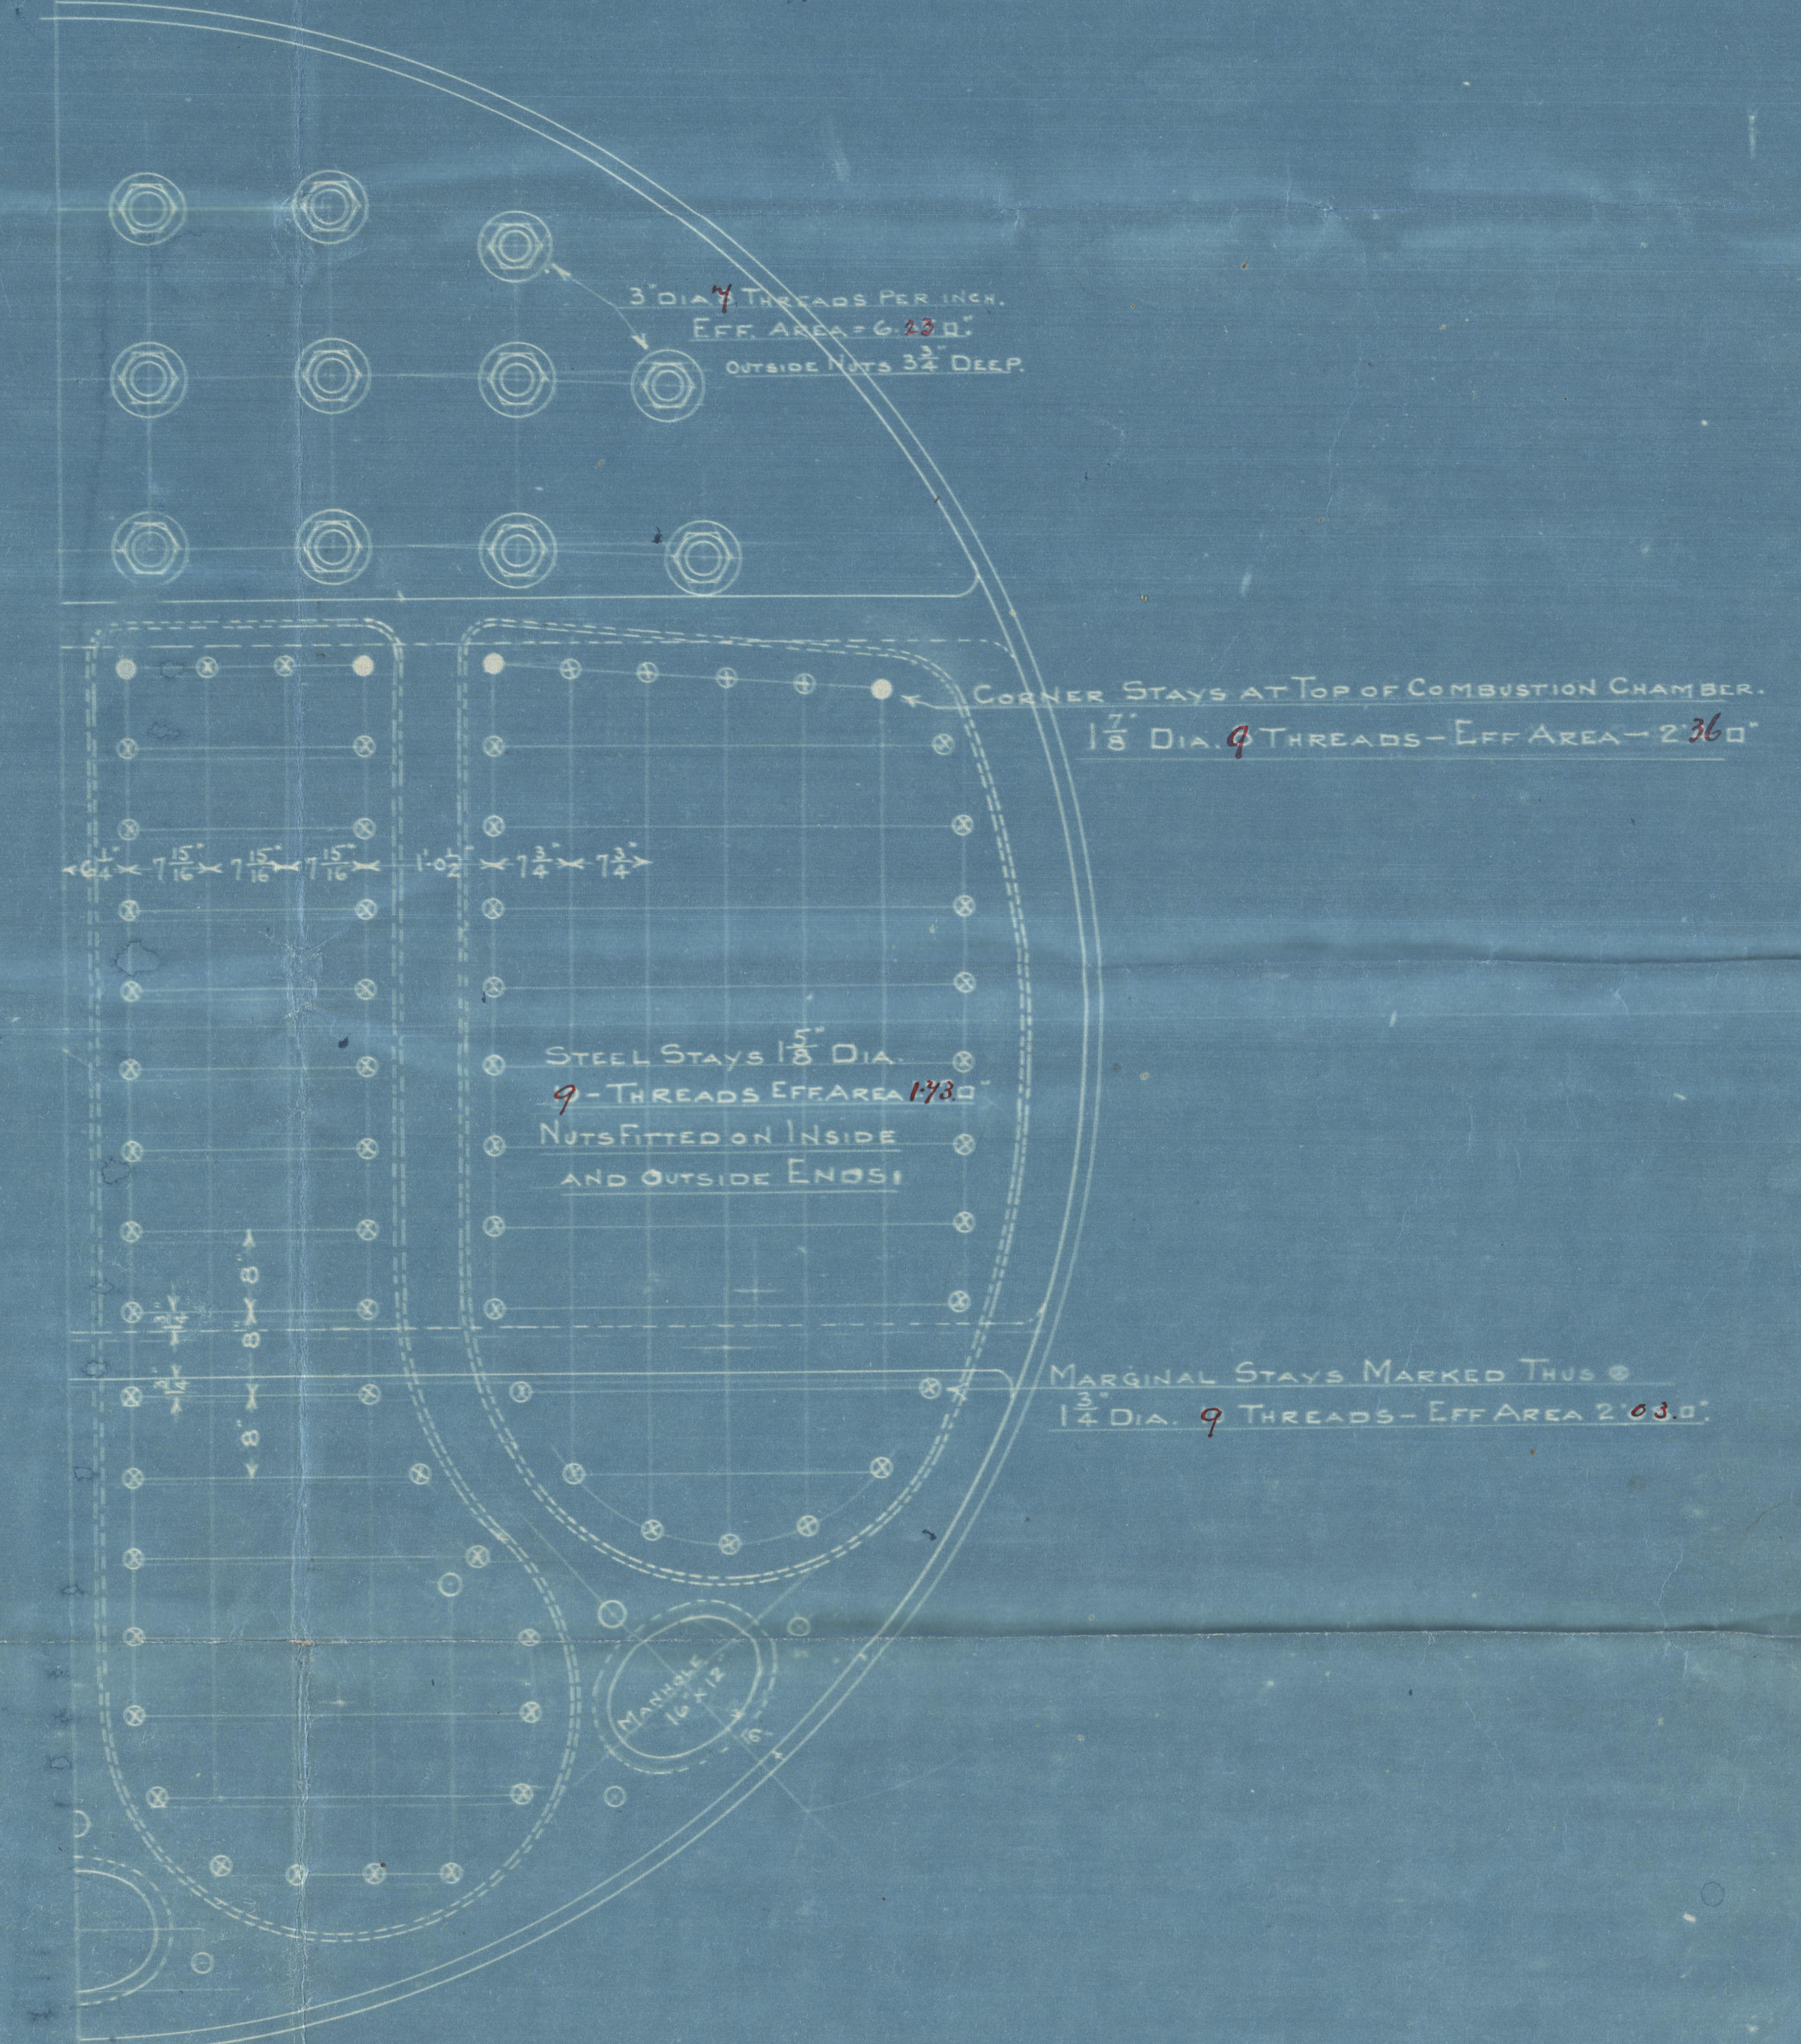


20/11/09  
FORWOT

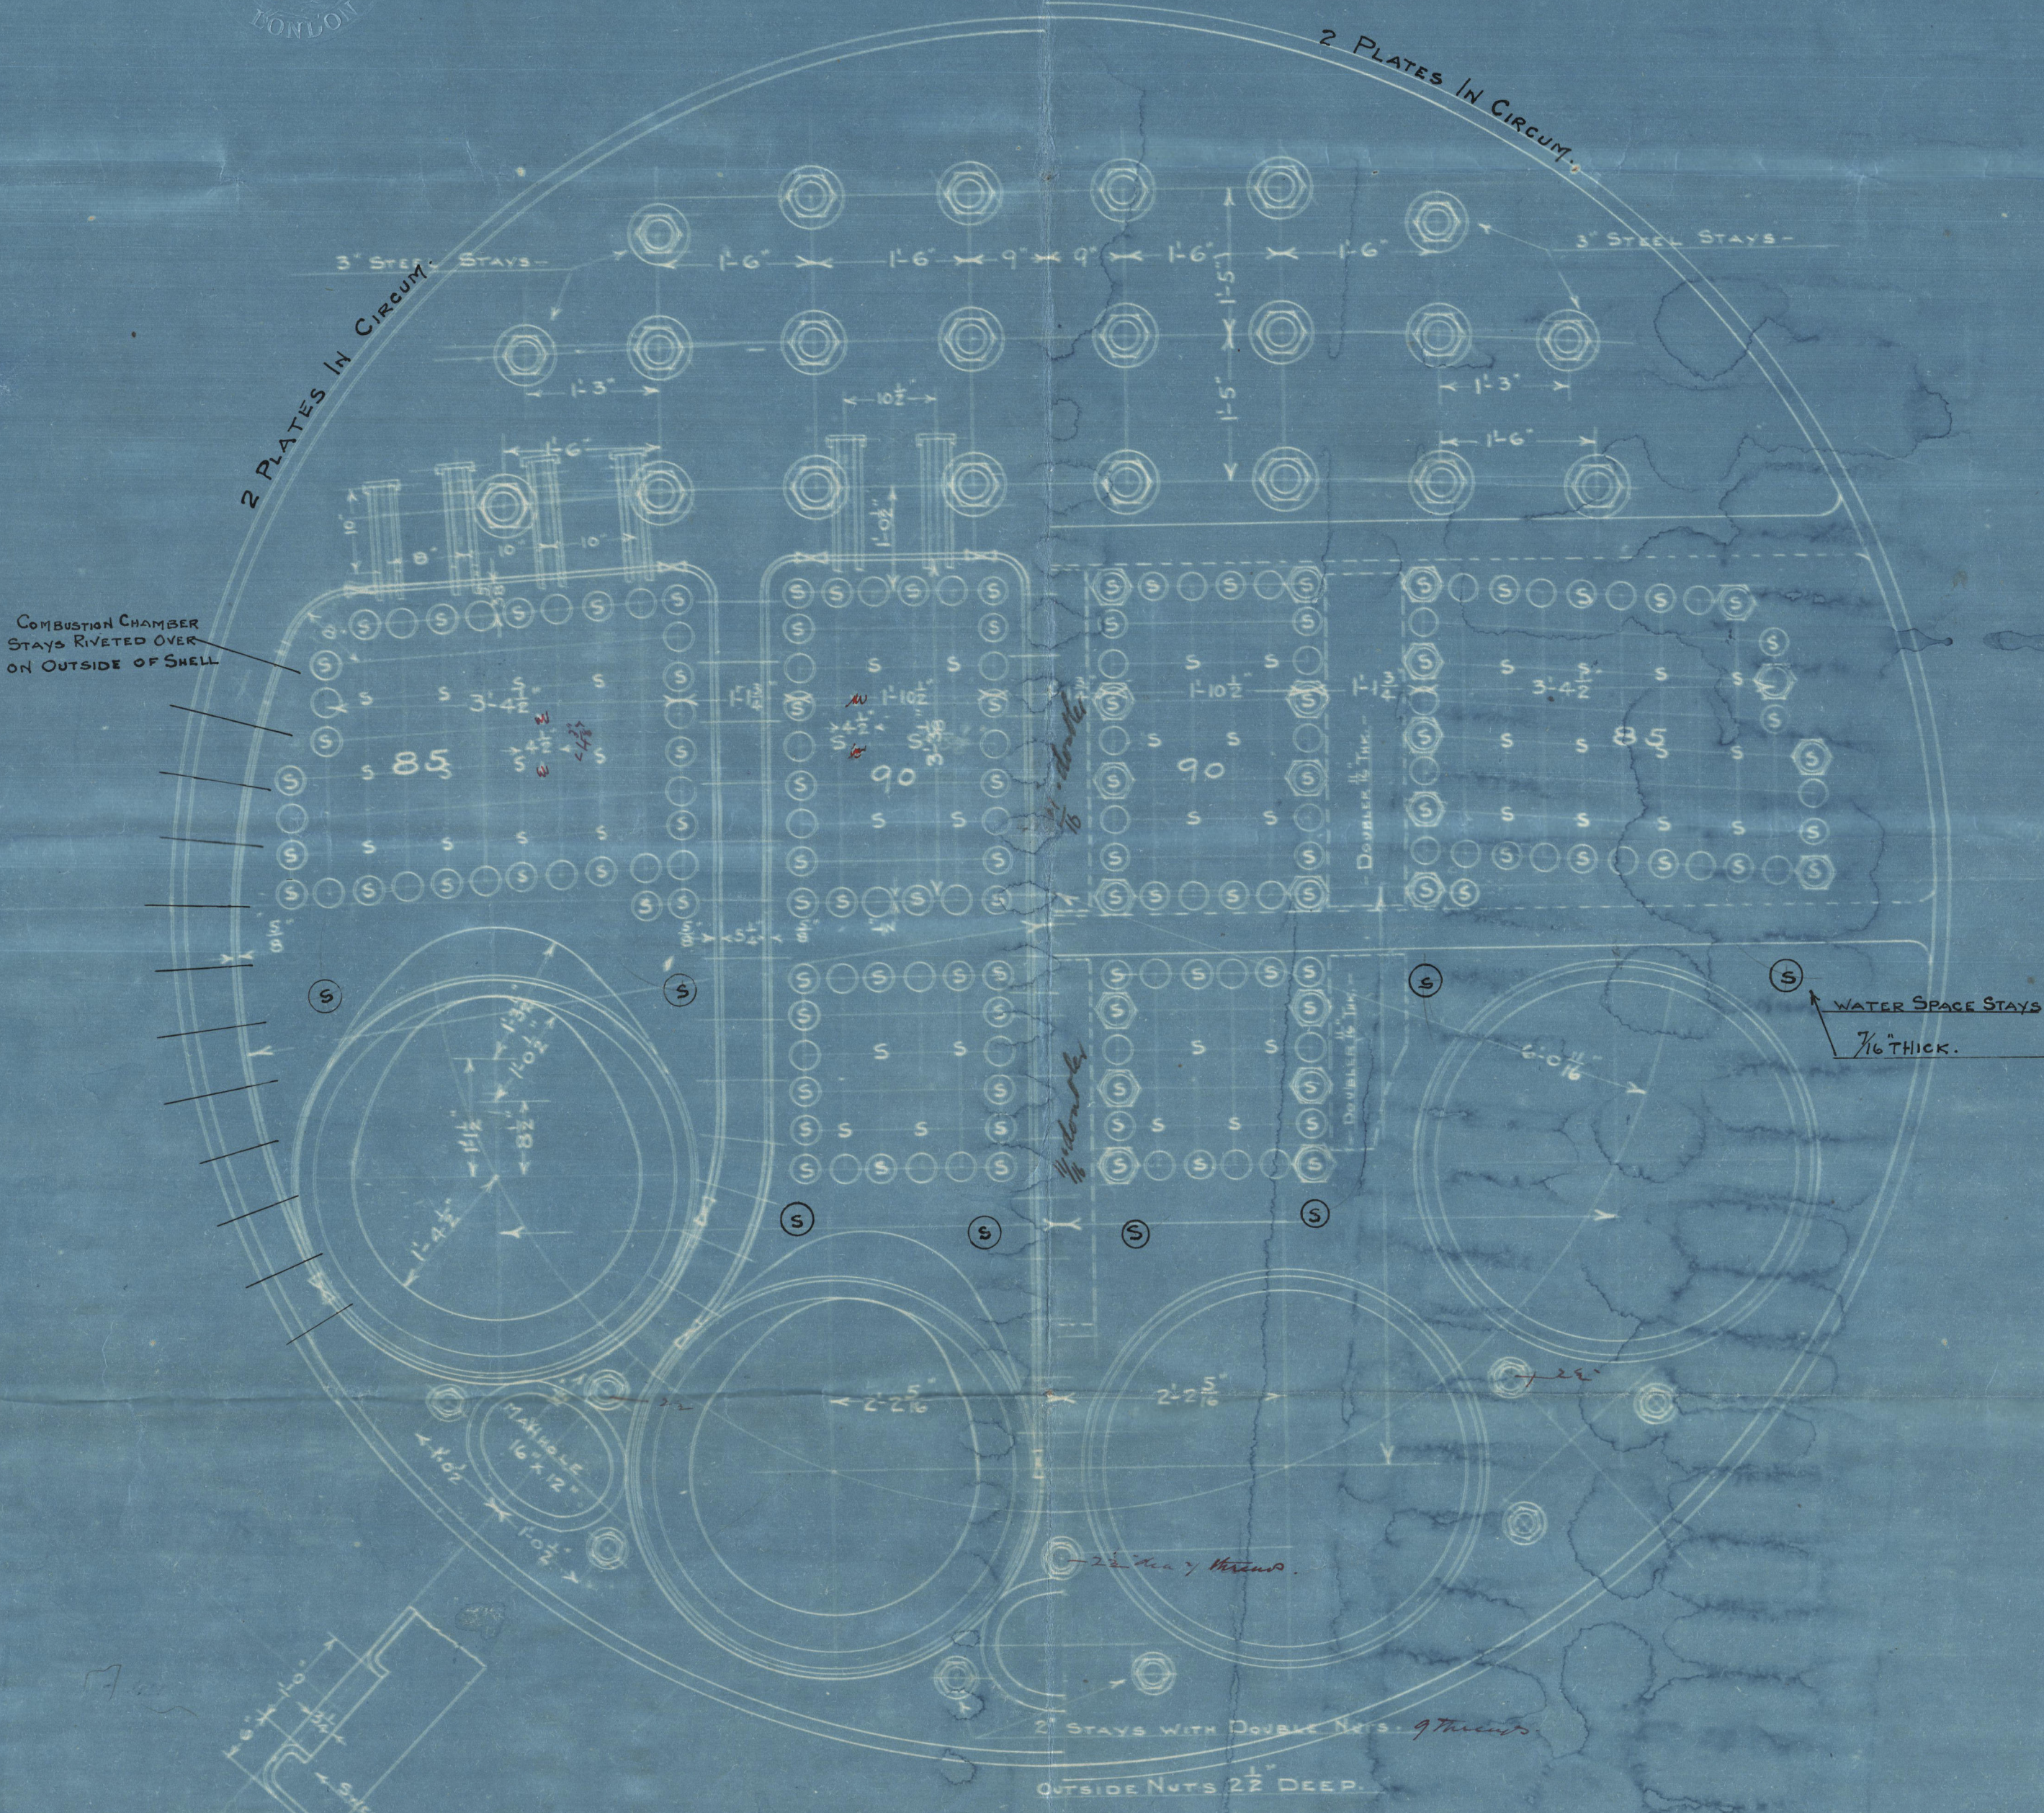

W.L.H.  
19/11/09

LONGITUDINAL SEAMS.	1 1/16" HOLES - PLATE PERCENTAGE 83.12 5%
	10" PITCH - RIVET " 86%
	OUTER BUTT STRAP - 1 1/16" - INNER BUTT STRAP 1/2" THK
CIRCUMFERENTIAL SEAMS - END	1 1/16" HOLES - PLATE 60.2%
	4 1/2" PITCH - RIVET 46.28%
CIRCUMFERENTIAL SEAMS - CENTRE	1 3/32" HOLES - PLATE 64.81%
	5 1/16" PITCH - RIVET 65%

TENSILE STRENGTH OF SHELL 31 TO 33 TONS PER SQ.  
ALL STEEL EXCEPT TUBES.  
TO PASS BOARD OF TRADE AND LLOYD'S SURVEY  
FOR 210 LBS WORKING PRESSURE.

HEATING SURFACE OF TUBES = 2380  
" " OTHER 670  
" " TOTAL 3050


GRATE AREA (6' 0" BARS) - 87 sq

- 1 - OFF EACH - (NATURAL DRAUGHT) SCALE 3/4" = 1 FOOT

- JOB NOS 292-3-4. -

J.P.P.  
20/11/09

28/11/09

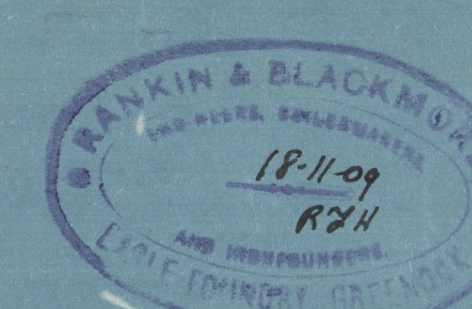



No. 616. *S. Highland Glen*  
Greenock Reprint No. 15201