

*Dispersal of person  
approved for M032504 Bureau*

*W.R.H.  
22/12/77*

23.12.09

SCALE:  $\frac{3}{4}" = 1 \text{ FOOT}$

J.M.  
23/12/09

RANKIN & BLACKMORE  
ENGINEERS, BOILERMAKERS,  
AND IRONFOUNDERS  
EAGLE FOUNDRY, ARDENLEY  
16-12-09  
R.F.H.

W 680- 0078



Muller & Co. main Books

Nº 292-3-4

by

Rankin & Blackmore


for

Russell 869 Nº 614-5-6.

210 lbs working pressure

nº 615



S	922	S. 930	S. 940
SC	928	SC 939	SC 947
PC	934	PC 932	PC 936
P	937	P 948	P 938

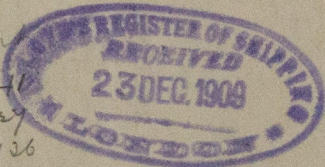

No. 614. S.S. Highland Corrie  
Greenock Report No. 15842

No. 615. S.S. Highland Scot  
Greenock Report No. 15869

No. 616. S.S. Highland Glen  
Greenock Report No. 15901.

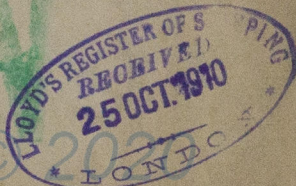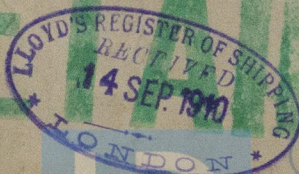

RETAIN

R

Lloyd's Register  
Foundation

W6860078