



90.9645.

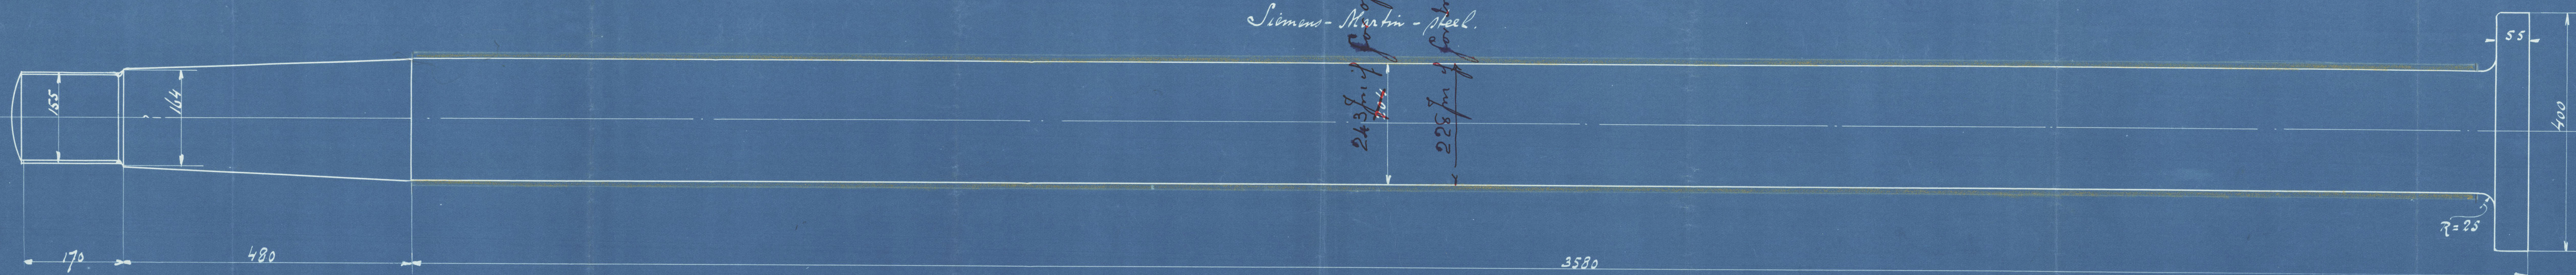


Siemens-Martin-steel.

243 $\frac{1}{16}$ for open sea service
228 $\frac{1}{16}$ for smooth water service

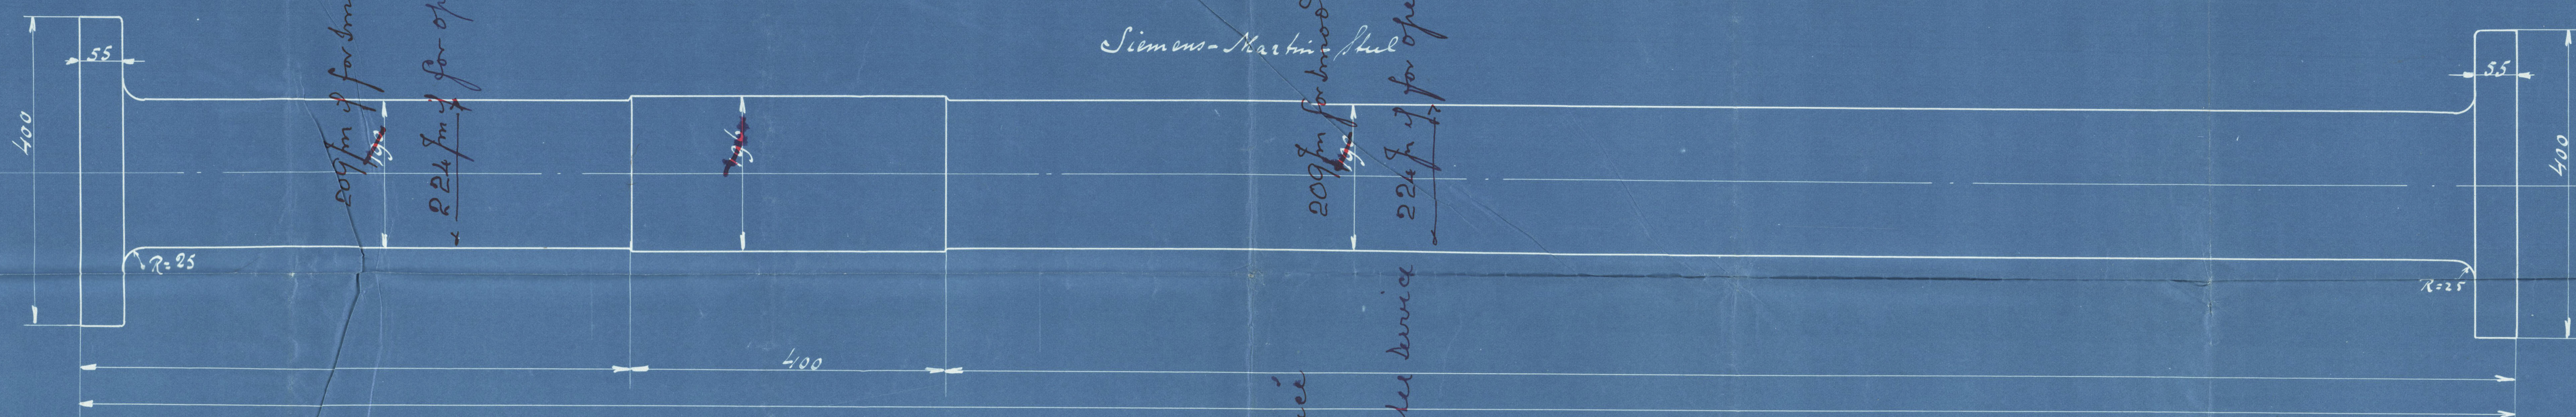

Siemens-Martin-steel

209 $\frac{1}{16}$ for smooth water service
224 $\frac{1}{16}$ for open sea service

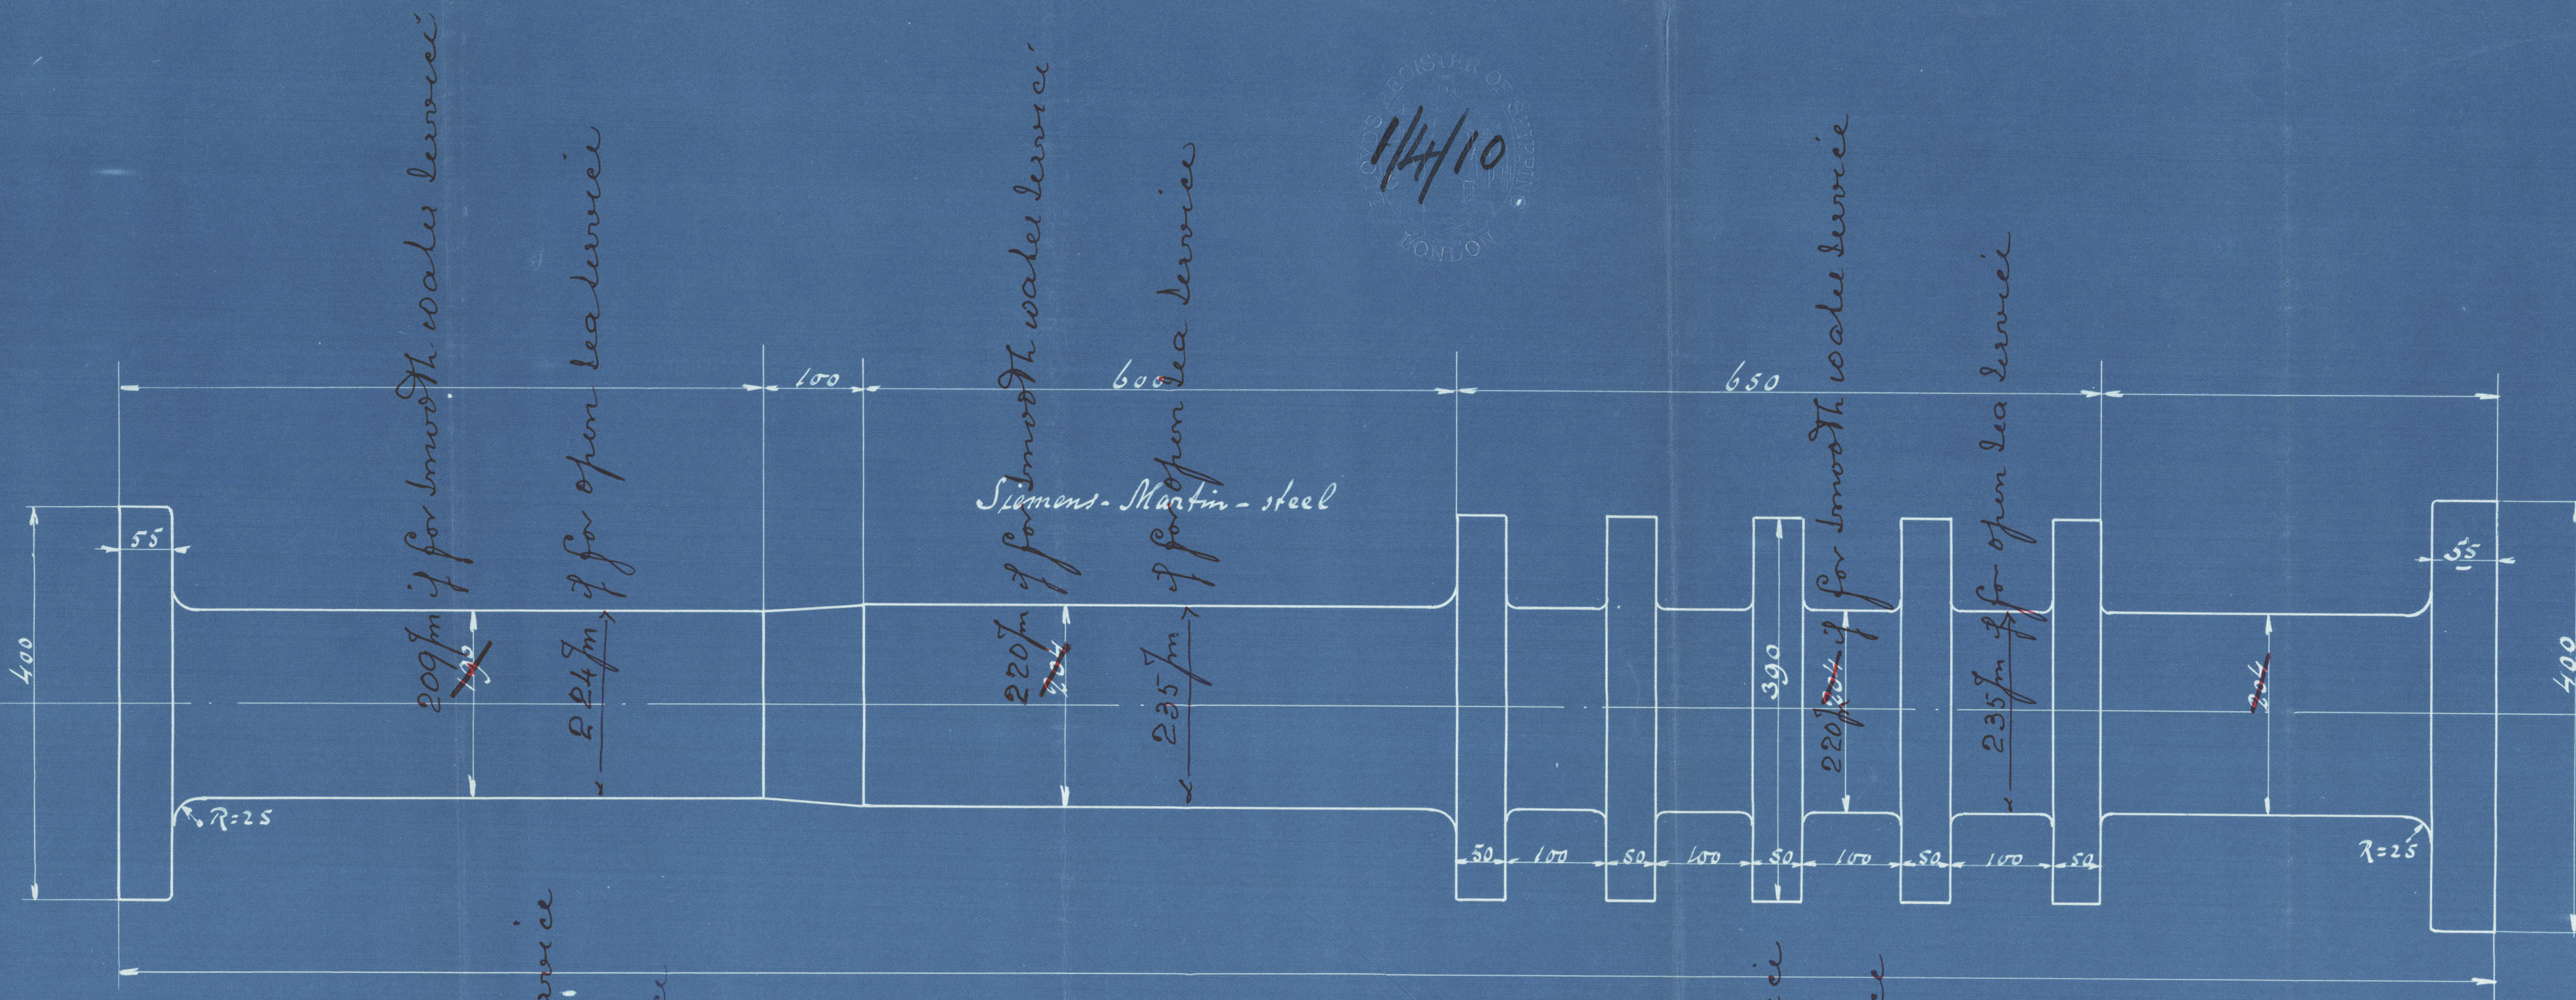


1/4/10

209 $\frac{1}{16}$ for smooth water service
224 $\frac{1}{16}$ for open sea service
220 $\frac{1}{16}$ for smooth water service
235 $\frac{1}{16}$ for open sea service

A.P.R.
31.3.10

Assen voor Motor-lichter.



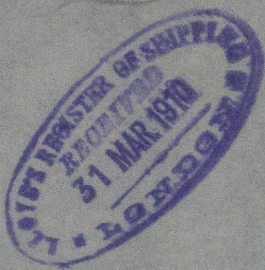

Red Fabrick
Amsterdam

Screen, tunnel and Thrust Shaf
Motor No. 103

Screen Tunnel &
Thrust Shaf

to Vuleaans
20 MAR 1910
Ams 910



© 2020

Lloyd's Register
Foundation

W680-0201