


1.4.10  
3.5.10  
23.6.10.

# No. 109. Steel Motor-Tanklighter. Longitudinal- & Deckplans. 196'-0"x37'-9"x13'-2 1/2". Scale 1:96.

Lloyd's numbers for class 100.A.1


Breadth	37' 5 1/2"
Depth	13' 2"
B+D	50' 9 1/2"
Length	196'
2 <sup>nd</sup> number	9986

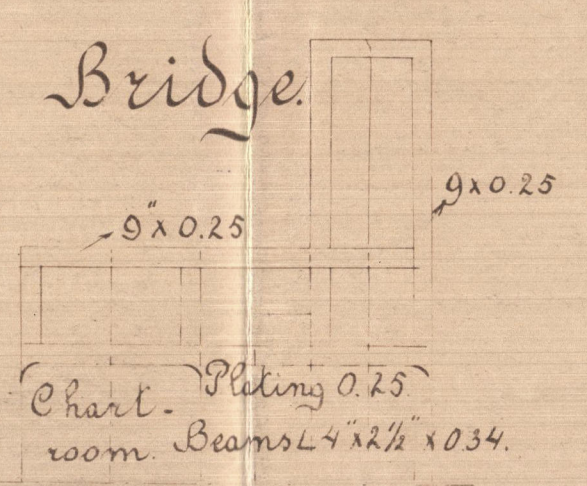


Equipment

Plating number	9986
Loop, Trunk & Telle	251
Deckhouse aft	170
Equipment number	11007
3 Stockless bowers coll weight	66 3/4 cwt
1 Stream anchor with stock	7 1/2 "
1 Bidge	3 3/4 "
210 Fathom 1 1/16 strand chain cable	222-1 1/2 "
60 3 1/2" steel wire for stream anchor	
90 3 1/4" low line	
90 6 circ manilla for hawsers	


Longitudinal section.

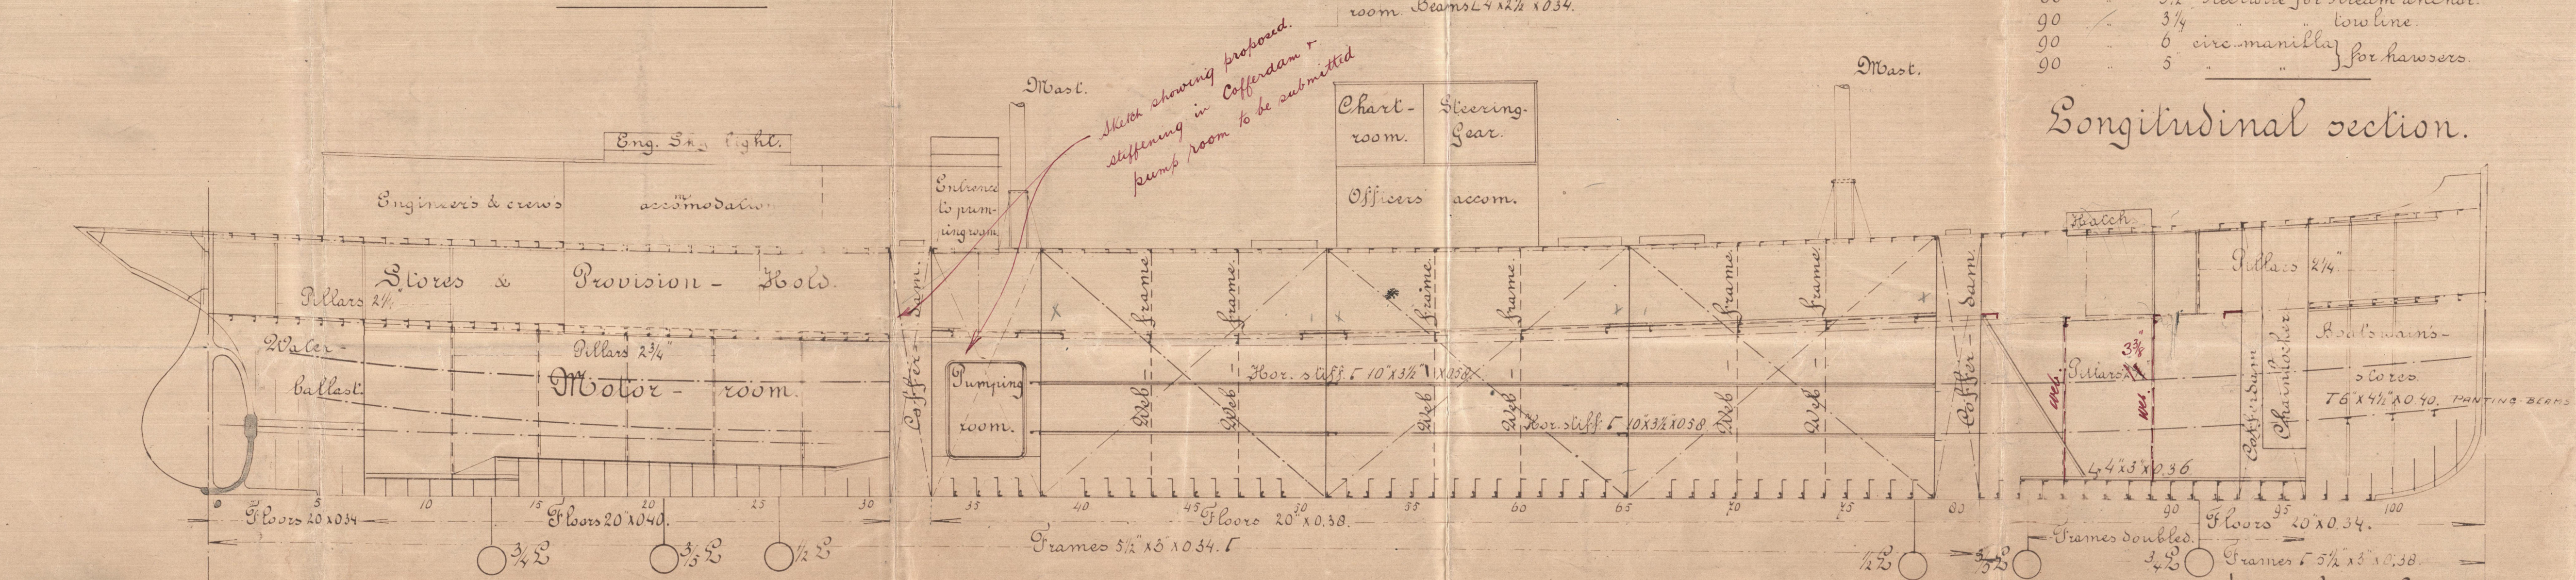


Trunk Deck.

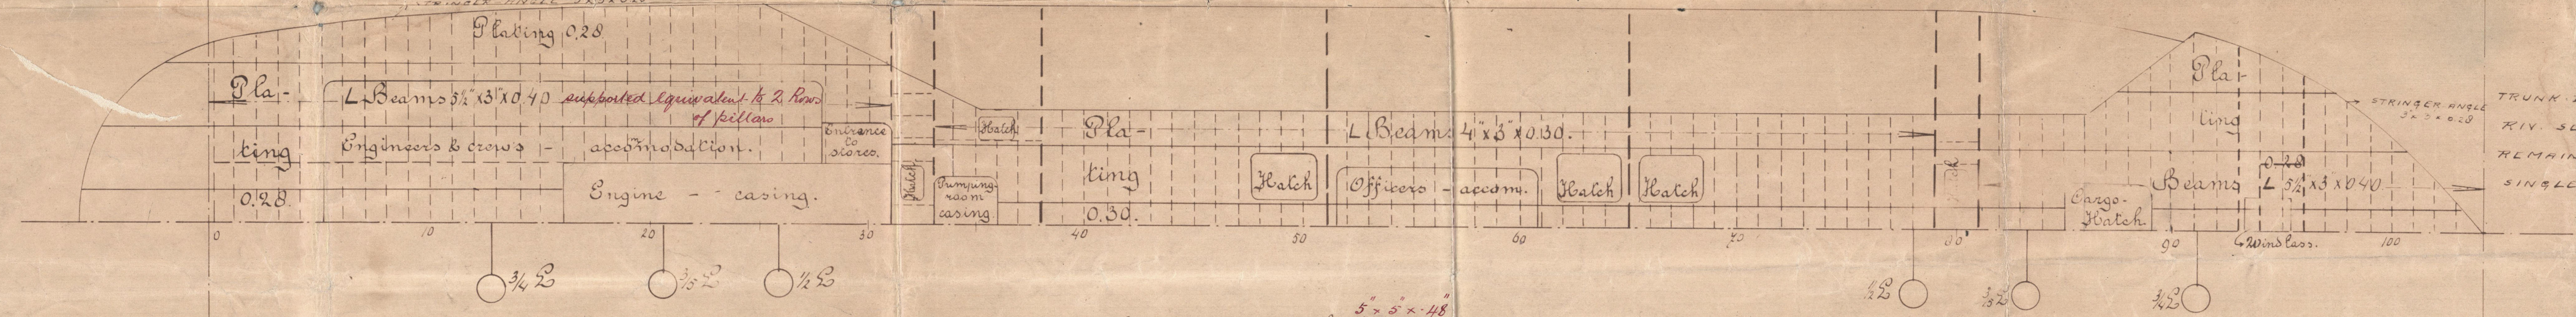

RIVETING  
TRUNK DECK PLATING DOUBLE  
RIV. SEAMS & BUTTLAPS  
REMAINING DECK-PLATING  
SINGLE RIV SEAMS & BUTTLAPS

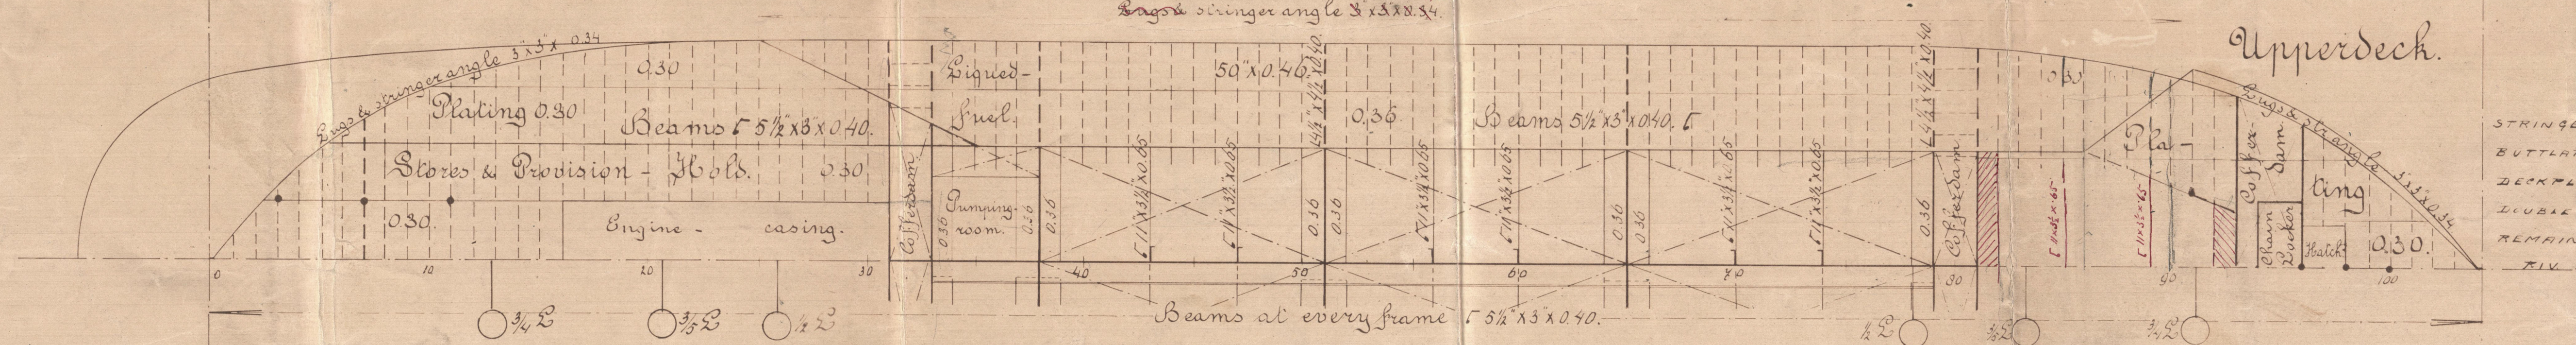

RIVETING  
STRINGER-PLATE TREBLE RIV.  
BUTTLAPS FOR 1/2 L DOUBLE ATTENDS  
DECK PLATING ABOVE OIL TANKS  
DOUBLE RIV SEAMS & BUTTLAPS  
REMAINING DECK PLATING SINGLE  
RIV SEAMS & BUTTLAPS

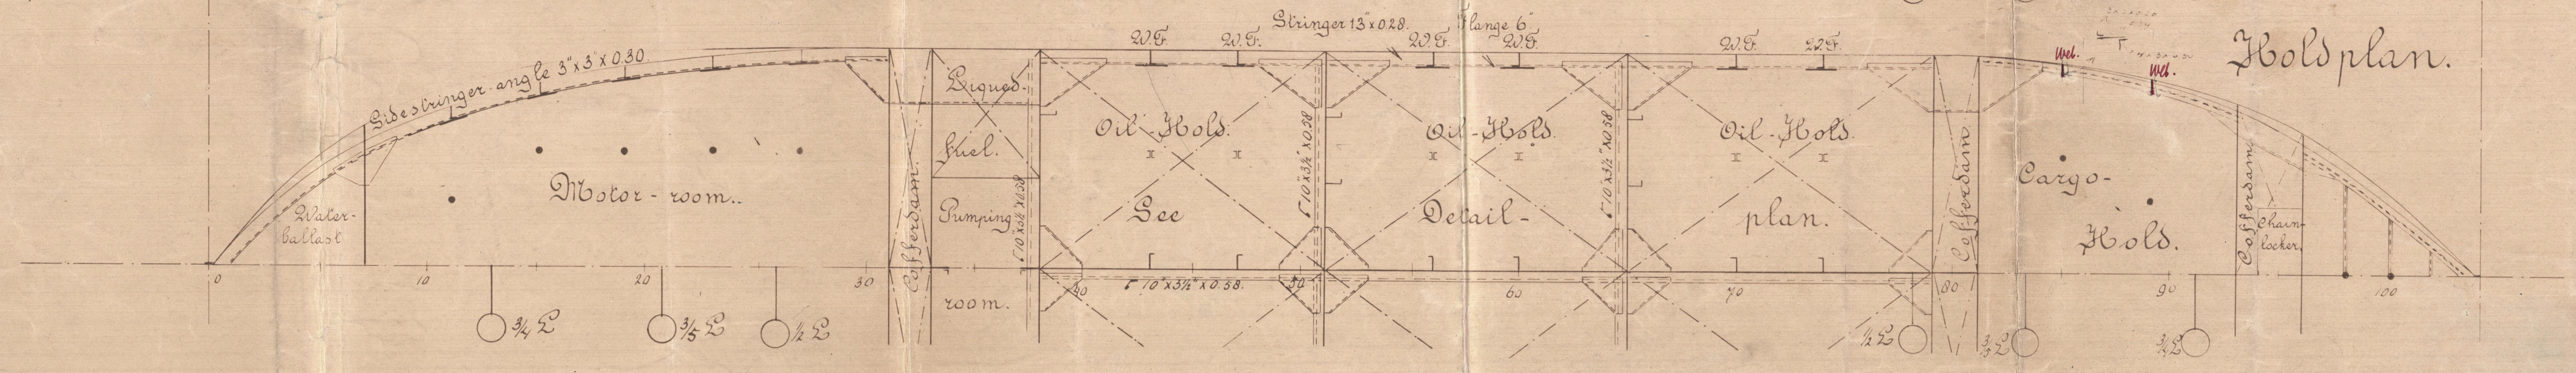


Hold plan.

27  
1/4/10






N. I. M. No 109

Longitudinal plane

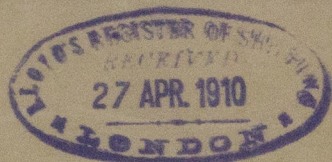


Vulcanis

Ans. 4710.

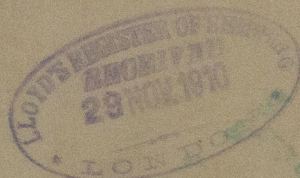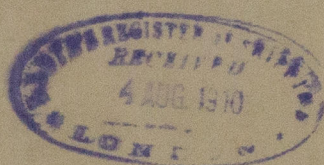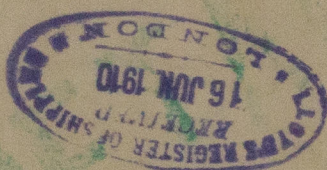

Longitudinal plane  
No 109

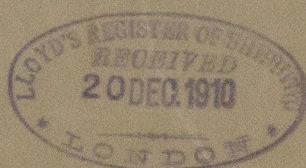

© 2020

Lloyd's Register  
Foundation

N680-0.202



109



© 2020

Lloyd's Register  
Foundation