


23-610


196'-0" x 37'-9" x 13'-2 1/2".

Scale $\frac{1}{2}'' = 1'-0''$

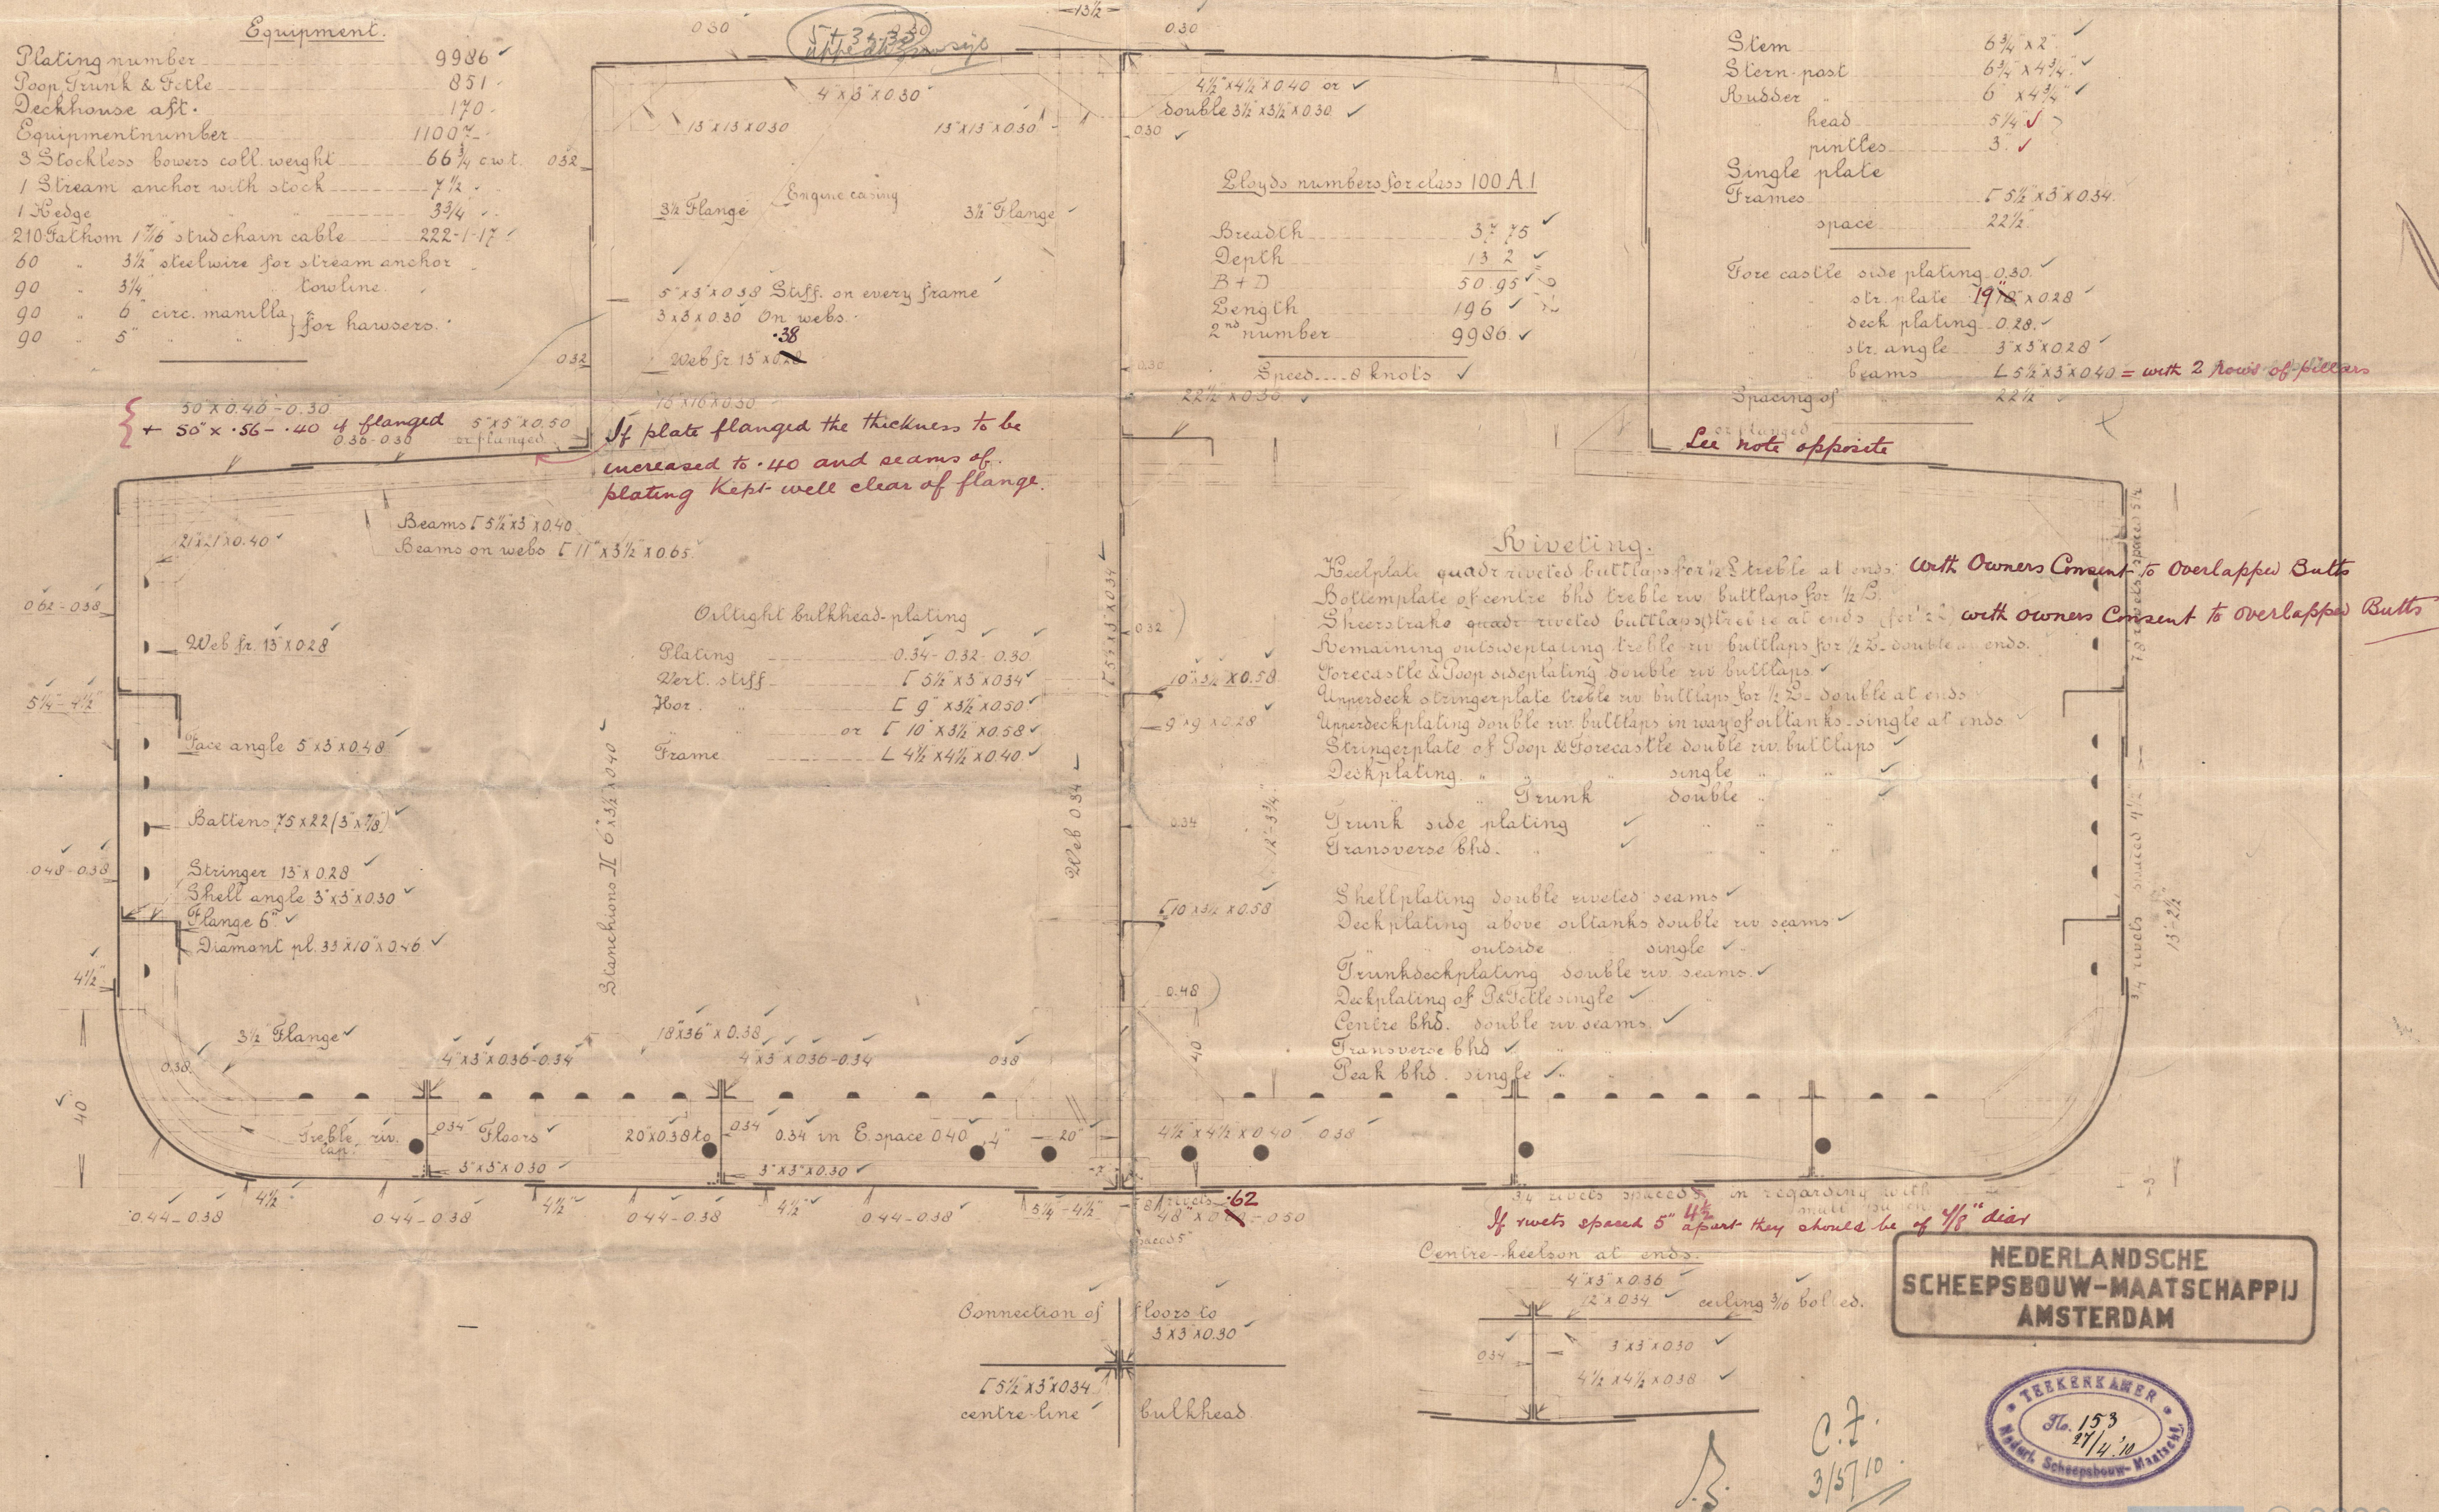

85 Mb 109

Mid. Reg. Section

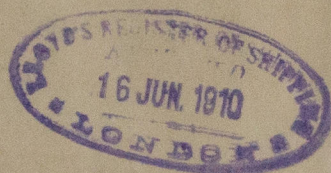

Vulcanus

Ans. 4710.







© 2020

Lloyd's Register
Foundation

W680-0204

N. L. 109
Midship Section

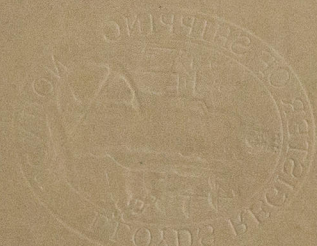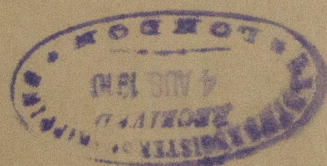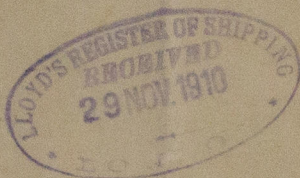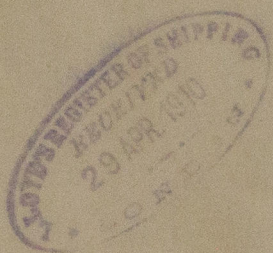

© 2020

Lloyd's Register
Foundation