




8.3.04
8.4.04
11.4.04

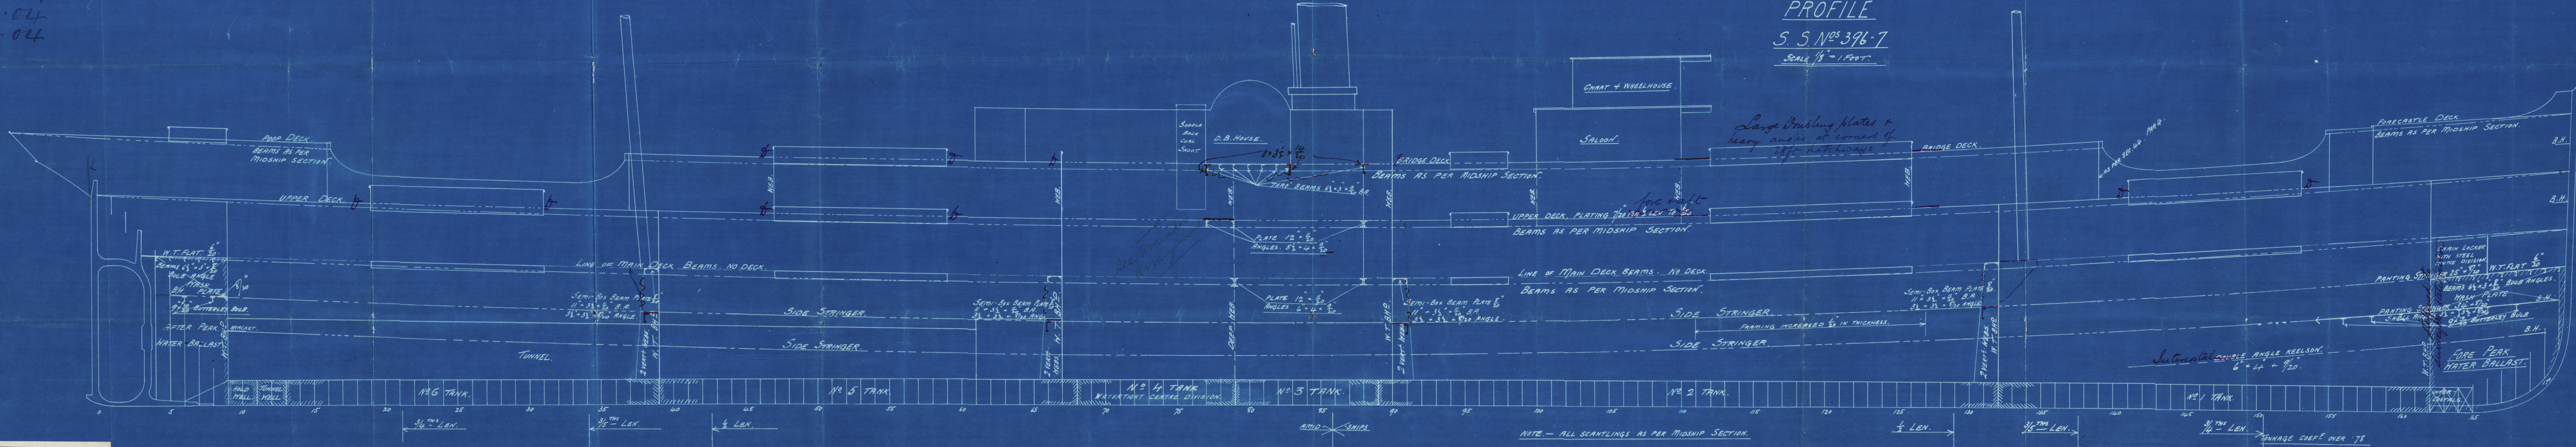

PROFILE
S. S. No. 396-7
SCALE 1/8" = 1 FOOT.

Large bracing plates +
heavy angles at corners of
18ft hatchways

See Arranged
Arrangement

NOTE - ALL SCANTLINGS AS PER MIDSHIP SECTION.

ANNAGE COEFF OVER '78
BOTTOM STRENGTHENED AS PER RULE.




From ARCHD. M'ILLAN & SON, Ltd., Dumbarton.
ENCLOSURE FOR
Lloyds
5/4/04



W691-0102


Mc Millan & Sons No 396-4

"Profile"

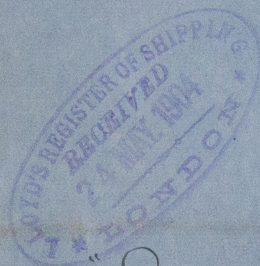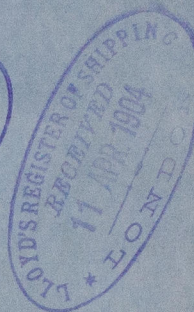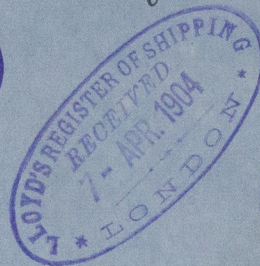

"Saint Irene"

Glasgow n/s no 22247

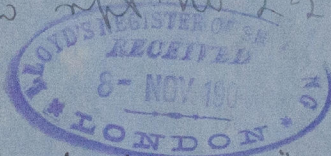

"Saint Jerome"

Glasgow n/s no. 22566

RETAIN



W681-0102



© 2020

Lloyd's Register
Foundation