
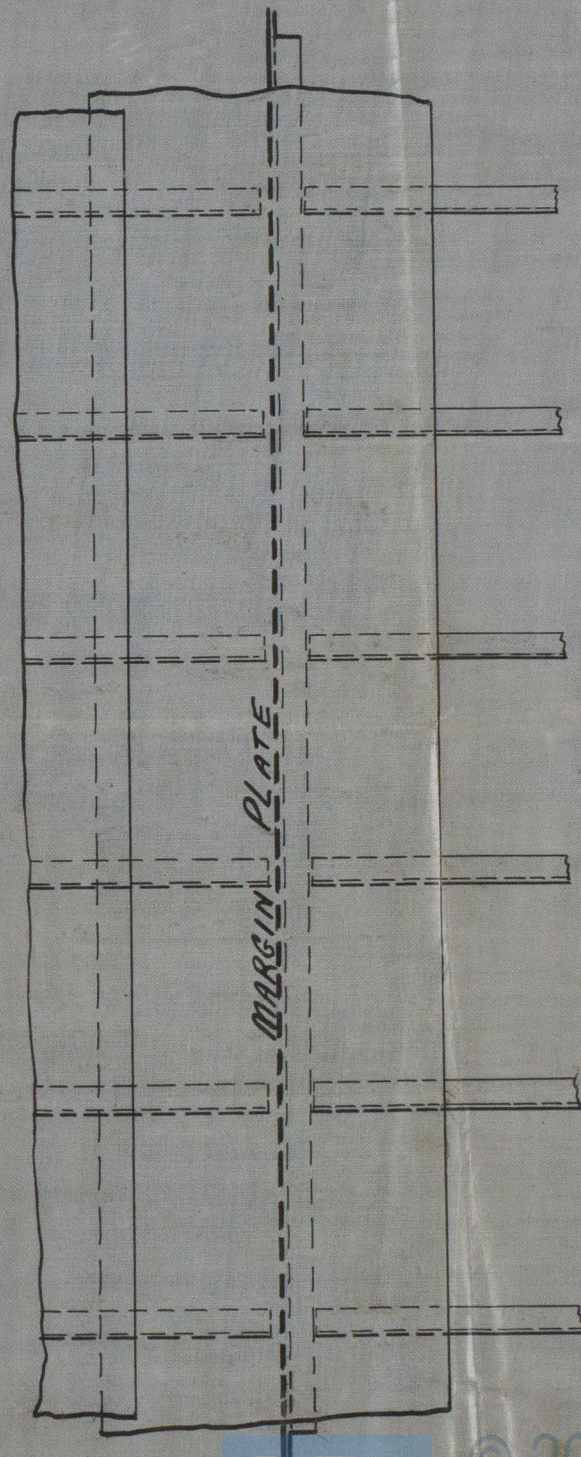


— N<sup>OS</sup> 376 & 377 —

— PLAN SHOWING PROPOSED CONTINUOUS PLATE —  
— AT TANK SIDE INSTEAD OF GUSSET PLATES —

— SCALE  $\frac{1}{2}'' = 1 \text{ FOOT.}$  —

1.3.05

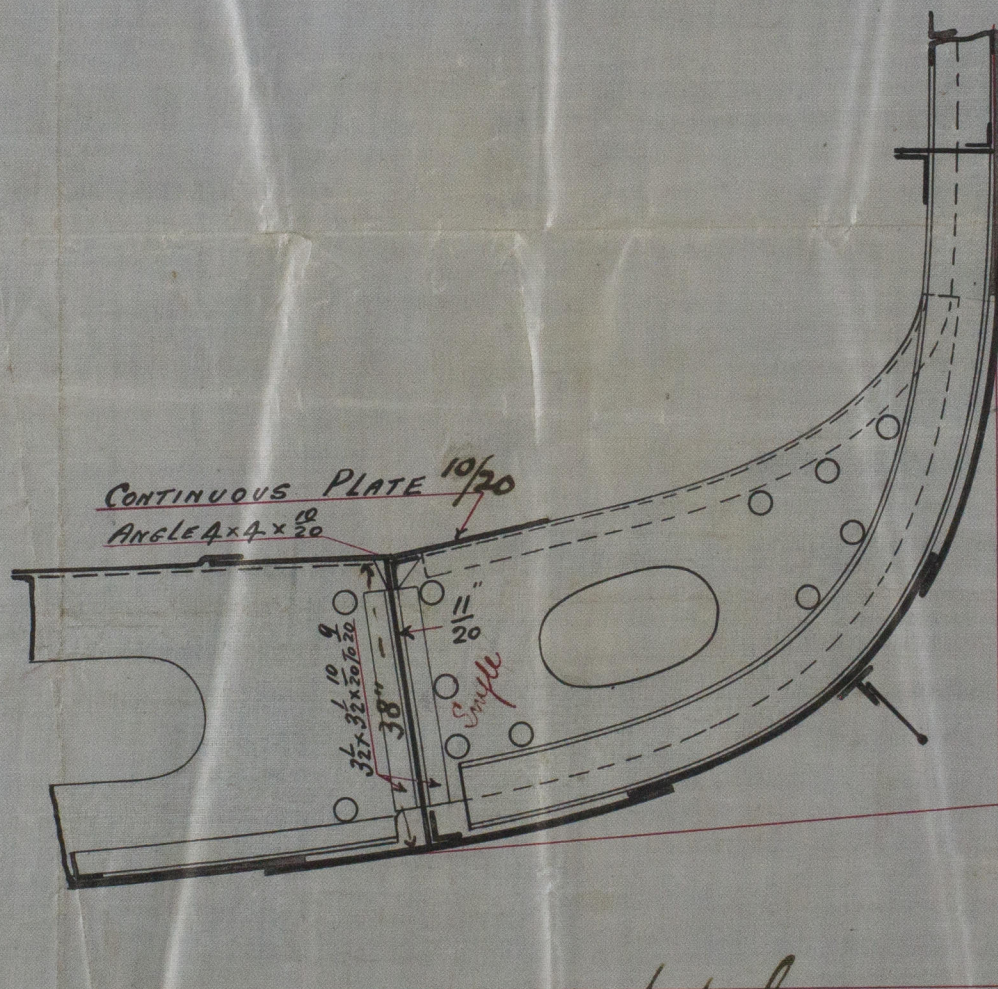

J. H. L.  
1/3/05



© 2021  
28/10/05  
Lloyd's Register  
Foundation  
W684-0021