

30/4/1924

CIRCUMF. SEAMS DOUBLE RIVETTED  
1 1/2" HOLES 3 3/8" PITCH

PLATE - 85.7%  
RIVET - 86.4%

STEEL PLATES, BARS AND RIVETS





IRON TUBES

TENSILE STRENGTH OF SHELL - BUTT STRAPS - GIRDERS

AND MANHOLE RING 28 TO 32 TONS PER SQ. INCH

ALL HOLES DRILLED IN PLACE

LONG. SEAMS DOUBLE BUTT STRAPS  
1" HOLES 1" PITCH  
BUTT STRAPS 3/8" THICK

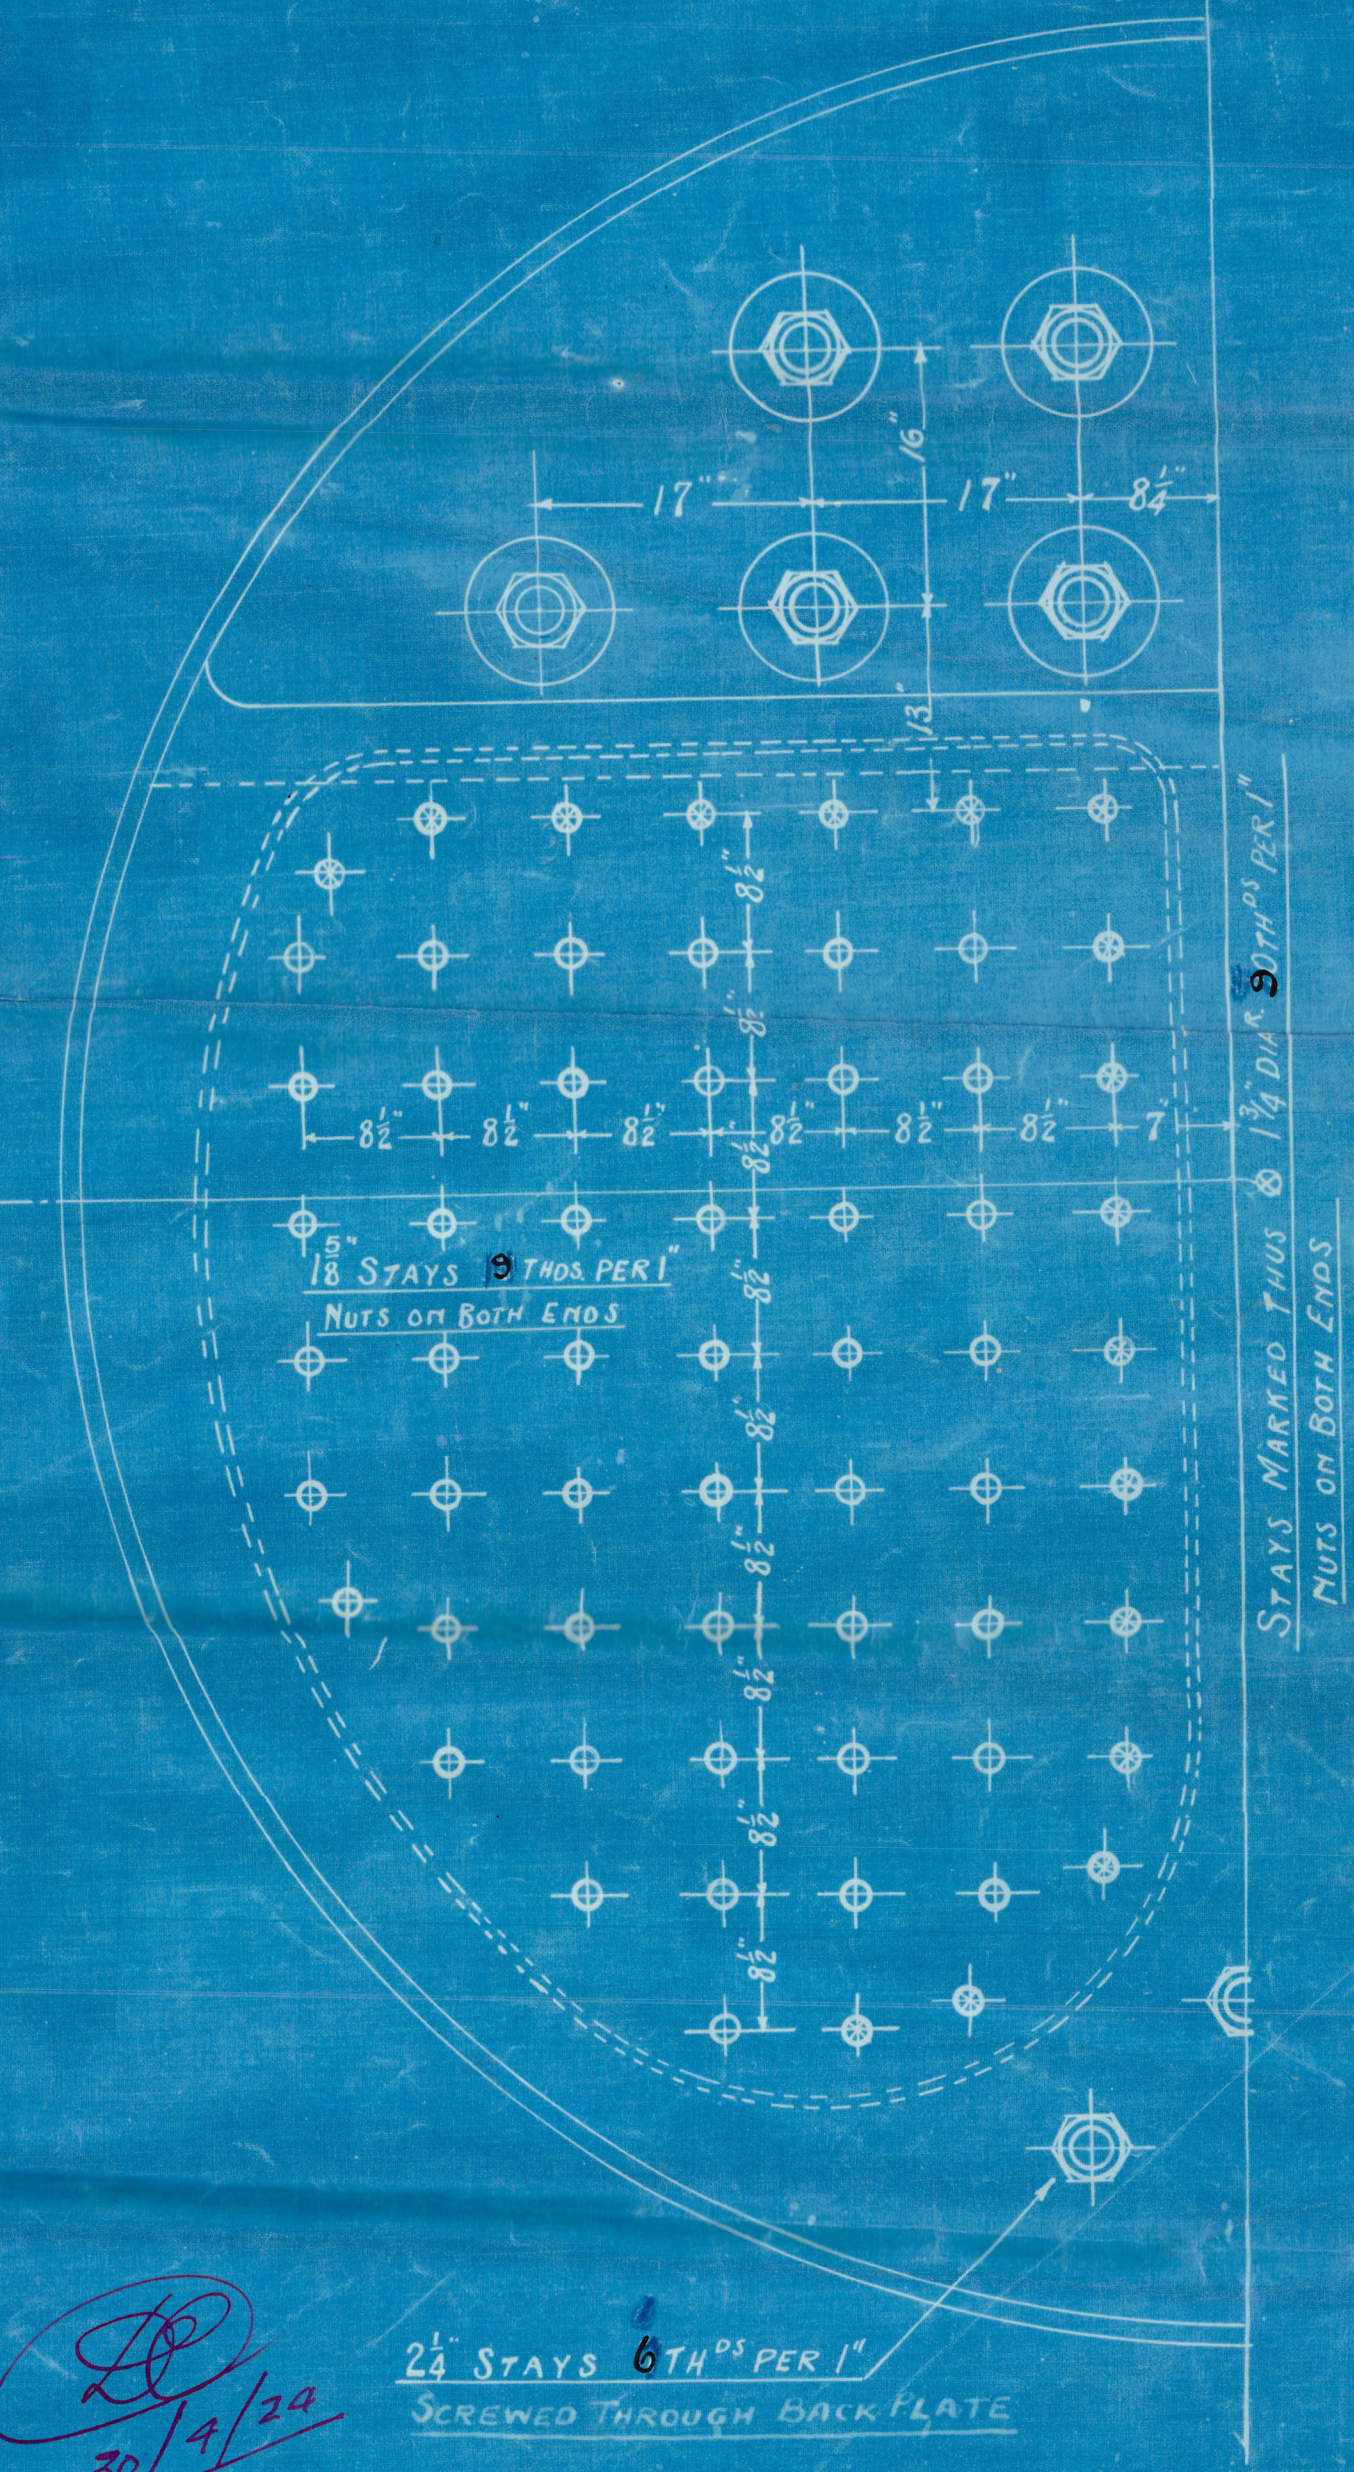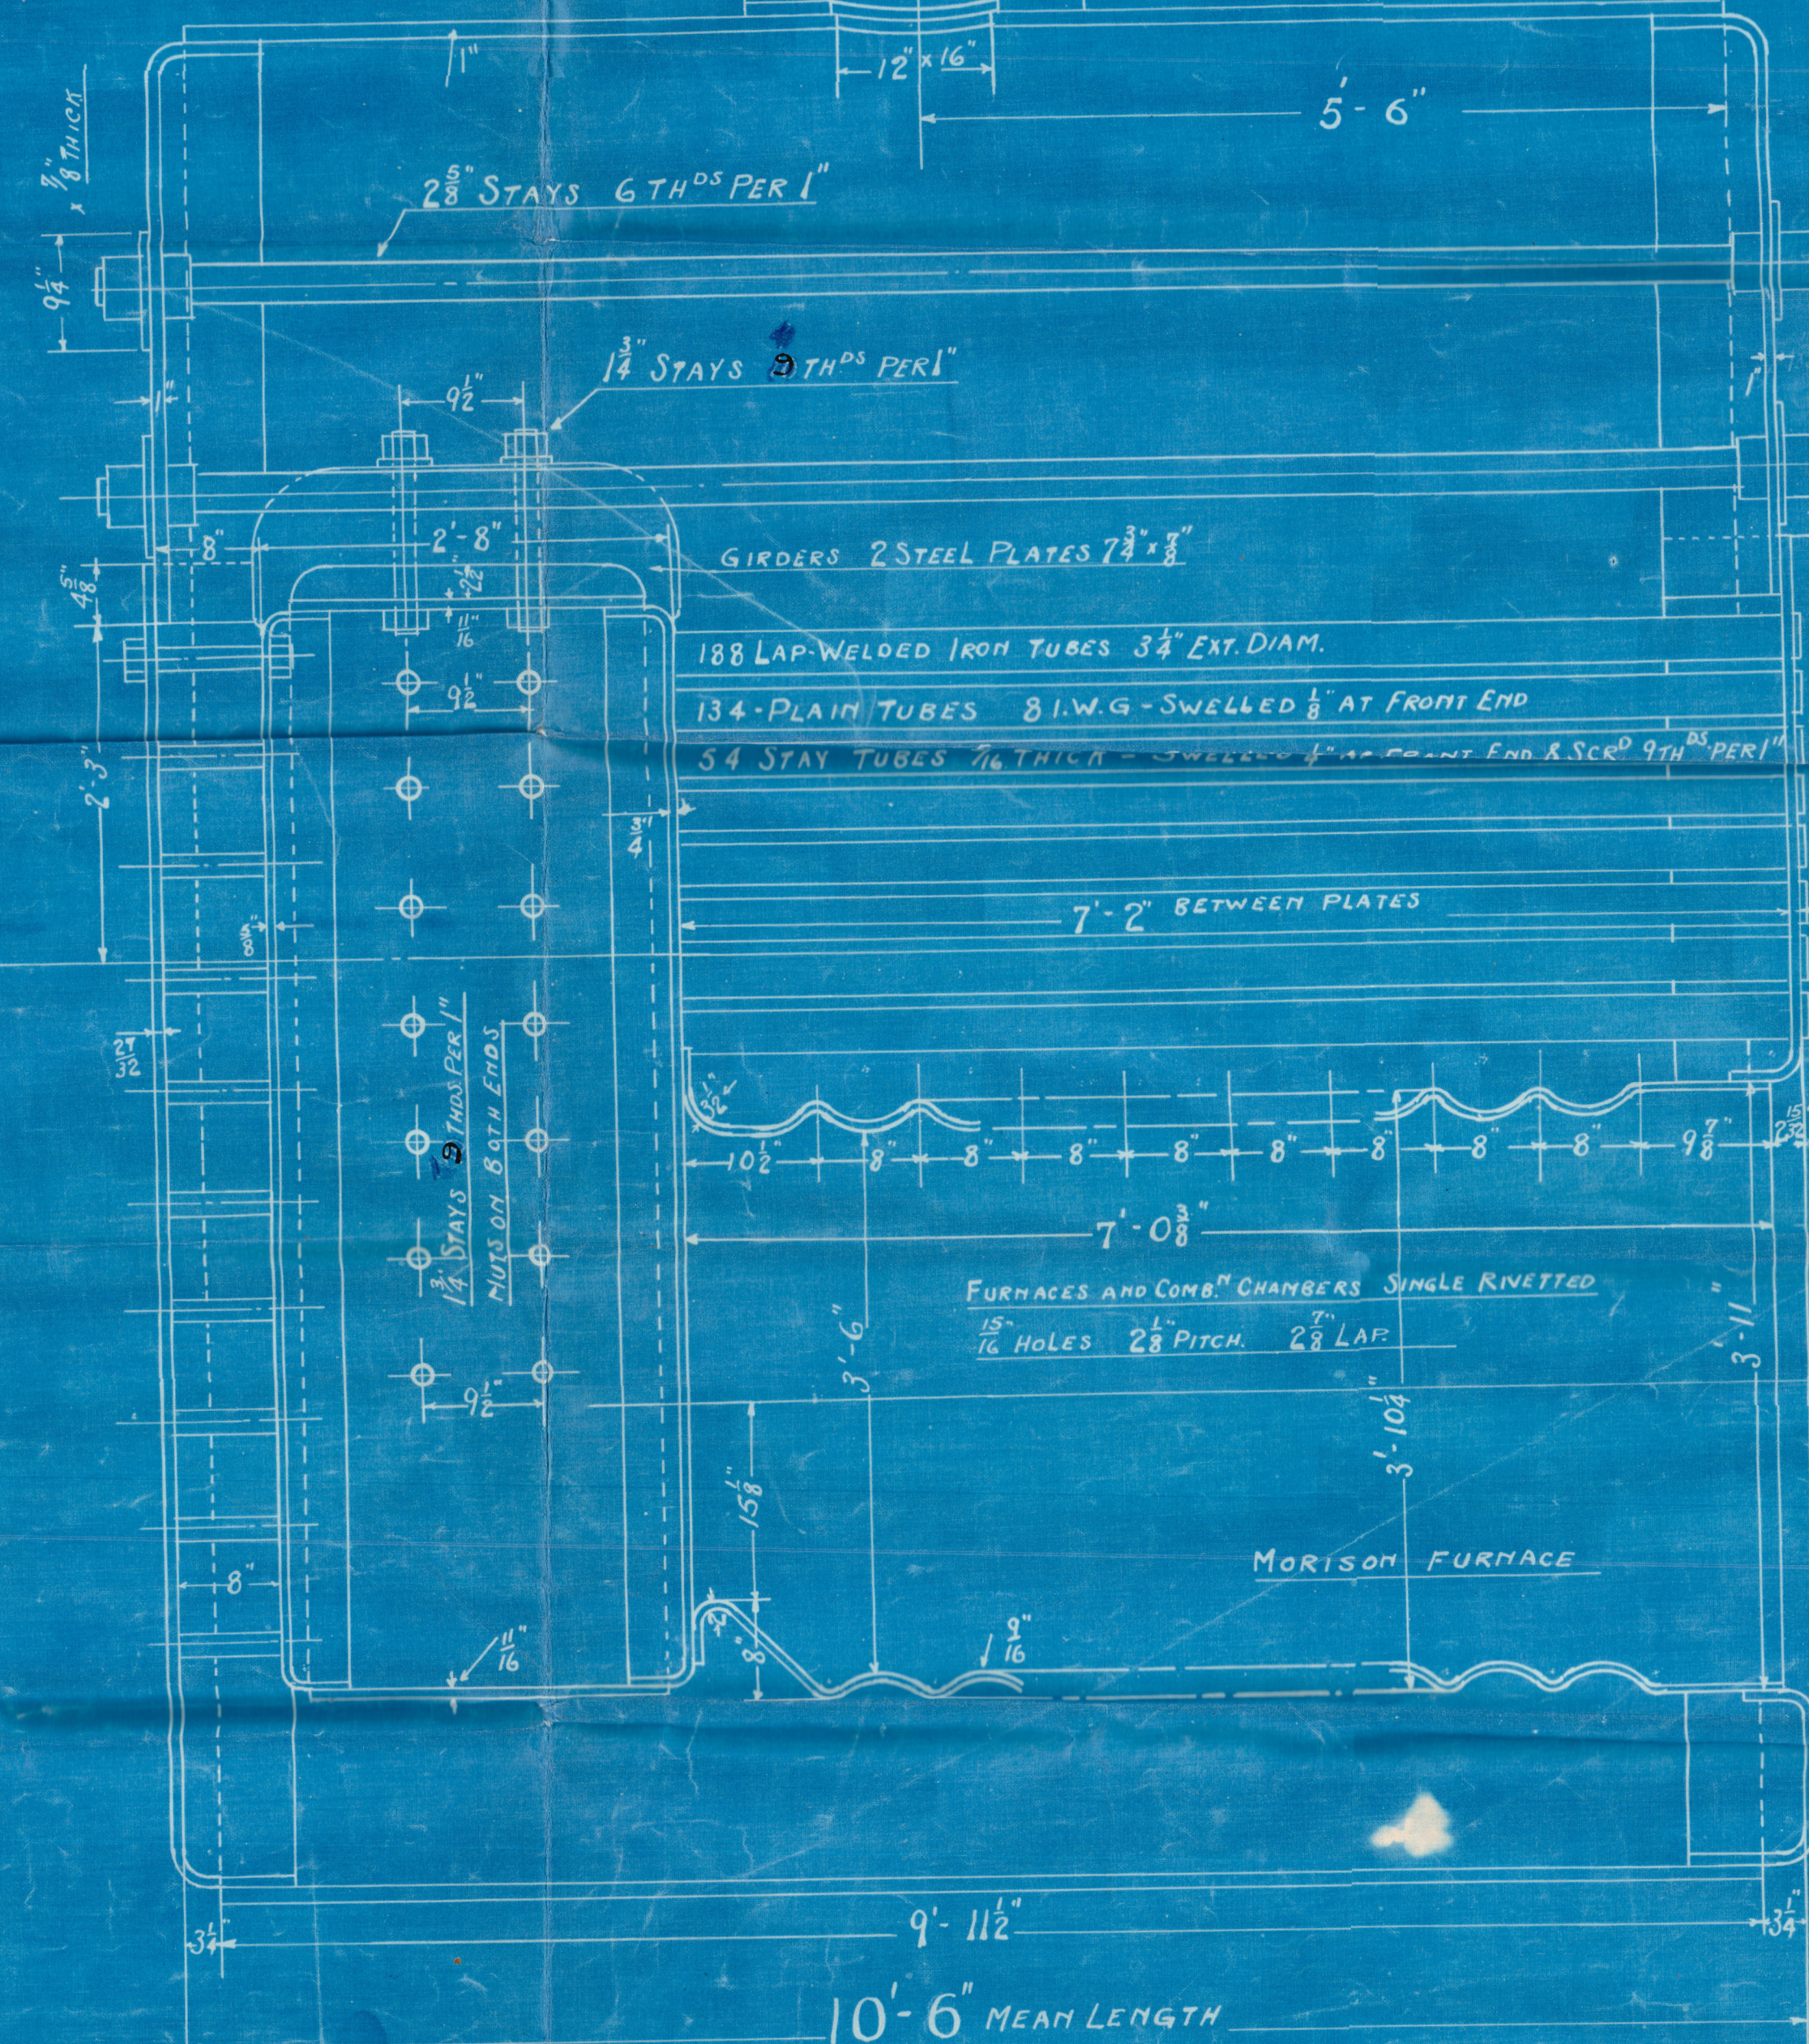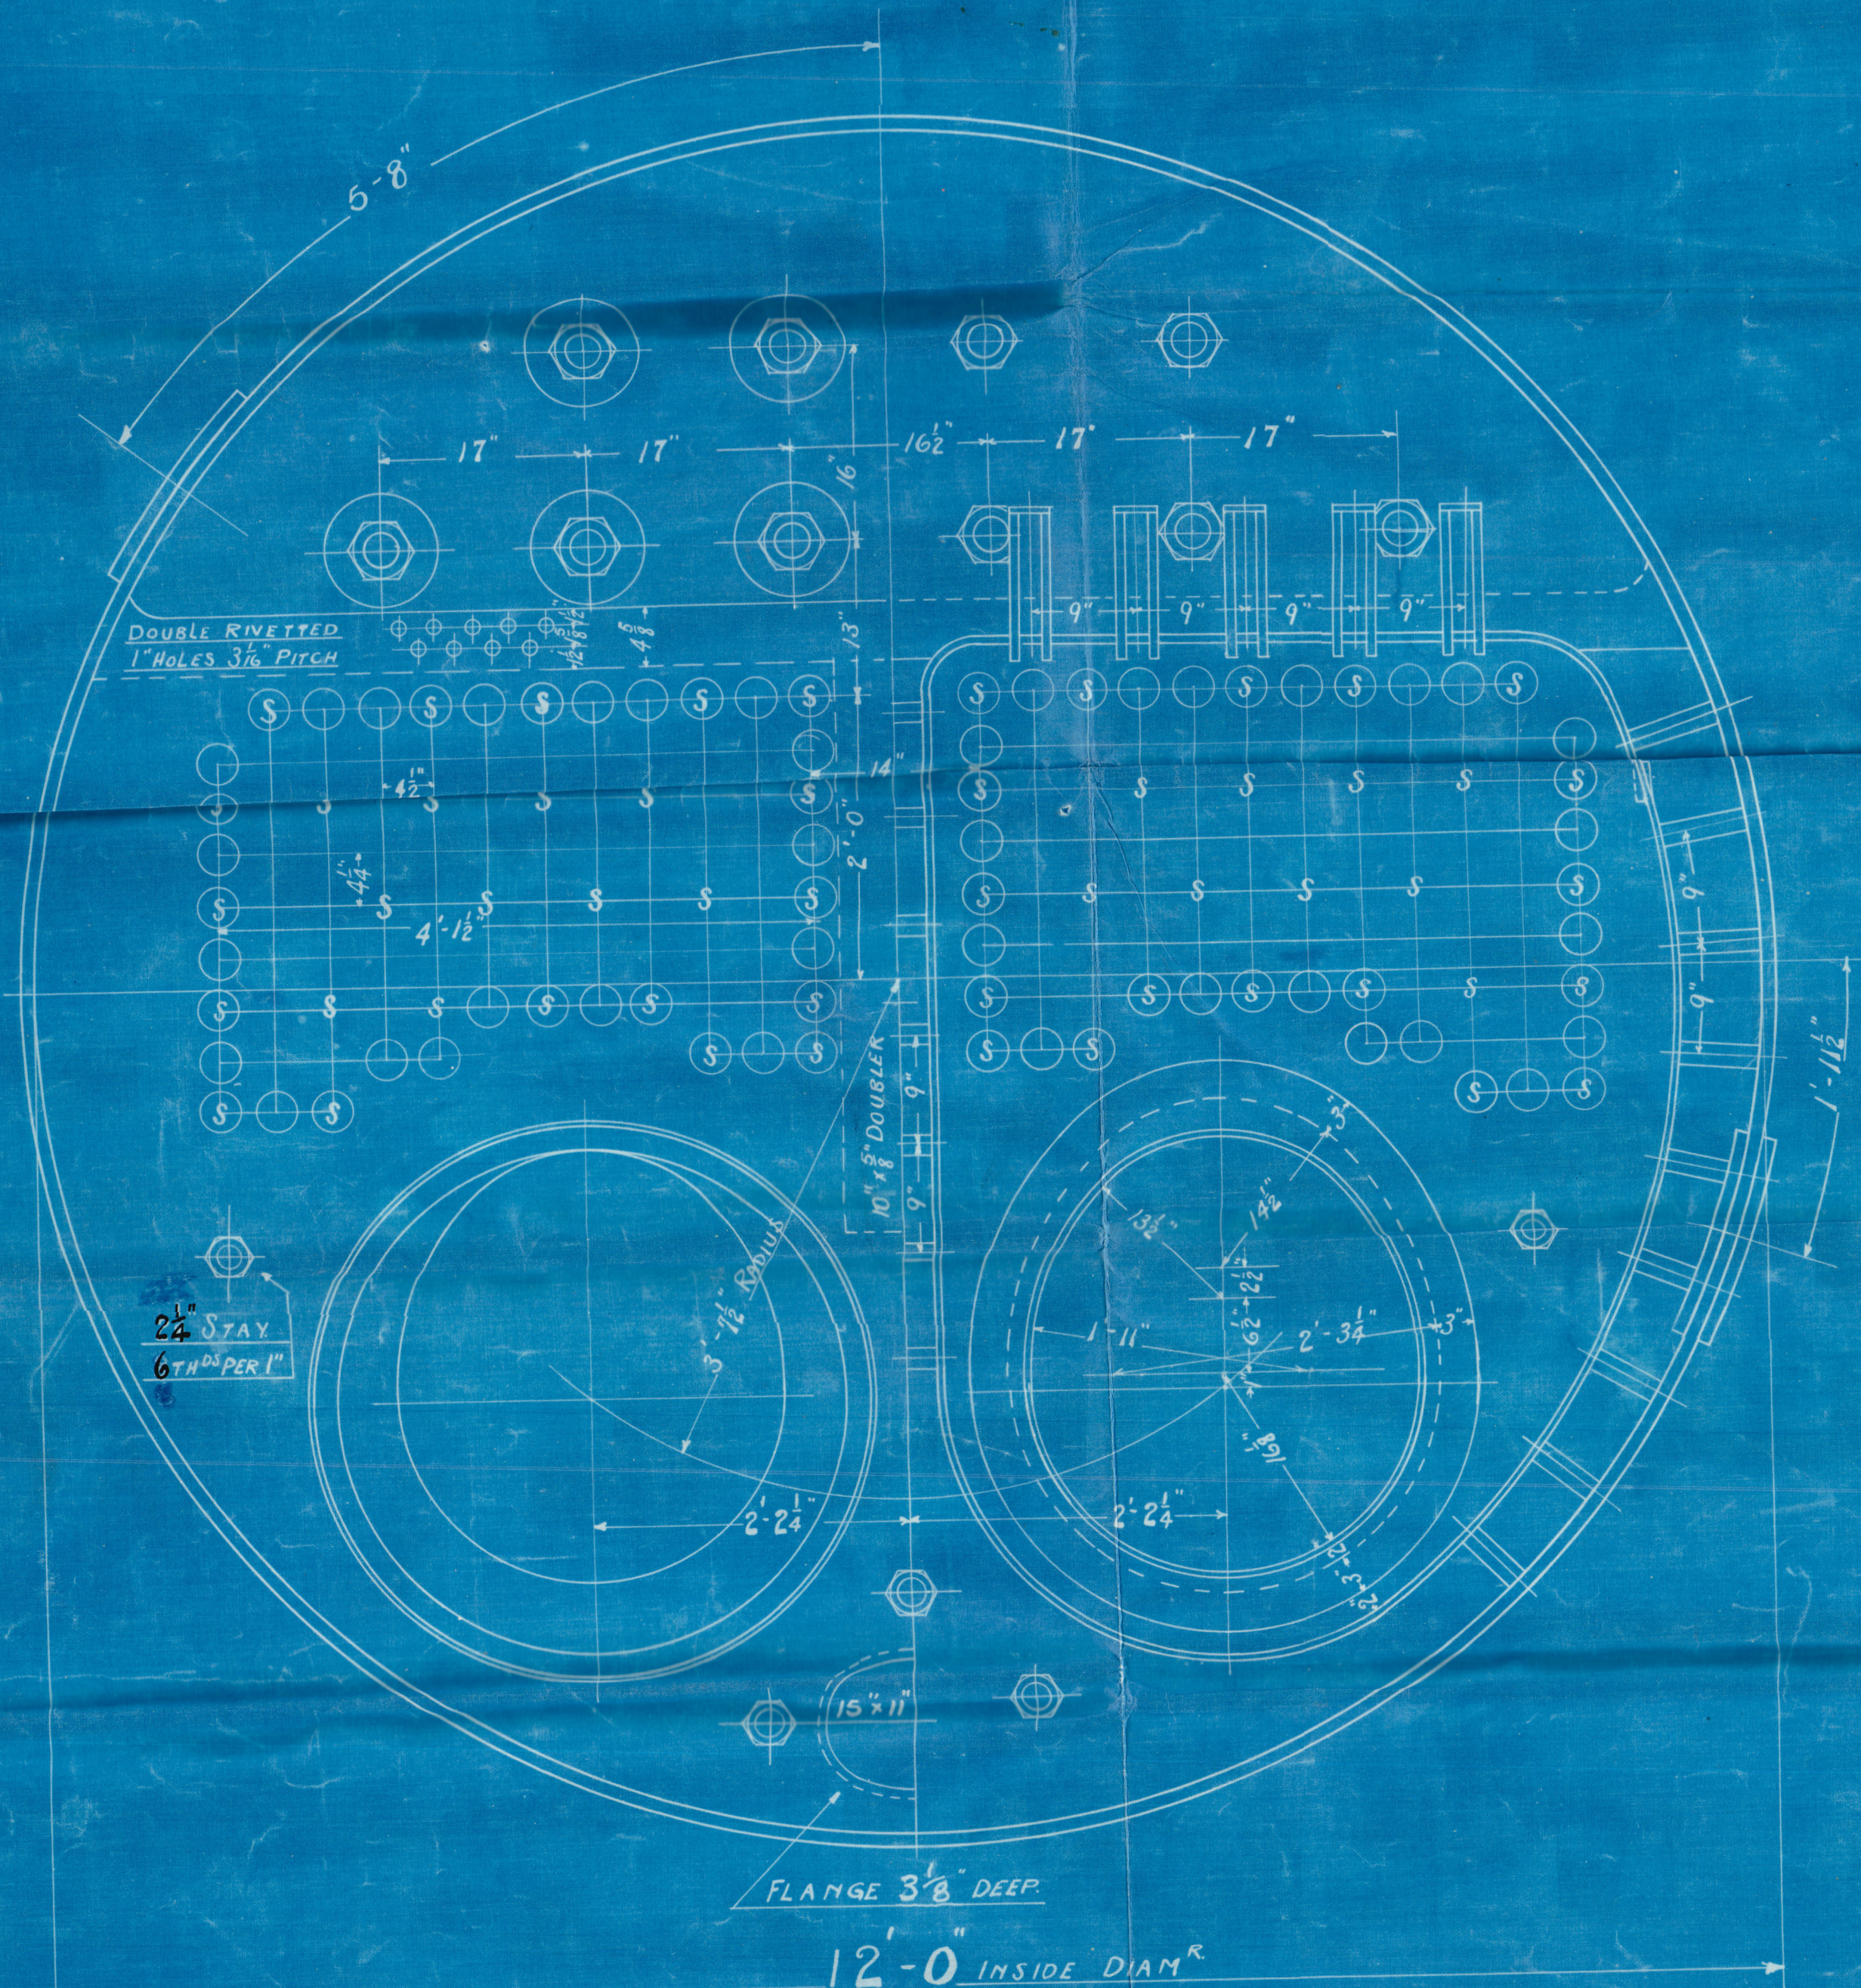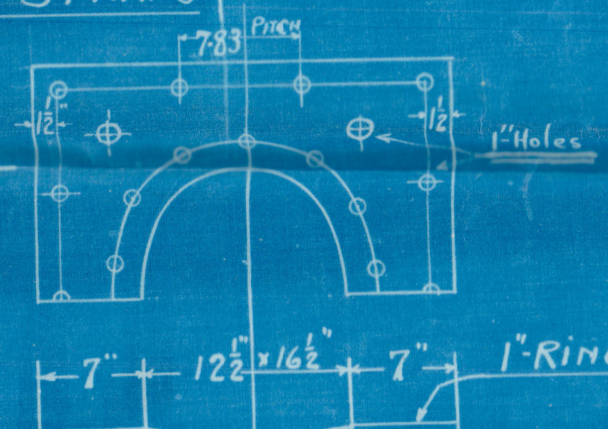

30/4/24

BOILER N° 1709-10

WORKING PRESSURE 180 LBS. PER SQ. INCH

SCALE 1/4" = 1 FOOT

GRATE SURFACE (S.G. BAR)	39.56
TUBE HEATING SURFACE	1147.56
OTHER " "	255.56
TOTAL " "	1403.68
RATIO H.S. TO G.S.	35.6:1

TO HAVE LLOYD'S CERTIFICATE



ENCLOSURE  
ROSS & DUNNAN



1 1/2"

3 1/4"

" MEAN LENGTH

TIFICATE



*LD*  
30/4/24

2 1/4" STAYS 6TH<sup>DS</sup> PER 1"  
SCREWED THROUGH BACK PLATE

*1924*  
**BOILER N° 1709-10**

WORKING PRESSURE 180 LBS. PER INCH

*Duplicates 1701-2.*

SCALE 1 INCH = 1 FOOT

GRATE SURFACE (5'-6" BAR)	39.5 g
TUBE HEATING SURFACE	1147.5 g
OTHER " "	255.5 g
TOTAL " "	1403 g
RATIO H.S. TO G.S. = 35.6 : 1	

*AC*

W687-0162 (1-1/2)  
ENCLOSURE.  
From ROSS & DUNCAN,  
To *Messrs Lloyd's Register of Shipping*



© 2020  
Lloyd's Register  
Foundation

W687-0162 (2/2)



Foss & Duncan  
Pls N<sup>os</sup> 1709-10  
W.P. 180 lbs.  
Duplicate N<sup>os</sup>  
1701-2


N<sup>o</sup> 16598  
Lloyd's List  
320 lbs  
W.P. 180 "  
J.S.C. 10-9-24

GLASGOW REPORT No.

43985.

ETAIN

© 2020

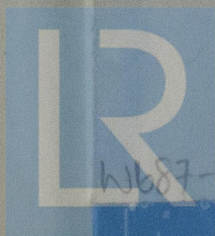

Lloyd's Register  
W687-0162(1/2)