

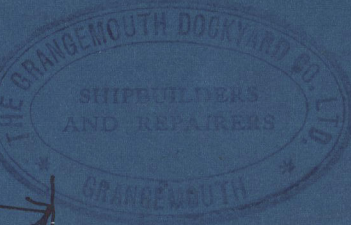


PROFILE AND DECK PLANS
S.S. 245'0" x 37'6" x 19'3" MLD.
SCALE 1/8" = 1'-0"
TO CLASS 100 A.I. AT LLOYDS.

NOTE:— These Scantlings shown to be minimum, any reductions to be indicated on plan— errors and omissions excepted.

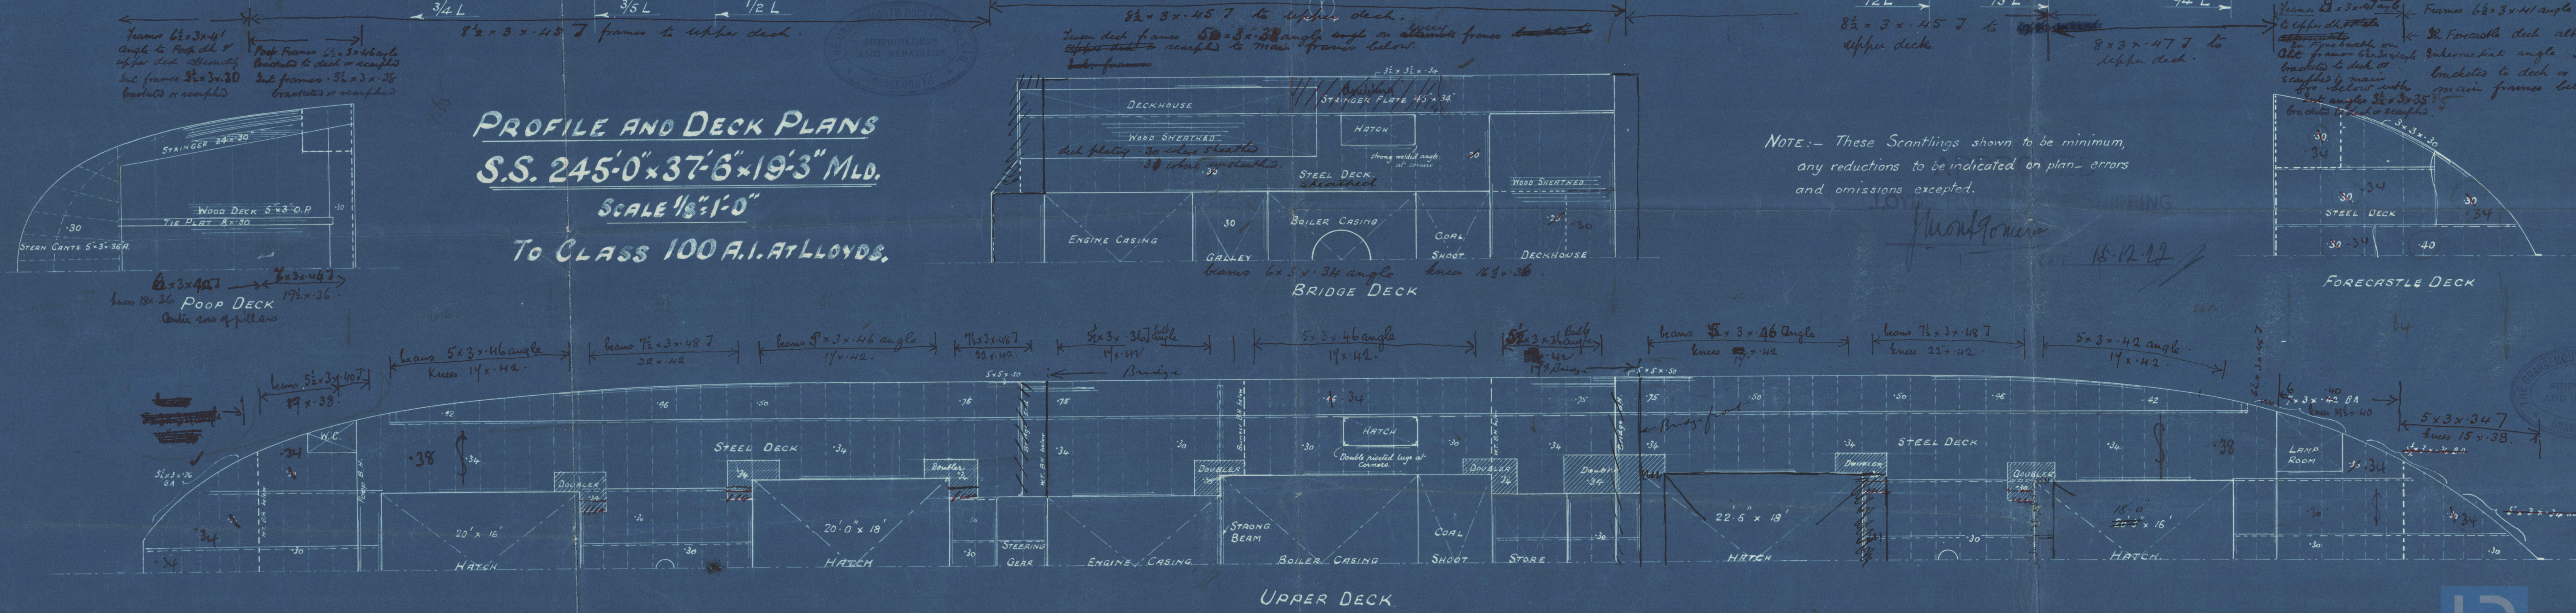

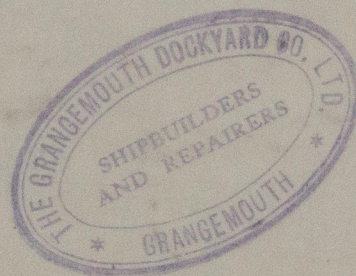

© 2020

Lloyd's Register
Foundation

W687-0179


Grangemouth Dock Co.
No 407.

S. S. KONINI.
Profile

Profile

Glasgow Rpt No .44066

RETAIN

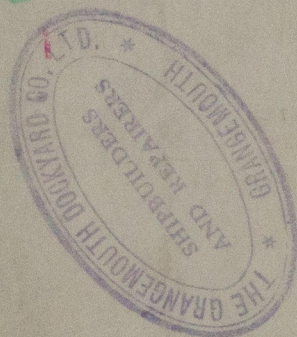

© 2020

Lloyd's Register
W581 0179
Foundation