



ELEVATION LOOKING TO PORT

OIL RETURN TO
SUCTION FILTER

OIL DELIVERY FROM
PUMP FILTER

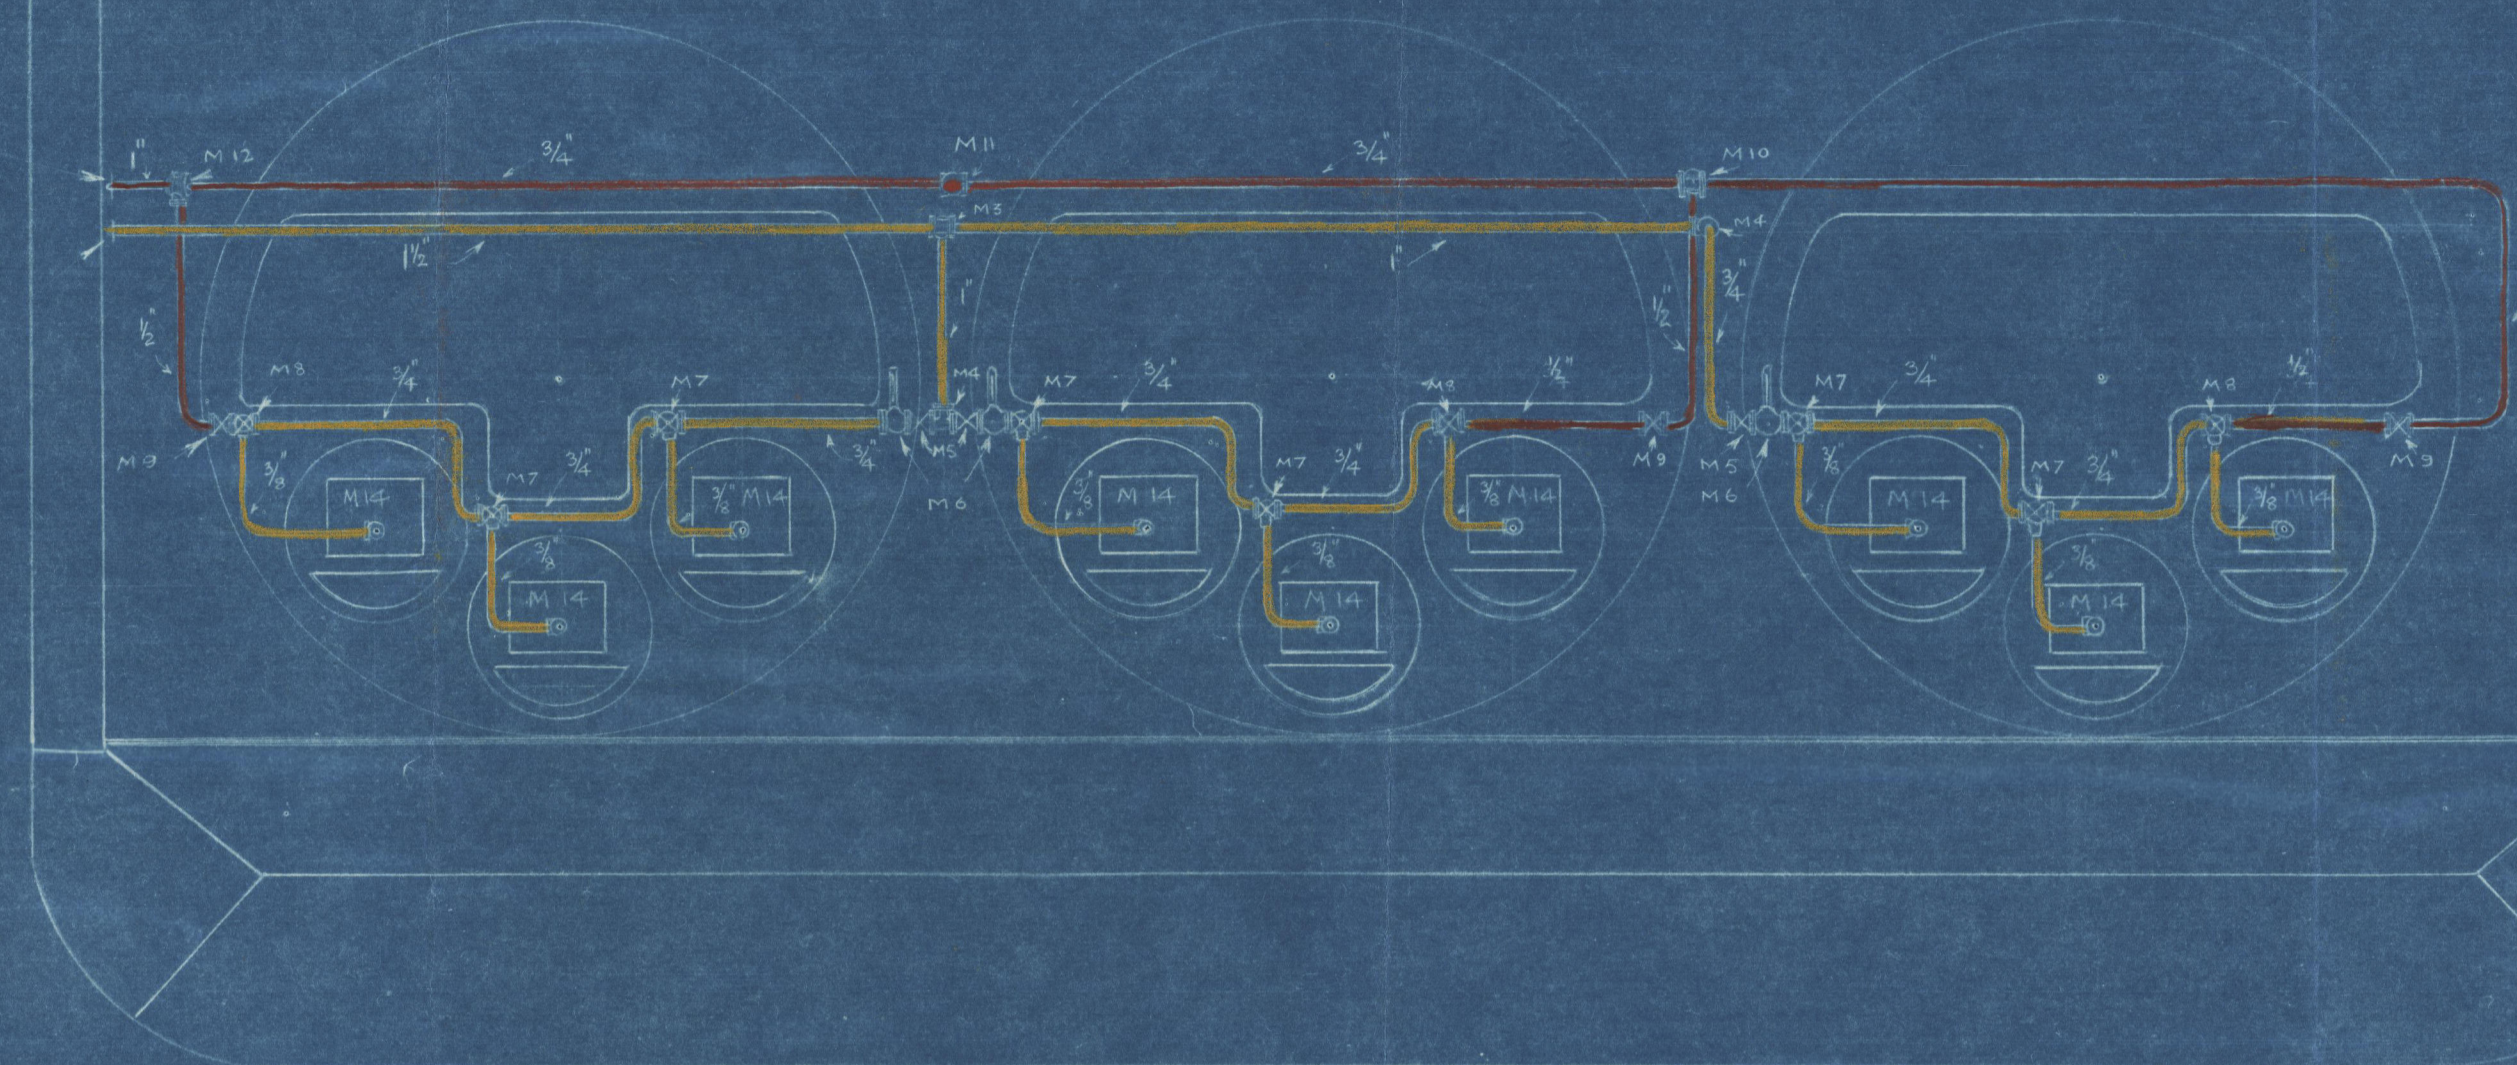

ELEVATION LOOKING AFT ON BOILER FRONTS

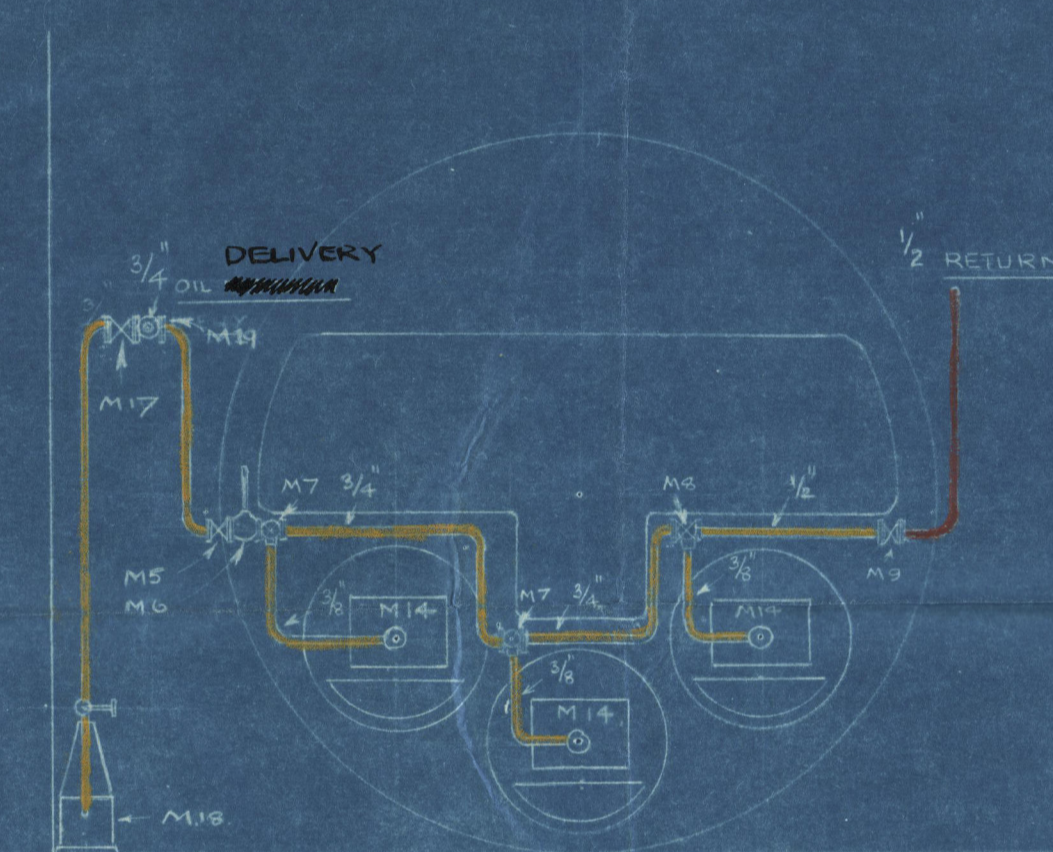

ELEVATION ON FORE'D BOILER LOOKING FORE'D

FITTING LIST

MARK	SIZE	NO OFF	DESCRIPTION	DRAWING PART OR ZN	SUPPLIED BY
M1	Nº 2	1	DUPLEX PUMPING HEATING & FILTERING UNIT COMPLETE	Z 364	TODD OIL BURNERS
M2	5" DIAM	1	AIR VESSEL	Z 328	"
M3	1 1/2" x 1" x 1"	1	OIL TEE PIECE OIL DELIVERY		BUILDERS
M4	3/4" x 3/4" x 1"	1	" " " " " "		"
M5	3/4"	4	CI GLOBE VALVE OIL MASTER Q.S.O. TYPE	Z 675/A	TODDS
M6	3/4"	4	CI THERMO FITTINGS COMPLETE WITH THERMOS & POCKETS	Z 305/A	"
M7	3/4" x 3/4"	8	SINGLE BOSS BURNER TEES COMPLETE WITH 5/8" BURNER VALVES	(Z 13/A) (Z 205/A) (Z 384/A)	"
M8	3/4" x 1/2"	4	" " " " " "	Z 112/A	"
M9	1/2"	4	CI GLOBE VALVES OIL CIRC. & RETURN		BUILDERS
M10	1/2" x 3/4" x 1/2"	1	CI TEE PIECE " " " "		"
M11	3/4" x 3/4" x 1/2"	1	" " " " " "		"
M12	3/4" x 1" x 1/2"	1	" " " " " "		"
M13	1/2"	1	STEAM TRAP AND THREE WAY COCK	T 1591	TODDS
M15	1"	1	CI GLOBE VALVE OIL CIRC. & RETURN MASTER		BUILDERS
M16	1"	1	" " " " " "		"
M17	3/4"	1	" " " " " "		"
M18	Nº 2	1	PREHEATER COMPLETE WITH LAMP	Z 14	TODDS
M19	3/4" x 3/4" x 3/4"	1	OIL TEE PIECE OIL DEL. FROM PREHEATER		BUILDERS
M20	2 x 2 1/2"	1	HAND PUMP	T 1587	TODDS

NOTE


ALL PIPING AND FITTINGS NOT LISTED ABOVE TO BE SUPPLIED BY BUILDERS.

OIL DELIVERY LINES THUS

OIL RETURN LINES THUS

TODD OIL BURNERS LTD.
130-132
LEADENHALL STREET, LONDON, E.C.3.

DRG. NO. T2222/6708	SCALE 1/4" = 1 FOOT.
SHIP NO.	RECORD NO.
CONTRACT NO.	TRAC. NO.
DRAWN Roca	CHECKED 12/1 DATE 7-1-39
GENERAL ARRANGEMENT OF OIL BURNING EQUIPMENT FOR 9/16" PHÆX	

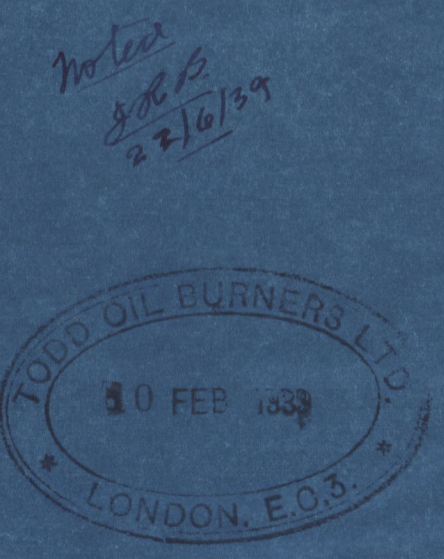

W69 - 0016

*Plan of oil fuel arrangement
for boilers as fitted in
the S/S "Phaeton"*



© 2020

Lloyd's Register
Foundation