


Official Copy

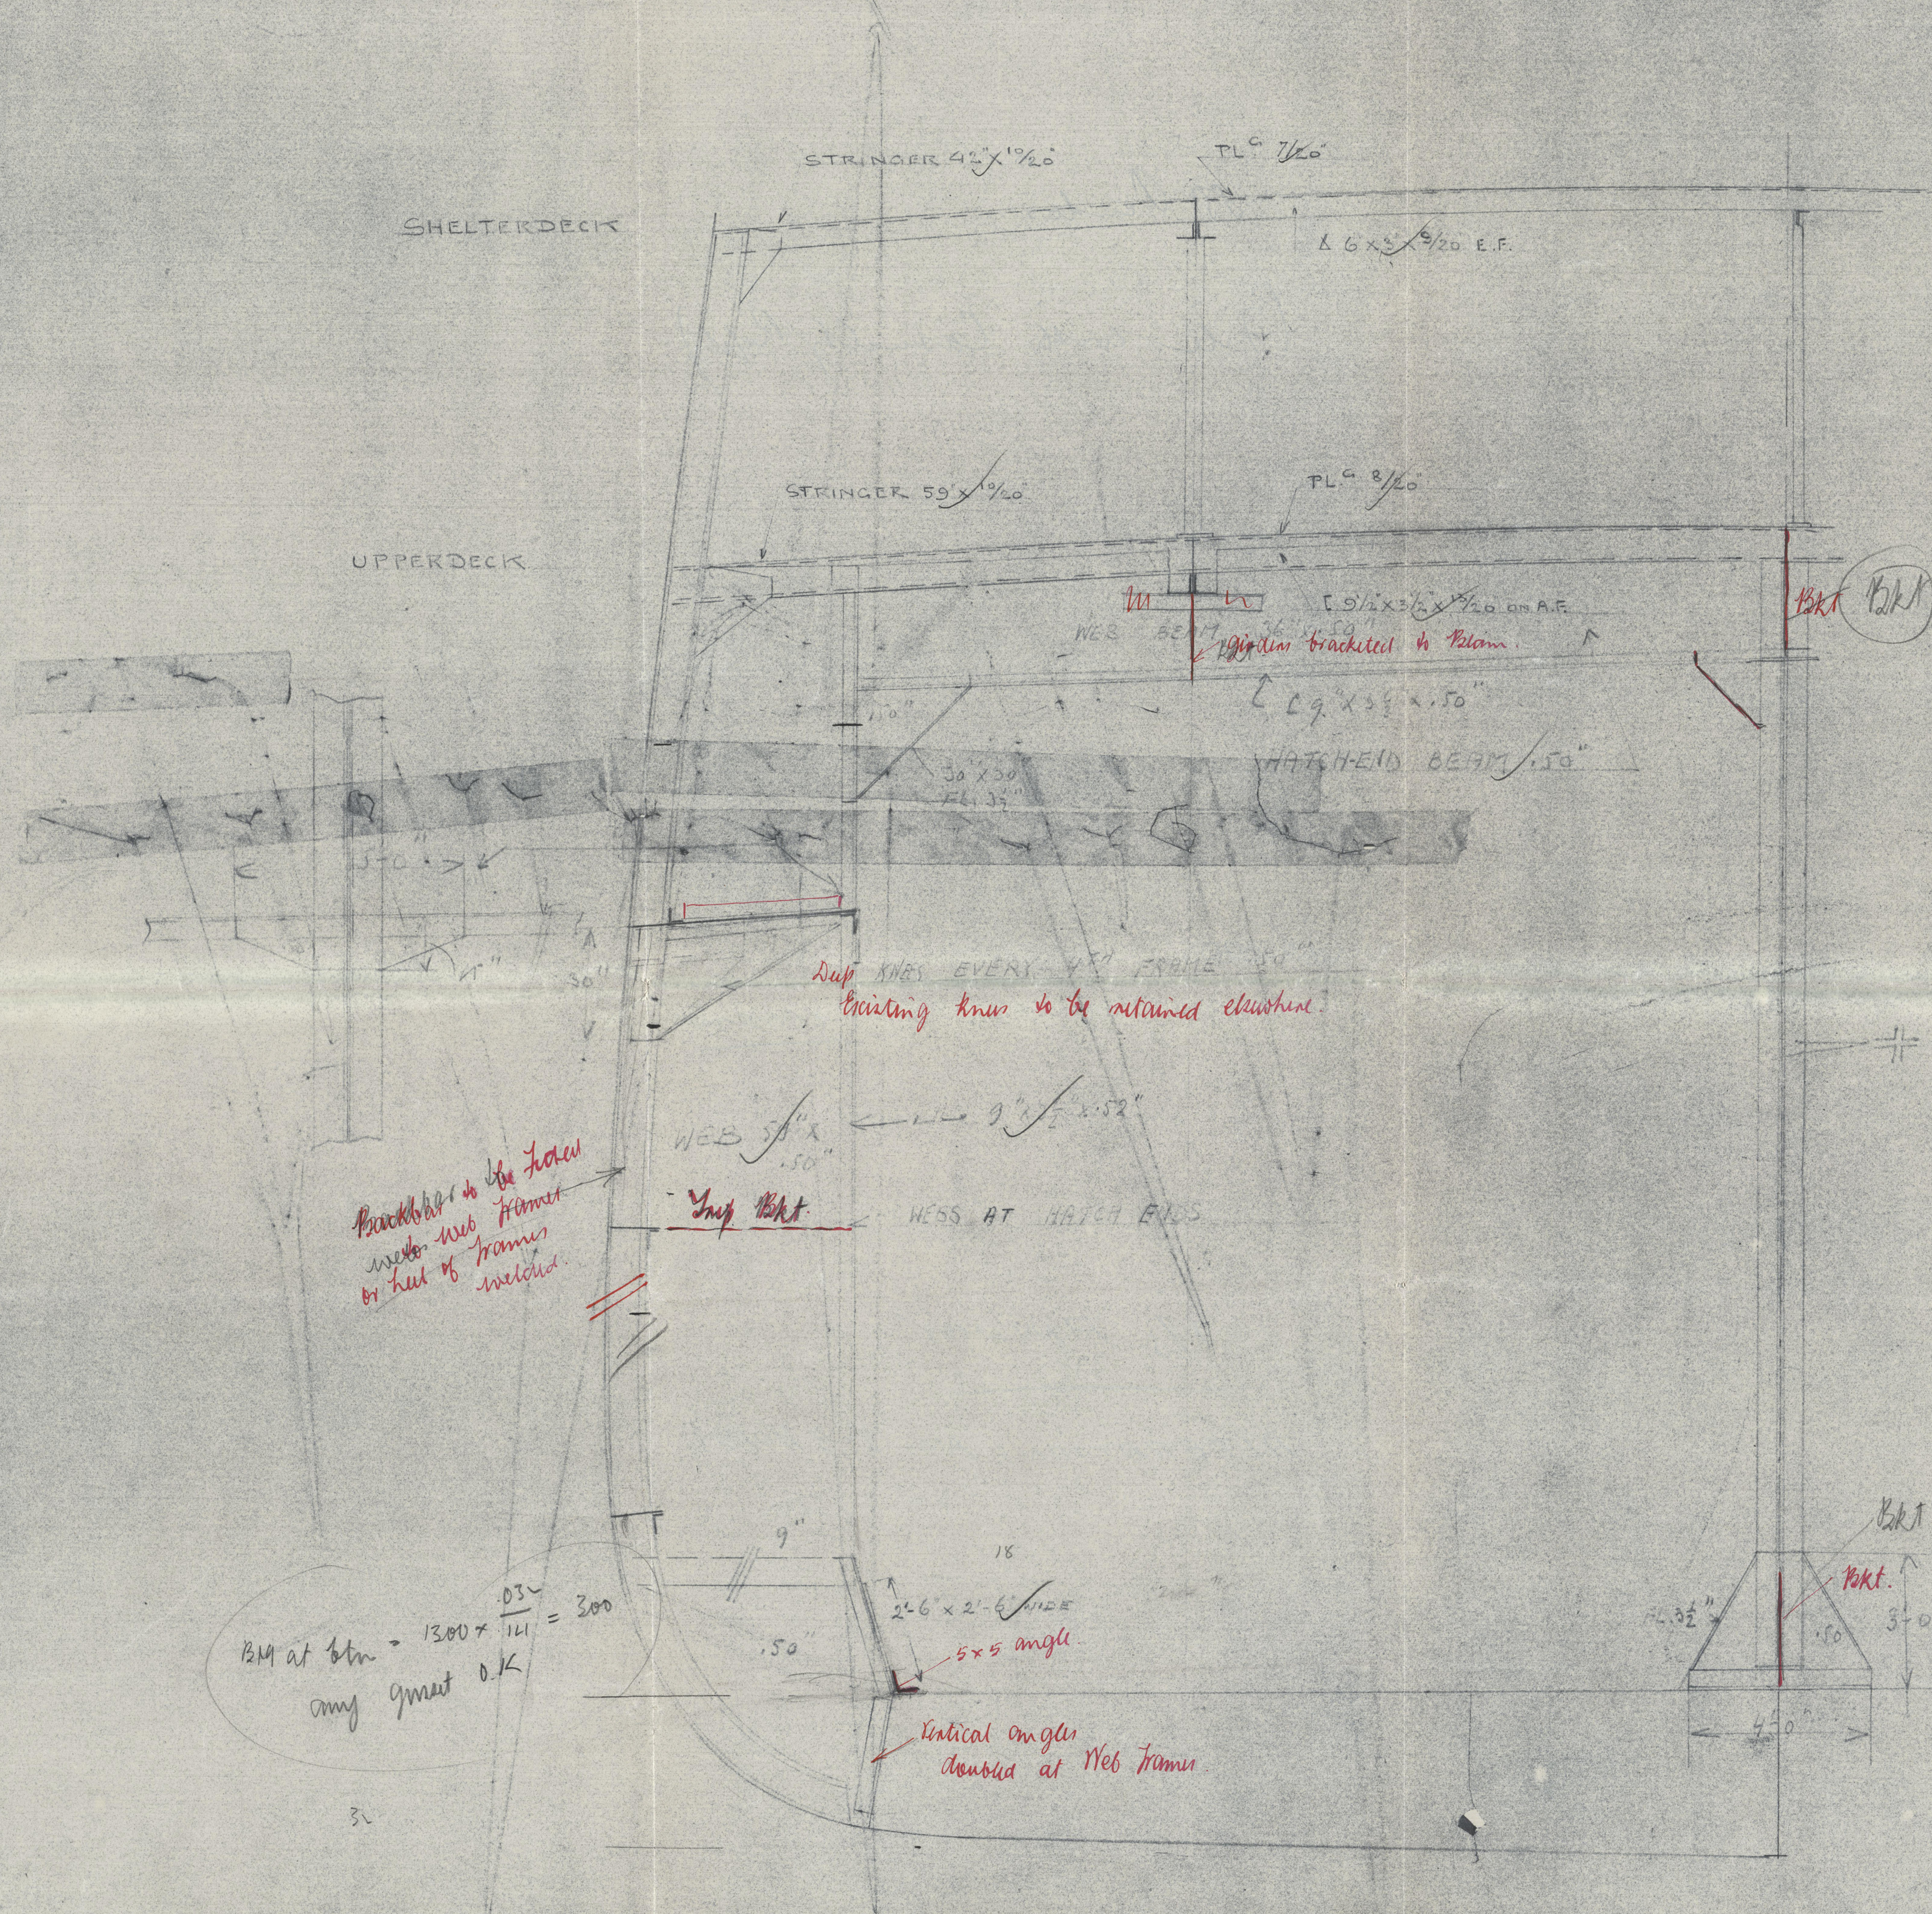

JKb
20/2/39

[illegible]

S.S. Pindos.

(File with Casualty Rept.)

W69-0130

LONDON

S/S "PINDOS"

ALTERATIONS Nos 2-3 HOLDS



© 2020

Lloyd's Register
Foundation