

Repairs to main boilers

$\frac{1}{5}$ PETSAMO

of
Hango


Copenhagen Rpt. No. 8665.

W69-0194



© 2020






Lloyd's Register
Foundation

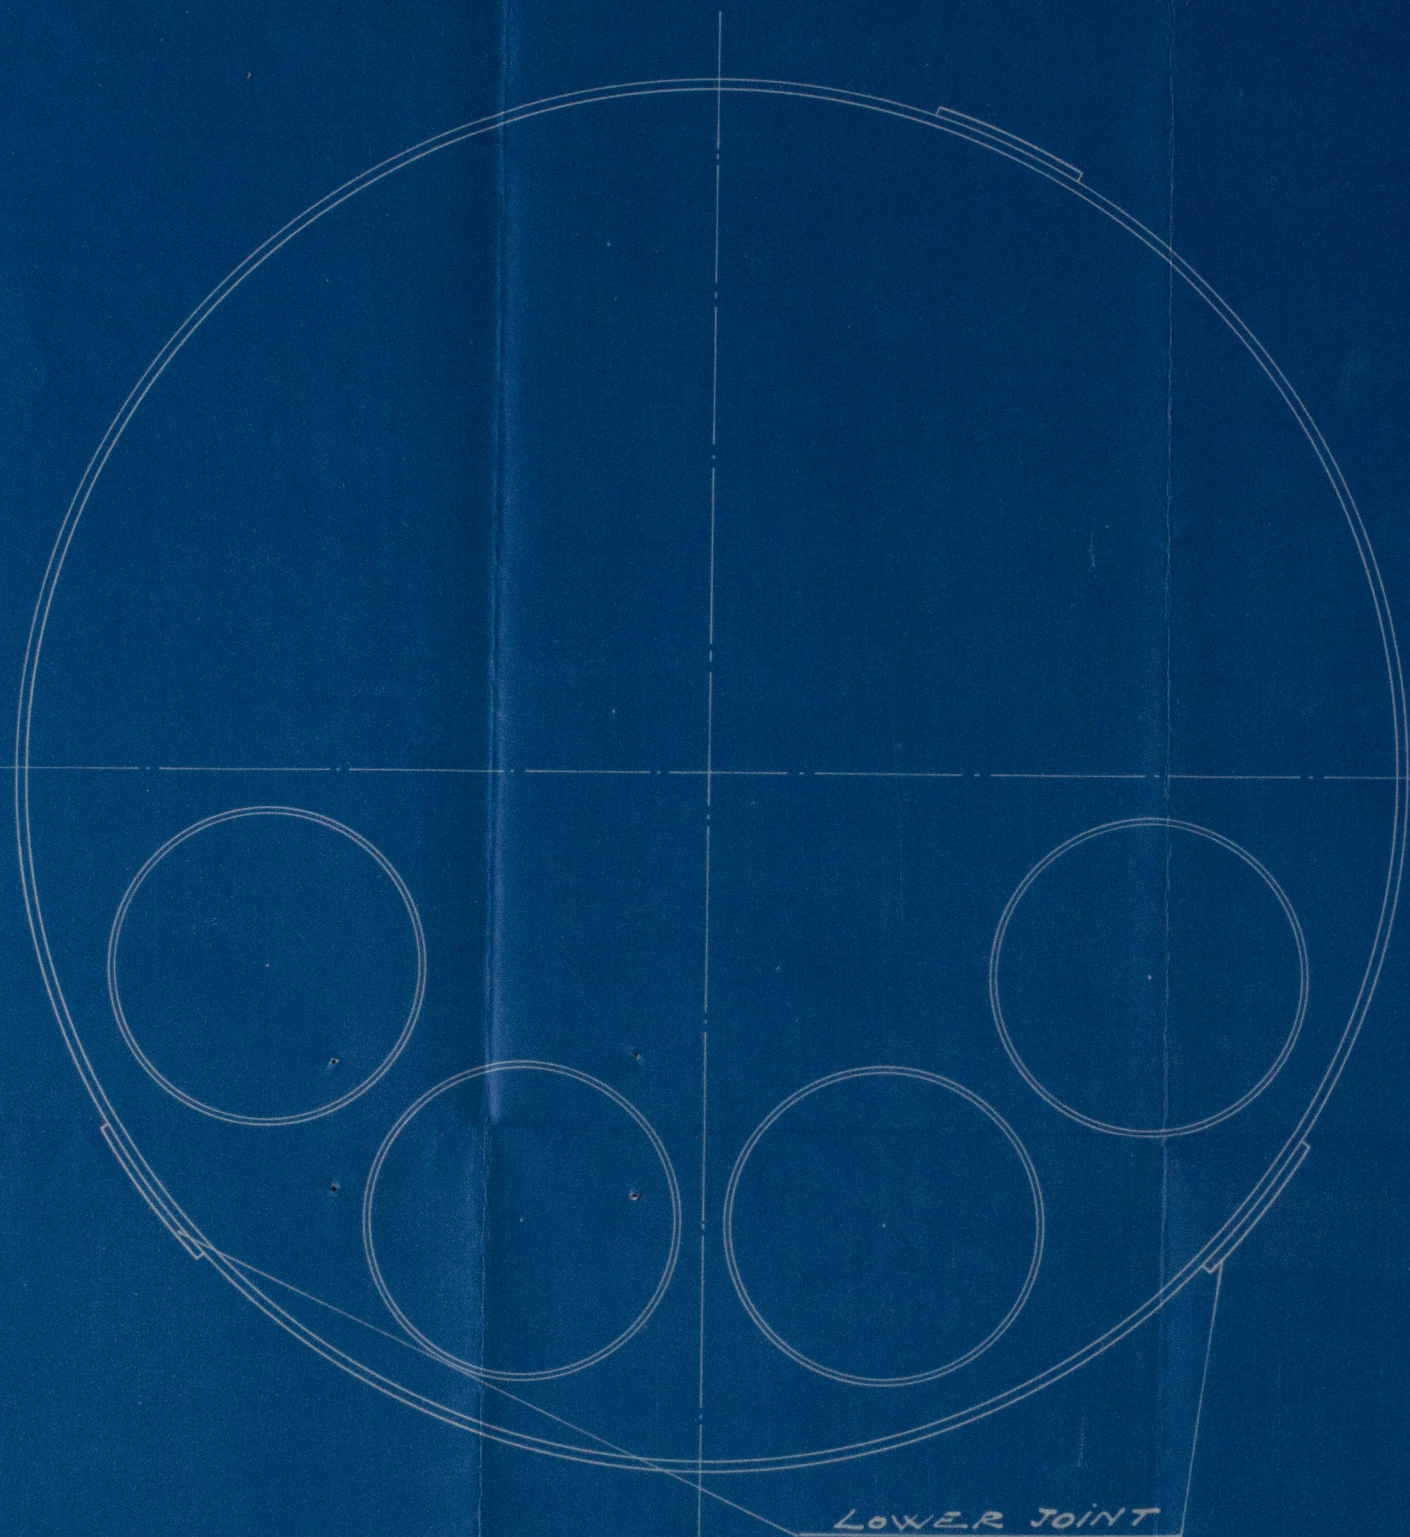

MAIN-BOILERS FOR

5/8" PETSAMO"

20-11-1931.

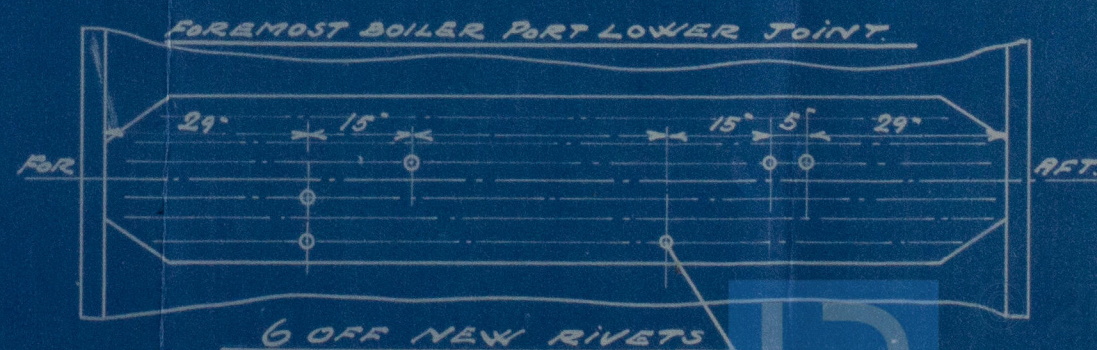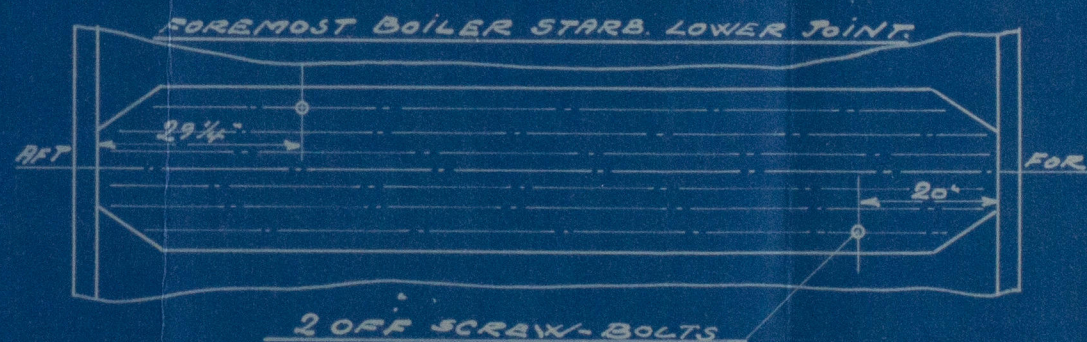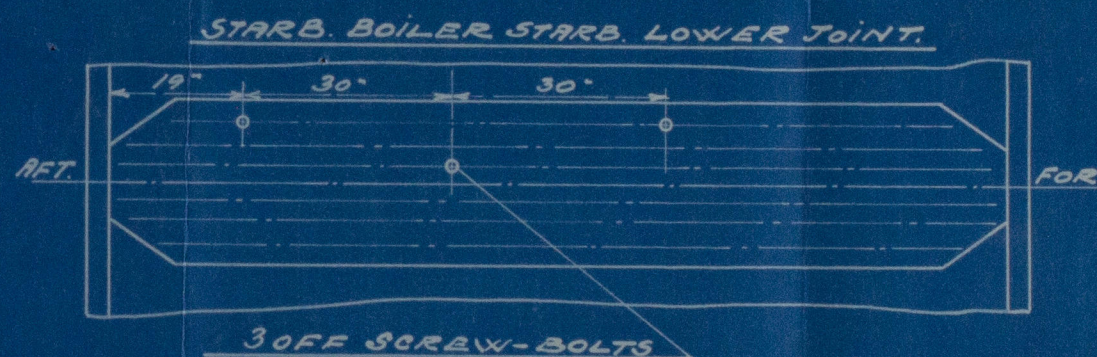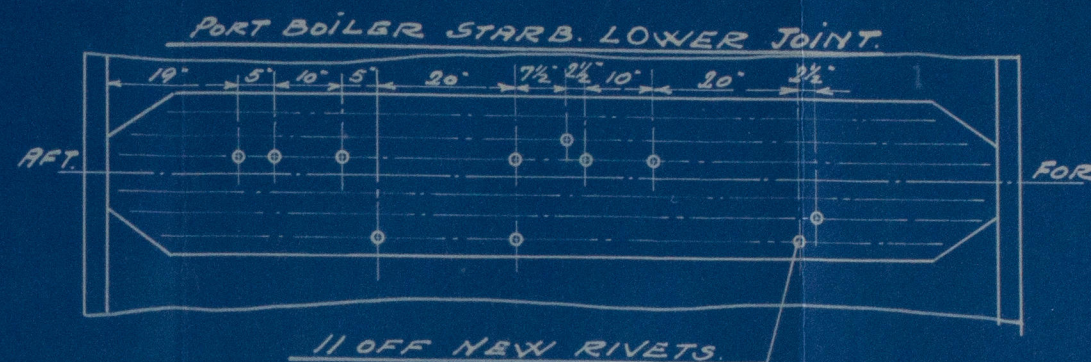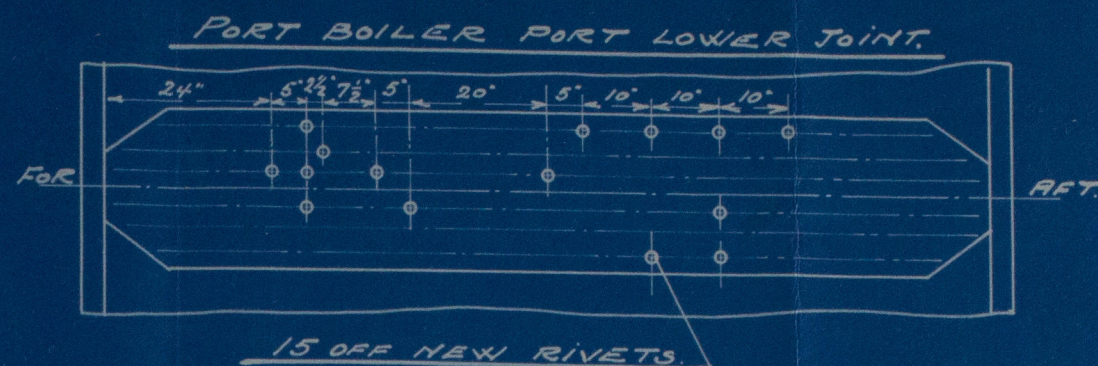

LR

W69-0194