

23 WORKING
Nº 1 R.P.H.
490-1
Copy

PROFILE & DECK PLANS



SCALE $\frac{1}{4}$ " = 1 FOOT

Beams at all decks $7 \times 10 \times 32 \times 32 \times \frac{10}{16}$
Halter and beams double from hatch coaming to ship side



See detail plan of S.P.R. Space


Moore & Co. Engineers
24-27
2577 E. 5th St.
San Francisco, Cal.

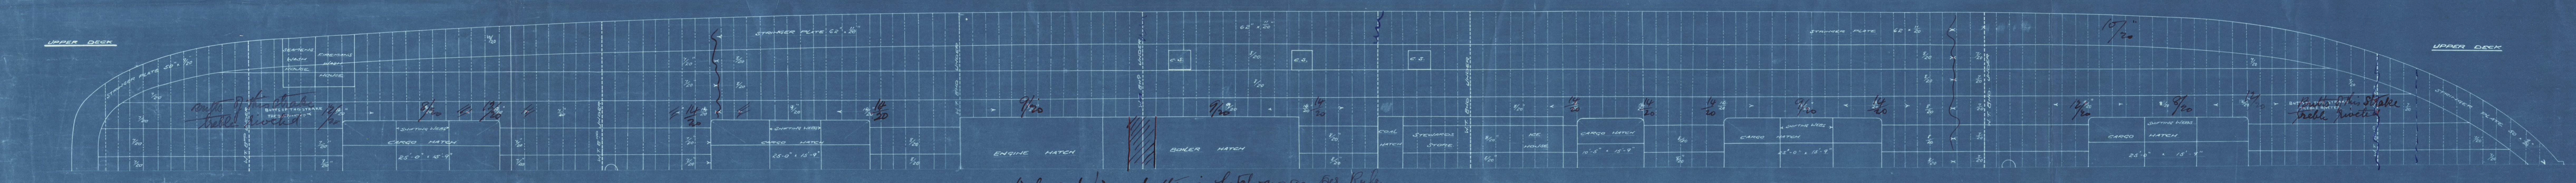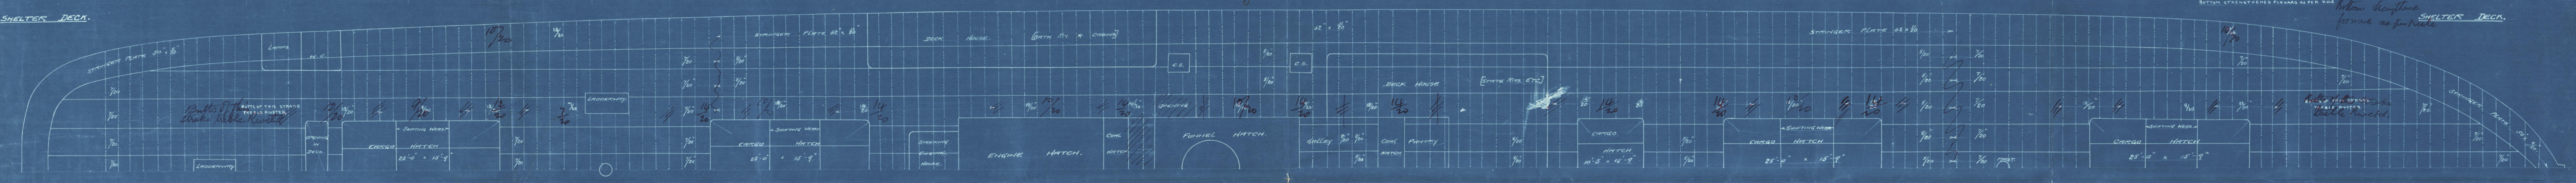

Decks and fore and afters in latitudes as per Rule



NOTE: HATCHES STRENGTHENED TO WITHSTAND APPROXIMATELY 10 TONS PER SQUARE FOOT. 

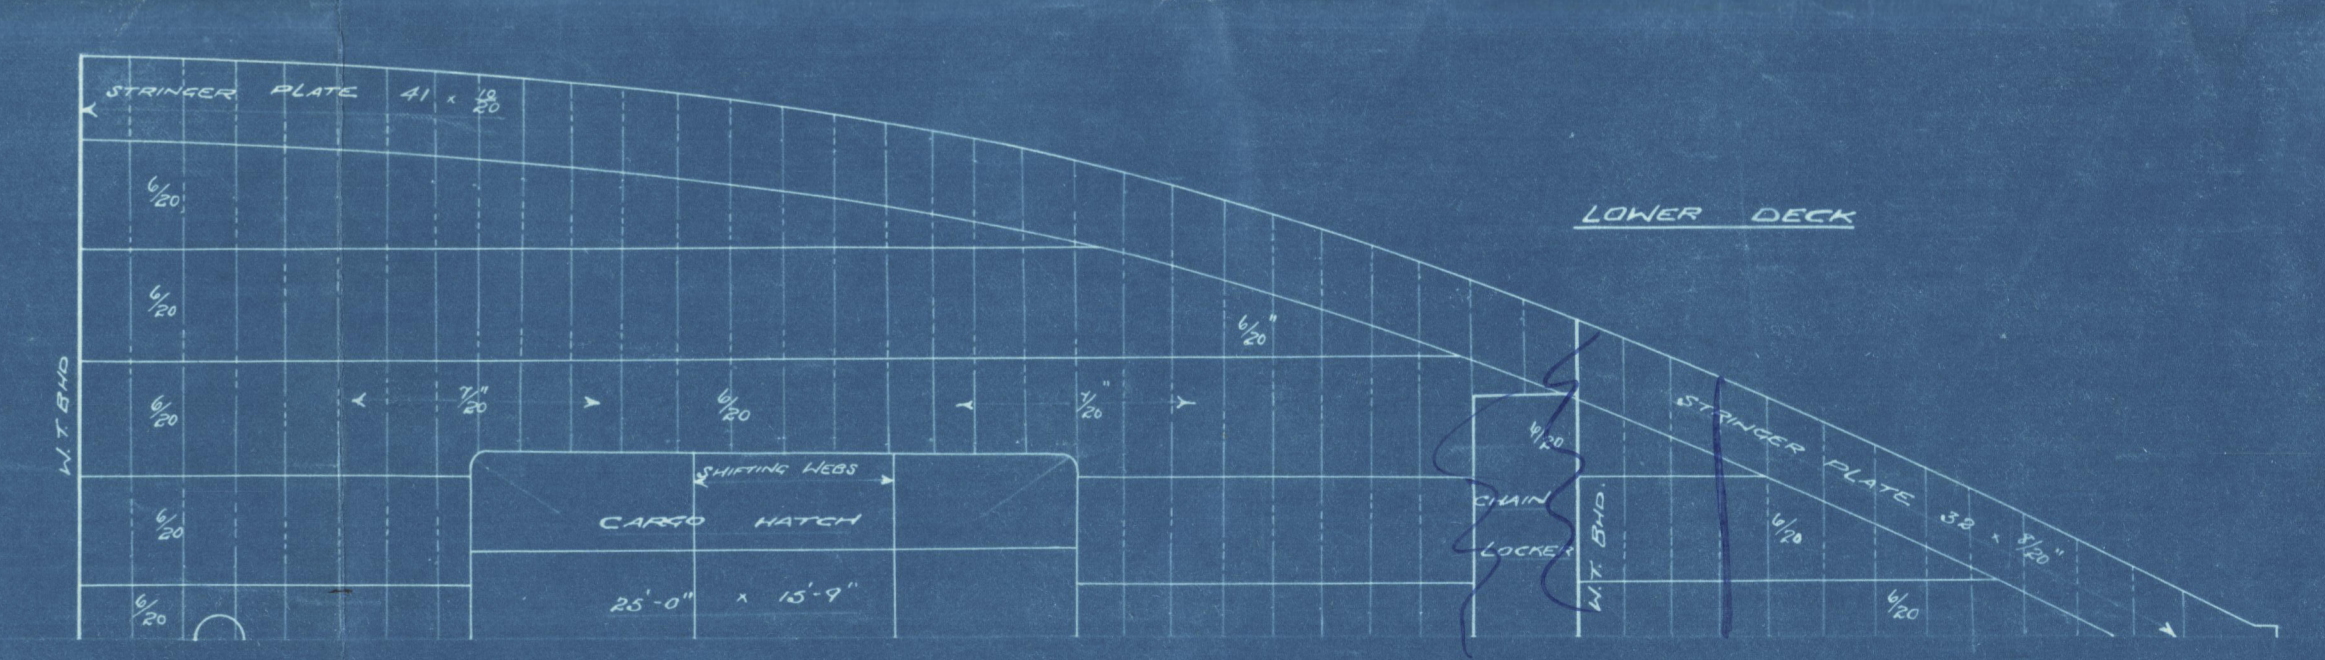


W. Machery

W69-0212

S/S Huanchaco

Profile

Glasgow Report No 25648

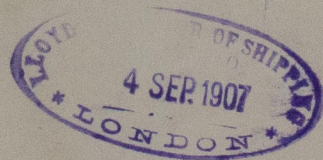

© 2020

Lloyd's Register
Foundation