

For the information of Surveyors and the Committee only.

Received at

Office

Lloyd's Register of British & Foreign Shipping.

(Report on Vessel No. _____ Port Glasgow)



The words FORGINGS or CASTINGS, IRON or STEEL, should be struck out as may be required.

No. 1621 SHIP FORGINGS ~~OR CASTINGS~~.

I have to report that the undermentioned Iron ~~or Steel~~ Forgings or ~~Castings~~, manufactured by The Dumfries Iron Coy of Dumfries for the Vessel No. 491, being built by James Wm Beardmore Esq of Dumfries have been inspected by me as set forth below and found to be, so far as can be seen, Sound


Mark on Forgings.

Lloyd's
No. 1621
AF

Alexander Fletcher
Glasgow 29/12/06

	STERN FRAME.	RUDDER FRAME.	STEM.
Material*	<u>Scrap Iron</u>		
How made	<u>Forged</u>		
Dimensions	<u>11 x 7 1/2</u>		
Progress on Inspection	<u>Forging & Smithing</u>		
Date when Inspected	<u>20/9/06 & 27/12/06</u>		

SKETCHES OF FRAMES SHOWING POSITION AND DESCRIPTION OF WELDS OF FORGINGS, OR PARTICULARS OF TESTS APPLIED TO CASTINGS.

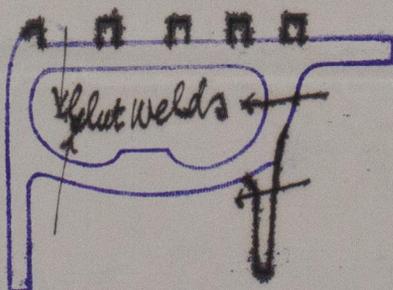

Fee (if any chargeable) £ : :

To be paid at _____



© 2020

Lloyd's Register Foundation

* If of Iron, state whether scrap or puddled Iron.

W69-0219