

29.4.12

# PROFILE.

Scale 8" = one foot.

Beams marked A. Bulbs 2 x 6 1/2  
Knees 3 1/2 x 5 1/2  
2 Angs 3 1/2 x 3 1/2 x 3 1/2  
27 x 3 1/2 or 9 1/2 x 3 1/2 x 3 1/2  
Bulb Angs.

Bridge Deck & Beams 9 x 3 1/2 x 3 1/2  
Knees 22 x 4 1/2  
7 1/2 x 3 x 4 1/2

Upper Deck Beams.  
Midship Beams Bulb Angs 9 x 3 1/2 x 3 1/2  
Knees 22 x 4 1/2  
7 1/2 x 3 x 4 1/2  
Beams in Planks " 6 1/2 x 3 x 4 1/2


7/16 Deck Beams 10 x 5 1/2  
Bulbs 2 Angs 3 1/2 x 3 1/2  
Knees 6 x 3 1/2 or 9 1/2 x 3 1/2  
Bulb Angs  
End Beams 3/4 L 9 x 4 1/2  
2 3 1/2 x 3 1/2  
or 8 1/2 x 3 x 4 1/2

Roof Deck Beams 7 1/2 x 3 x 4 1/2  
Bulb Angs Knees 22 x 4 1/2

Second Deck Beams.  
Midship Beams Bulb Angs 10 1/2 x 3 1/2 x 3 1/2  
Knees 25 x 4 1/2  
Half " 8 1/2 x 3 x 4 1/2  
Beams in Planks " 7 1/2 x 3 x 4 1/2  
" in way of Afters " 7 1/2 x 3 x 4 1/2  
" 29 x 5 1/2

Note No Hatch fore & afters fitted  
Wood covers fitted fore & aft

Deck Plating doubled at corners of  
Hatchways & Large 5" Openings

 

No 5 Second 5" Hatch.  
Webs TC Same as at No 1 Hatch.

No 4 Second 5" Hatch.  
4 Webs { 18 x 4 1/2 at Centre  
15 x 4 1/2 at Sides  
4 x 3 x 4 1/2 Double Angs top & bottom

No 4 Upper Deck Hatch.  
Webs TC Same as at No 1 Hatch

No 3 Upper Deck Hatch.  
4 Webs { 18 x 4 1/2 at Centre  
15 x 4 1/2 at Sides  
4 x 3 x 4 1/2 Double Angs top & bottom

No 3 Second 5" Hatch.  
3 Webs { 16 x 4 1/2 at Centre  
15 x 4 1/2 at Sides  
4 x 3 x 4 1/2 Double Angs top & bottom

No 2 Upper & Second 5" Hatches.  
Webs TC Same as at No 1 Hatch

No 1 Second 5" Hatch.  
5 Webs { 16 x 4 1/2 at Centre  
15 x 4 1/2 at Sides  
4 x 3 x 4 1/2 Double Angs top & bottom

Bottom strengthened forward  
as per Rules  
C.P.  
29.4.12

W. GRAY & CO. LIMITED  
WEST HARTLEPOOL



Profile.


W. Gray R. 60.

No. 511.

No. Arakan Cape Comorin

THU. NOV. - 7. 1912

Apr Report No. 14541

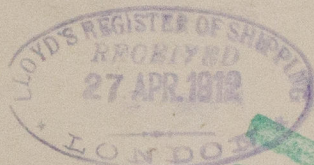

611  
18.19



© 2020

Lloyd's Register  
Foundation

W692-0044