
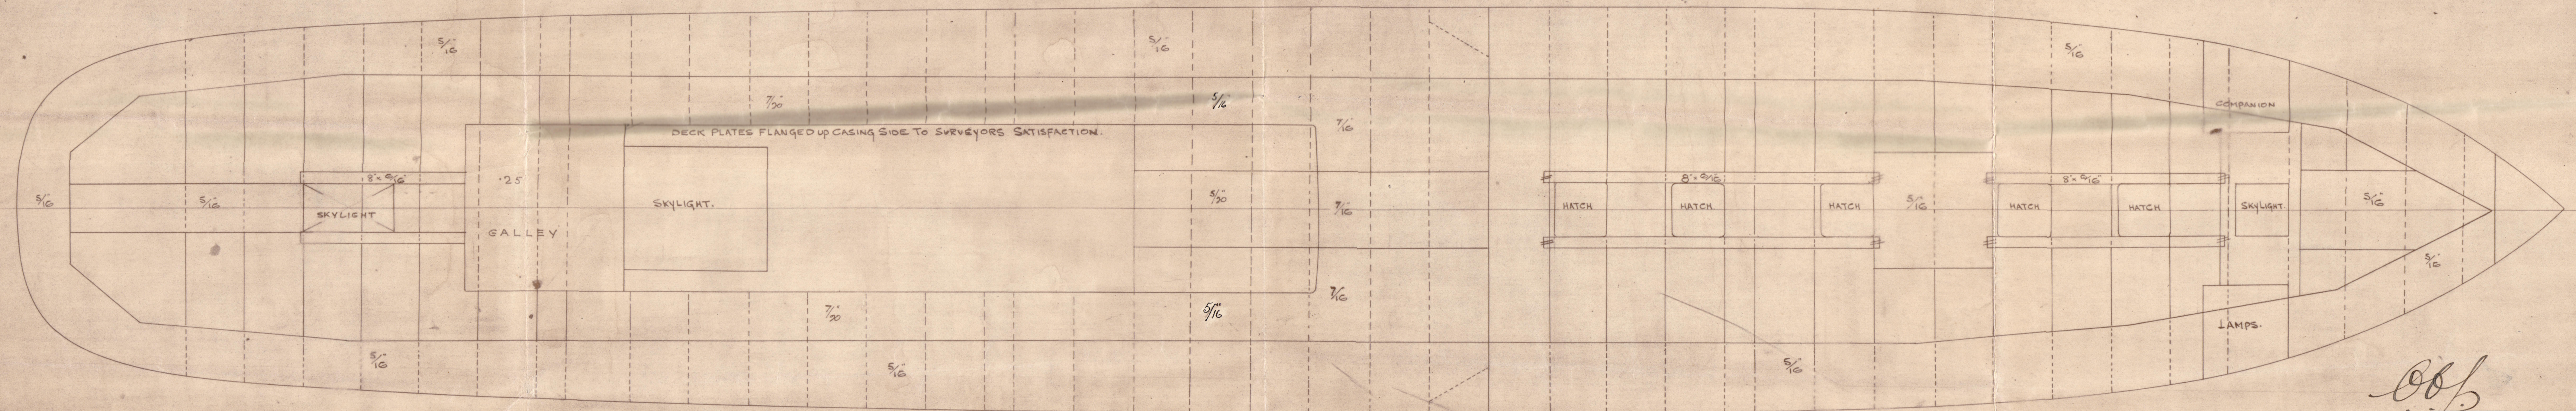


PLAN No. 3977
FOR ENCL. 8 TO
Messrs Lloyd's Surveyors
Hull FROM
COCHRANE & SONS, LTD.
SHIPBUILDERS, GLEN
DATE 18/2/44

PROFILE AND DECK PLAN

N^{os} 604-5

DIMENSIONS - 135' O.B.P. x 23' 6" EX x 13' 1" MOULDED
— SCALE 1/4" INCH —

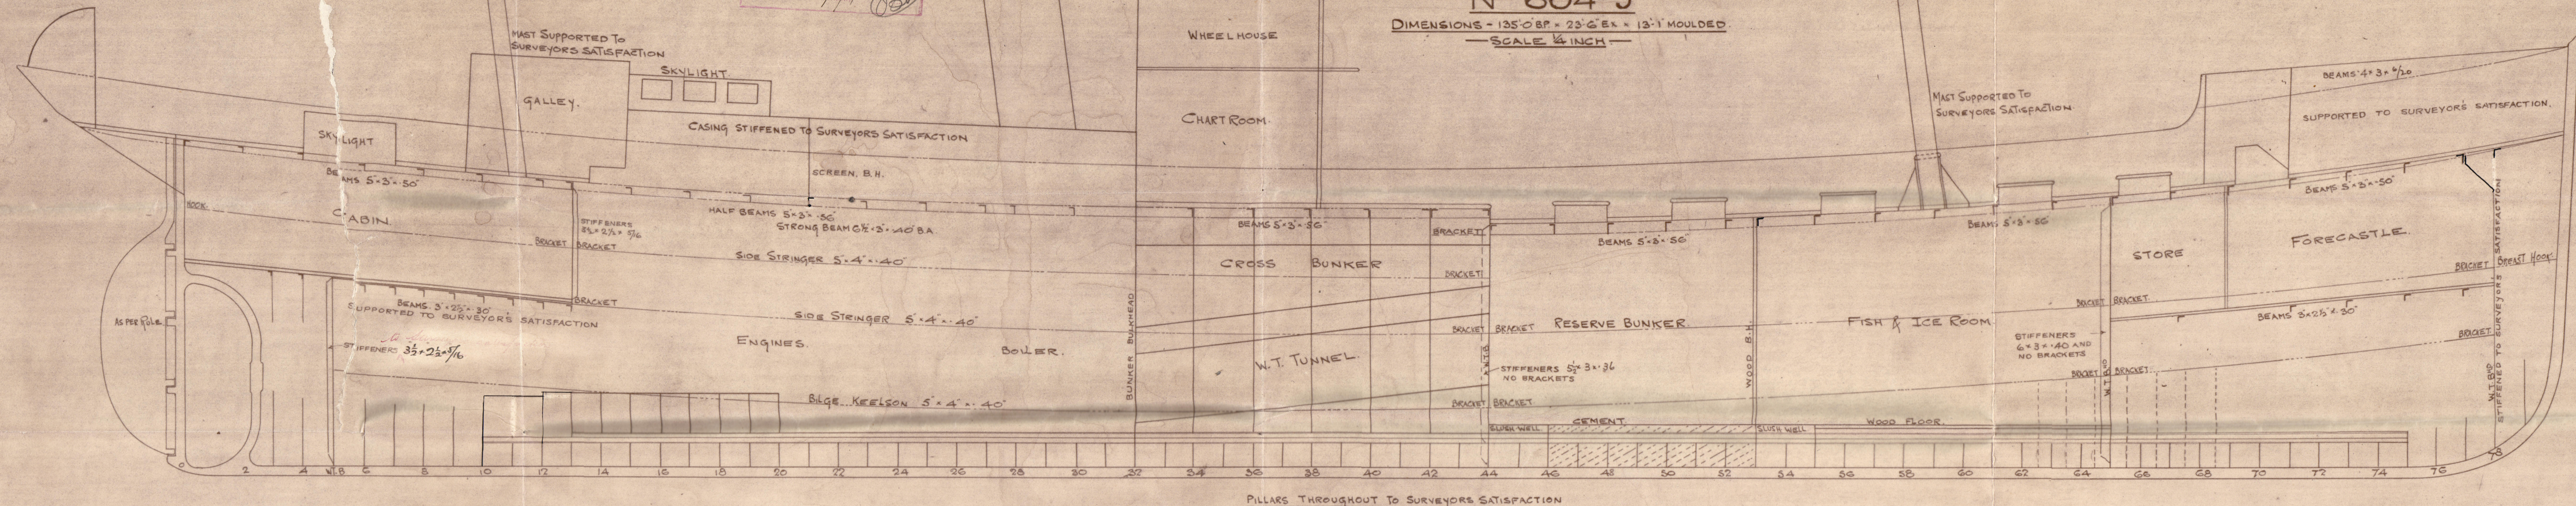

23.2.14


© 2020

Lloyd's Register
Foundation
W692-0055

Profile & Deck Plan
Cochran & Sons Ltd.

No 604 & 605

s/s Walpole Hull Rph No 27861

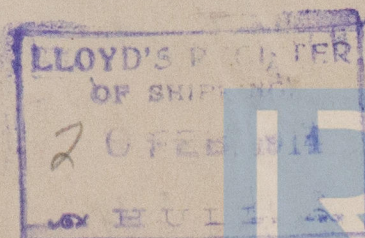

© 2020

Lloyd's Register
Foundation