

23.2.14

MIDSHIP SECTION


STEEL SCREW TRAWLERS

N^os 604-5

DIMS 135-0" B.P. x 23-6" E x 13-1" MLD
SCALE 1/2 INCH

TO CLASS 100 A.1. STEAM TRAWLER
DECK PLATED OVER IN WAY OF MACHINERY
E. & B. CASING AS PREVIOUSLY APPROVED

PLAN No. 3970
FOR ENCLOSURE TO
Messrs Lloyd's Surveyor
Hull FROM
COCHRANE & SONS, LTD.
SHIPBUILDERS, SELBY.
DATE 18/2/14

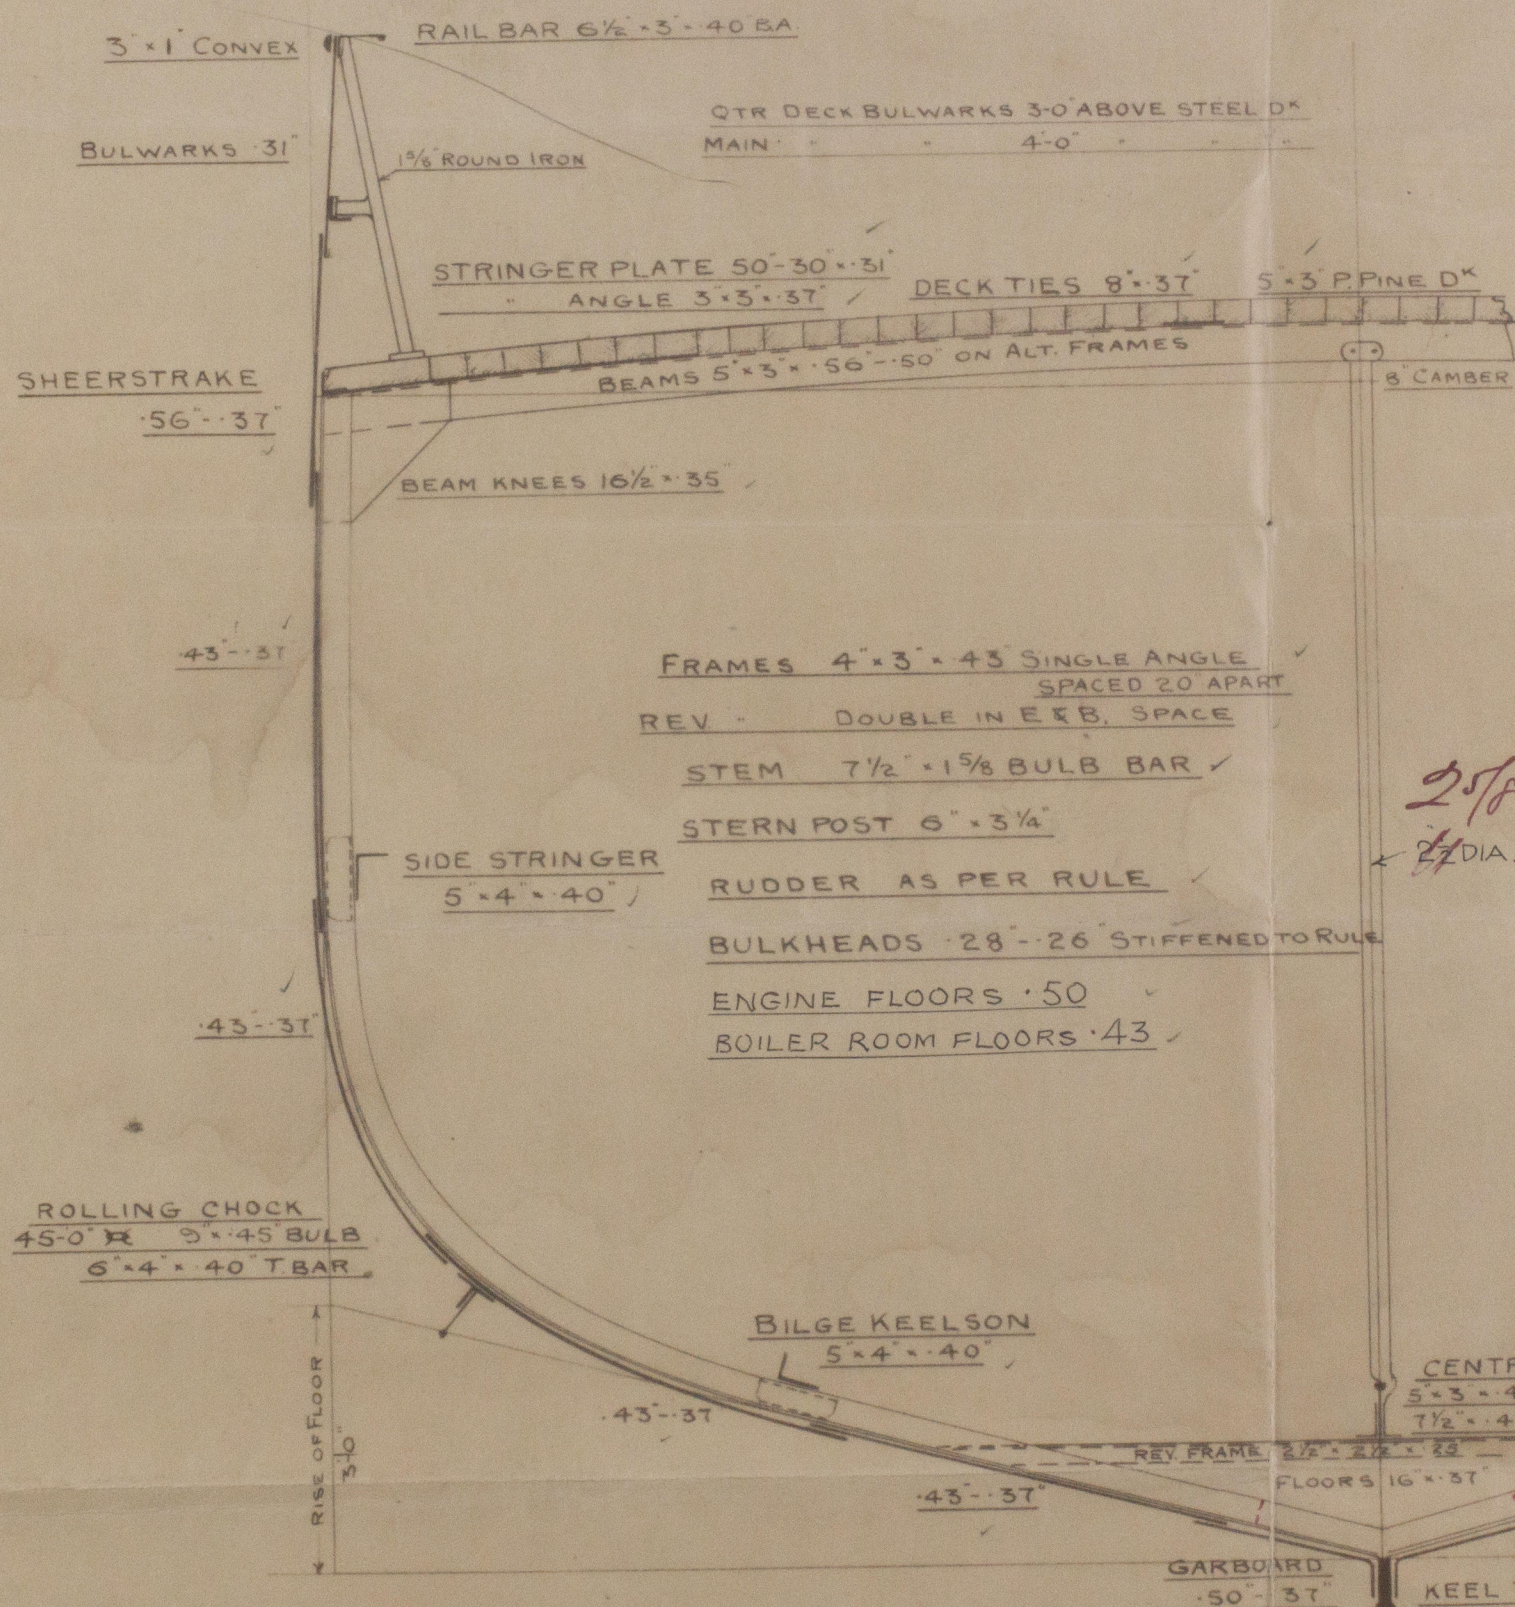

NUMERALS
B + D ----- 36.45 ✓
L x (B + D) ----- 4920.75 ✓

PROPORTIONS
L ----- 5.77 ✓
B ----- 10.32 ✓
D ----- 10.32 ✓

EQUIPMENT
✓ 1 ANCHOR 6 CWTs OR 7 1/2 CWTs STOCKLS ✓
✓ 1 " 5 1/2 " " 7 " " ✓
✓ 1 " 3 " " " " ✓
✓ 120 FATHOMS 1 1/2" STUD LINK CABLE ✓
✓ 60 " 6" HAWSER ✓
✓ 60 " 5" WARP ✓

RIVETING
✓ BUTTS OF SHELL PLATING TO BE LAPPED &
✓ DOUBLE RIVETED EXCEPT GARBOARD
✓ & SHEERSTRAKE WHICH ARE TO BE STRAPPED
✓ LANDINGS DOUBLE RIVETED BULWARKS SINGLE RIVETED.

23.2.14

13-1
1-4
11-9



Midship Section

Cochran & Sons to

- Nos 604 & 605 -

~~vs Malpala~~

Hull Report No. 27861

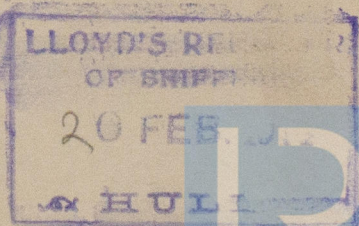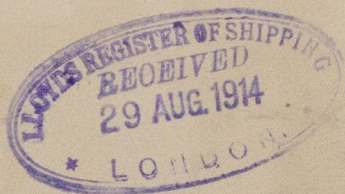

© 2020

Lloyd's Register
Foundation

W692-0056