




## 2/4/03

To pass Lloyds  
Scale 1 inch = 1 Foot

Mr. 22.4.03

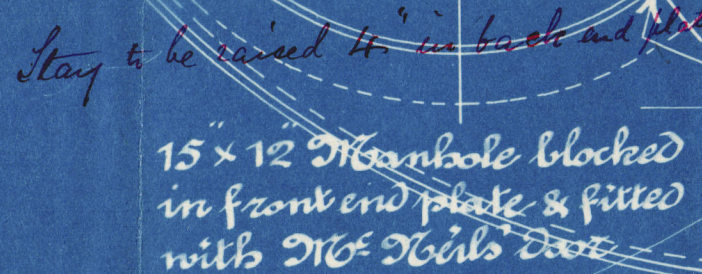

Heating Surface  
Plates  $182.92 \text{ sq ft}$   
Tubes  $541.4 \text{ sq ft}$   
Total  $724.32 \text{ sq ft}$   
Grate Bar Area  $40 \text{ sq ft}$

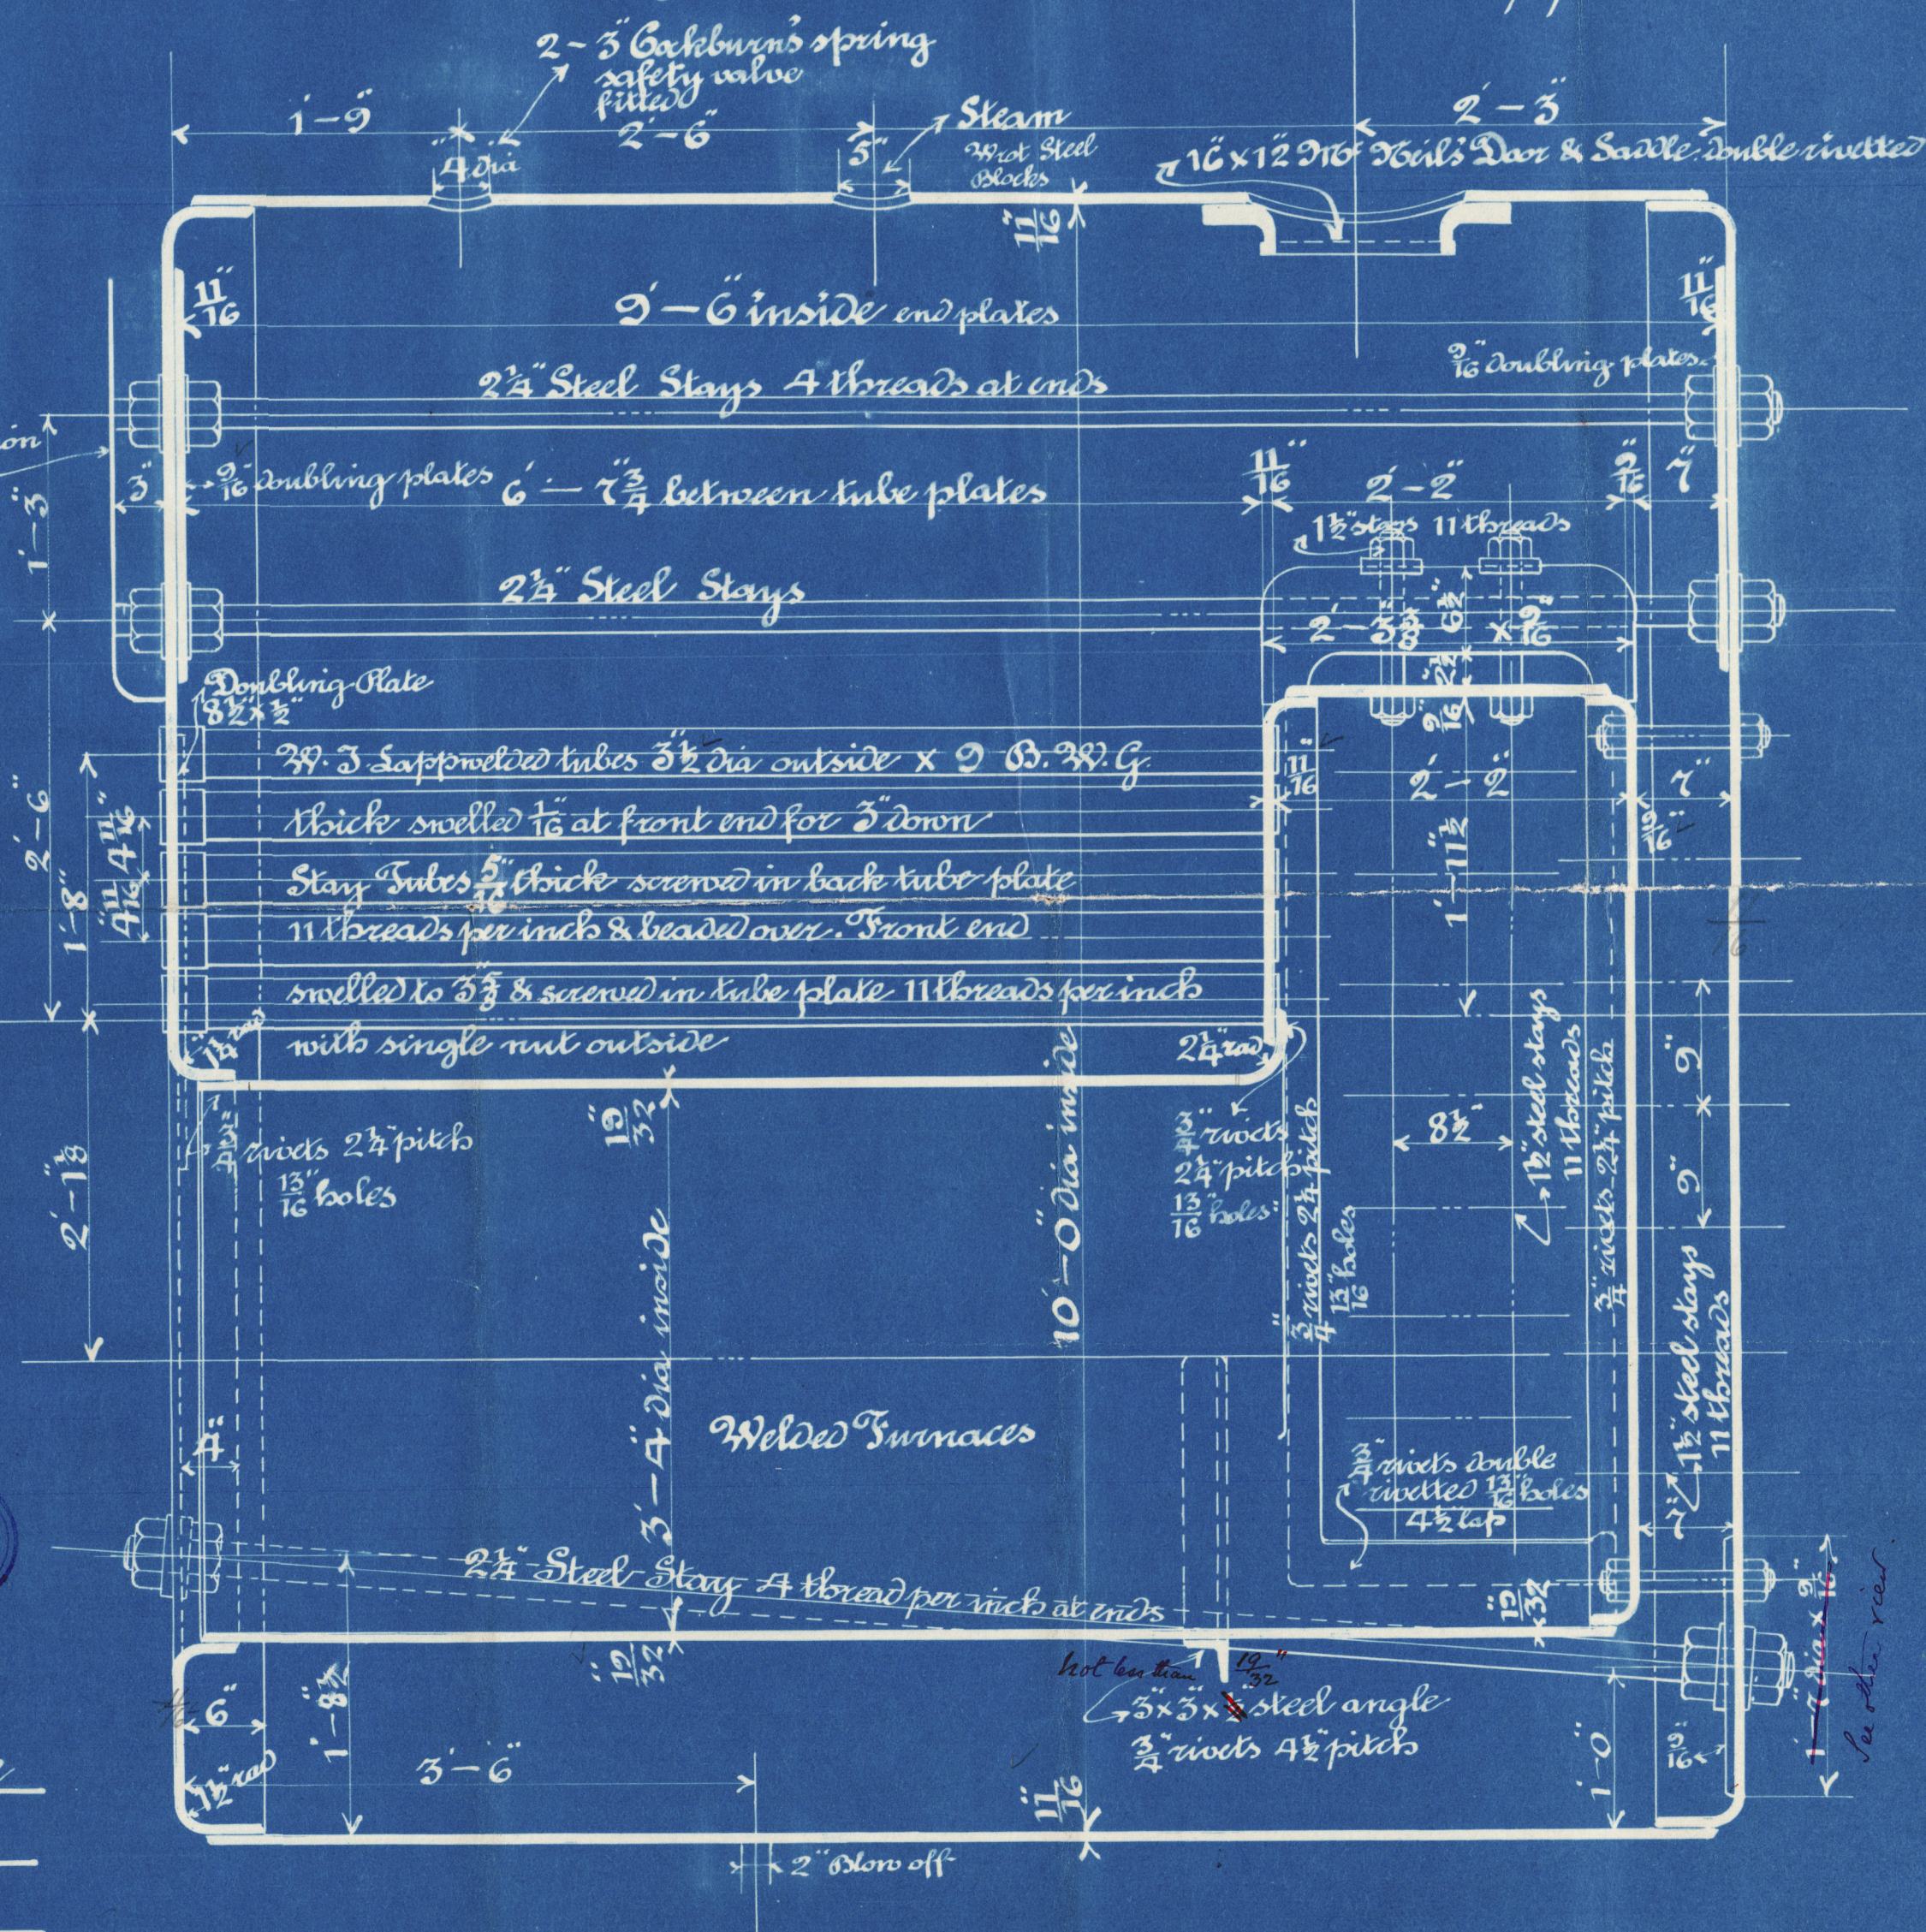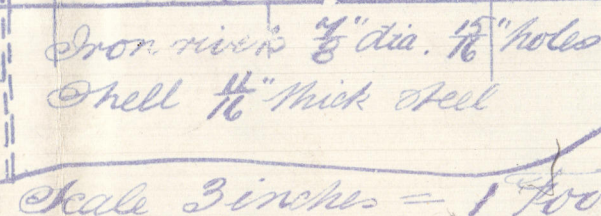

## List of Plates

1 Shell Plate in	24'-0" x 9'-3 1/4" x 11/16"	27 to 32	2-9'-3 1/2" x 15 1/4" x 1/16"	Butt	26 to 30
1 " " "	7'-9" x 9'-3 1/4" x 11/16"	" "	2-8'-11" x 15 1/4" x 1/16"		Strips
1 Front End Plate	11'-1 1/2" dia 11/16"	26 to 30	1-2'-8" x 8 1/2" x 1/2"	Water Space D.P.	
1 Back " "	11'-1 1/2" " x 11/16"	" "	20-2'-3 1/2" x 10 1/2" x 1/16"	Roof Girders	" "
2 Burnace Plates	8'-8" x 10'-9" x 1/32"	" "	<del>2-2'-7 1/2" x 2' x 1/16"</del>	Doubleing Plate - Back End	" "
Comb Box Top	2'-1" x 4'-5" x 1/16"	-2 off	" "		" "
" " Side	2'-1" x 4'-6 1/2" x 1/16"	-2 off	" "		" "
" " "	2'-1" x 6'-3" x 1/16"	-2	" "		" "
" " Back	6'-4" x 4'-8 3/4" x 1/16"	-2	" "		" "
" " Inbe (P)	4'-7" x 4'-8 3/4" x 11/16"	-2	" "		" "
Doubleing Plate	7'-4 1/2" x 2'-6 1/2" x 1/16"	-2 off			

Handwritten signature

22.4.03

Drawer D

W. J. Farwood.  
Castle Dock.  
Northwich.

27.4.03

J. D. Z. Ford  
20/4/03

Drawer 26<sup>e</sup> 7


Ends

For Ship  
No. 33

APR 8 1903



1. 1" Lonsdale  
W. J. Garwoods  
Main Boiler.  
La s/s No 33.

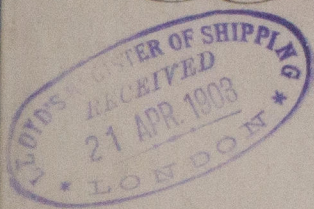

120 lb w P.

hii Rpt N. 54806

RETAIN

© 2020

Lloyd's Register  
Foundation

W692-0130